


A B C D E F G H I J K L M N O P

1
2
3
4
5
6
7
8
9

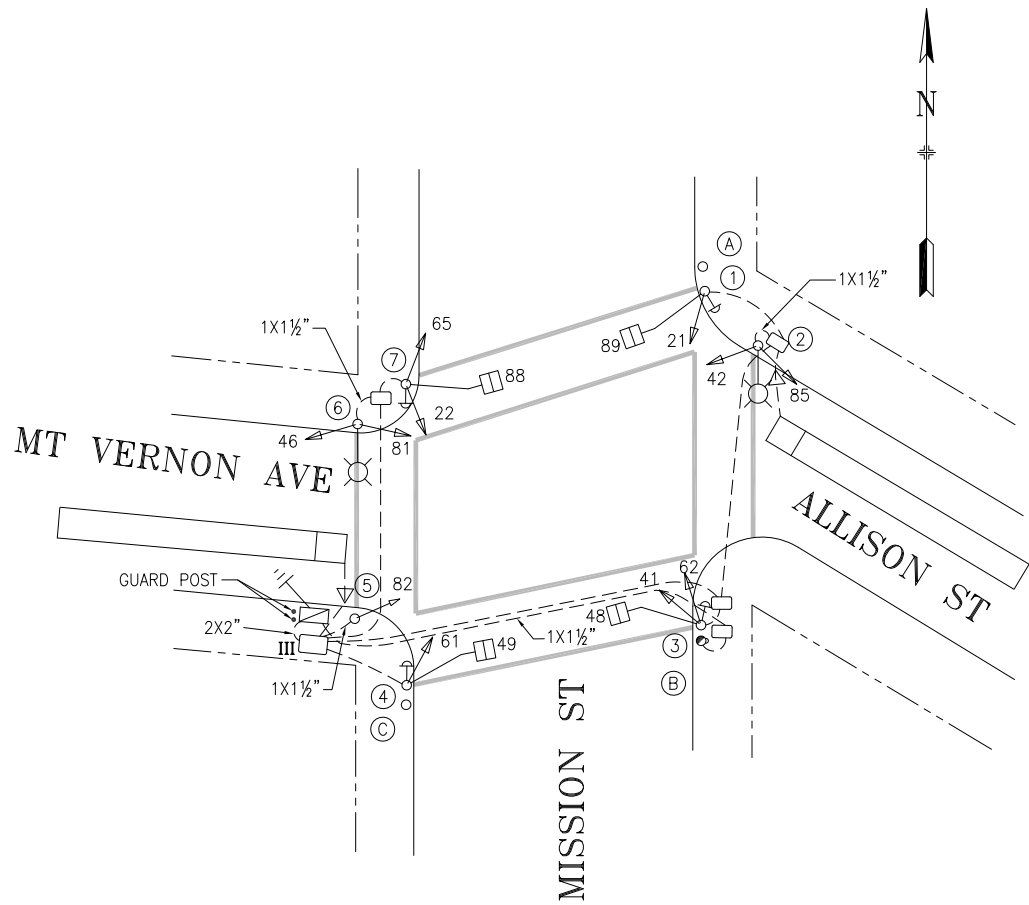

NOTE:
CABINET FOUNDATION TYPE: STD

POLE AND EQUIPMENT SCHEDULE

POLE No.	TYPE OF POLE	VEHICLE SIGNAL					PEDESTRIAN SIGNAL			REMARKS
		No.	TYPE	MOUNTING	VISORS	LOUVERS	No.	TYPE	MOUNTING	
①	1-A (10')	21	3S12"	TV-1-T	T		89	1S-IN	SP-1	PPB
②	SL	42 85	3S12" 3S12"	SV-2-TA	T T					
③	1-A (10')	41 62	3S12" 3S12"		T T		48	1S-IN	SP-1	PPB
④	1-A (10')	61	3S12"	TV-1-T	T		49	1S-IN	SP-1	PPB
⑤	Utility	82	3S8"	SV-1-T	T					① E-2
⑥	SL	46 81	3S12" 3S12"	SV-2-TA	T T					
⑦	1-A (10')	22 65	3S12" 3S12"	TV-2-T	T T		88	1S-IN	SP-1	PPB
⑧	Utility									
⑨	Utility									
⑩	Utility									



No.	DATE	DESCRIPTION	BY	APP.
3	1/29/18	21,22,61,42,81,85 TO 12" ADDED 46, 65 PER 2017-186	JRS	BW
2	3/5/17	CHANGED HEADS 41, 62 TO 3S12"	ET	RO
1	1/97	NEW TRAFFIC SIGNALS CT48	CXL	DVS
TABLE OF REVISIONS				
CHECK WITH TRACING TO SEE IF YOU HAVE LATEST REVISION				

REFERENCE INFORMATION
& FILE NO. OF SURVEYS



SAN FRANCISCO MUNICIPAL TRANSPORTATION AGENCY
CITY AND COUNTY OF SAN FRANCISCO

XX --/--
DRAWN: DATE:
CXL 8/2/99
CHECKED: DATE:
XX --/--

SCALE:

1" = 40'

SHEET OF SHEETS

1 OF 1

TRAFFIC SIGNAL INVENTORY DIAGRAM

ALLISTON ST, MISSION ST & MT. VERNON AVE

CNN NO.

21489000

REV NO.