


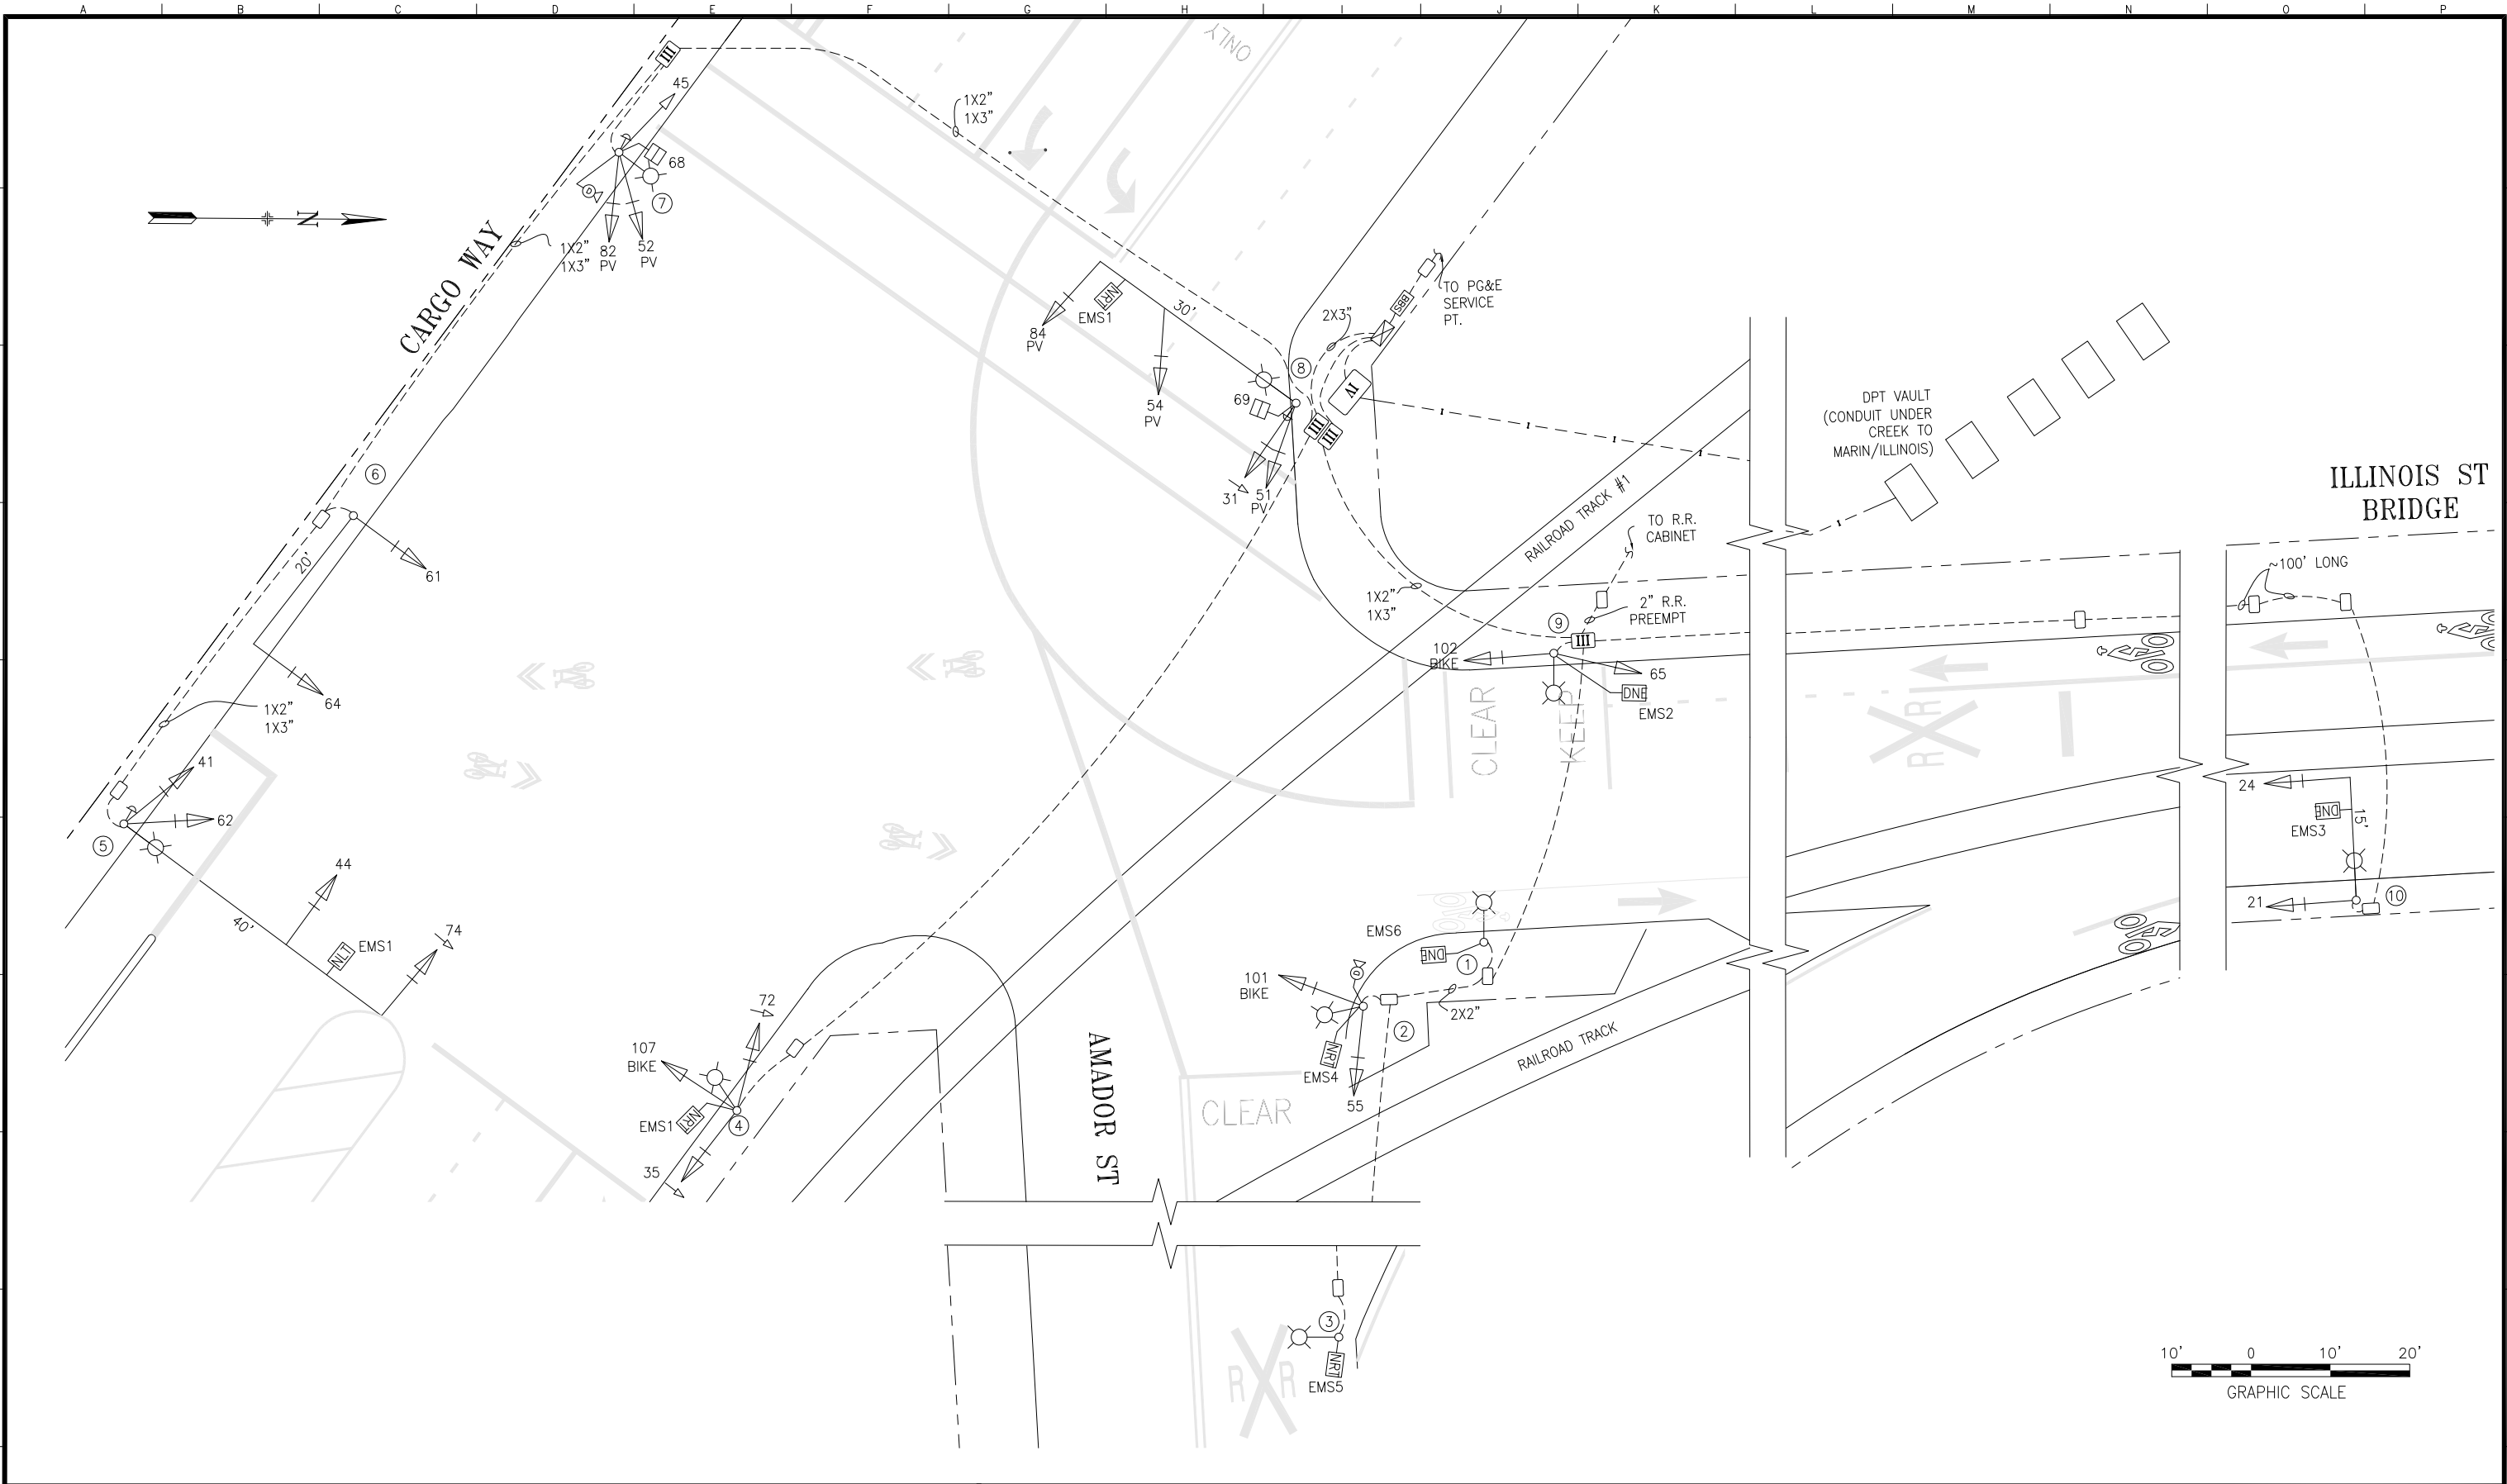

4	10/14/22	SRC 2022-248. CHANGE SIGNAL 35 FROM 3S12" TO 3S12"RA	D Yeung	G de Leon
3	9/22/22	REPLACE EX VIDEO DETECTION WITH NEW VIDEO DETECTION UNITS ON POLES 2 & 7	D Yeung	G de Leon
2	9/20/22	UPDATE PER FIELD. 65 IS 3S12" & NO BP. RELABEL 81/85 AS 31/35. 31 IS NOT PV. 35 IS 3S12" LABEL EMS PER TIMING CARD	D Yeung	G de Leon
1	8/2/12	ADDED BICYCLE SIGNALS AND DETECTION FOR NORTHBOUND CARGO WAY CYCLETRACK	J Shahamiri	D Curtis
0	7/16/08	ILLINOIS ST BRIDGE PROJECT	D Yeung	A Herce
NO.	DATE	DESCRIPTION	BY	APPROVED
TABLE OF REVISIONS				
CHECKOUT DRAWING THROUGH THE SID CUSTODIAN FOR THE LATEST REVISION				



SFMTA

DRAWN BY:
DYeung/DPadilla

DATE:
7/23/08

CHECKED BY:
AHerce

DATE:
7/23/08

SCALE
1" = 10'

SHEET OF SHEETS
1 OF 2

TRAFFIC SIGNAL INVENTORY DIAGRAM

AMADOR, CARGO, ILLINOIS INTERSECTION

CNN NO:
54159000

REV NO:
4

