


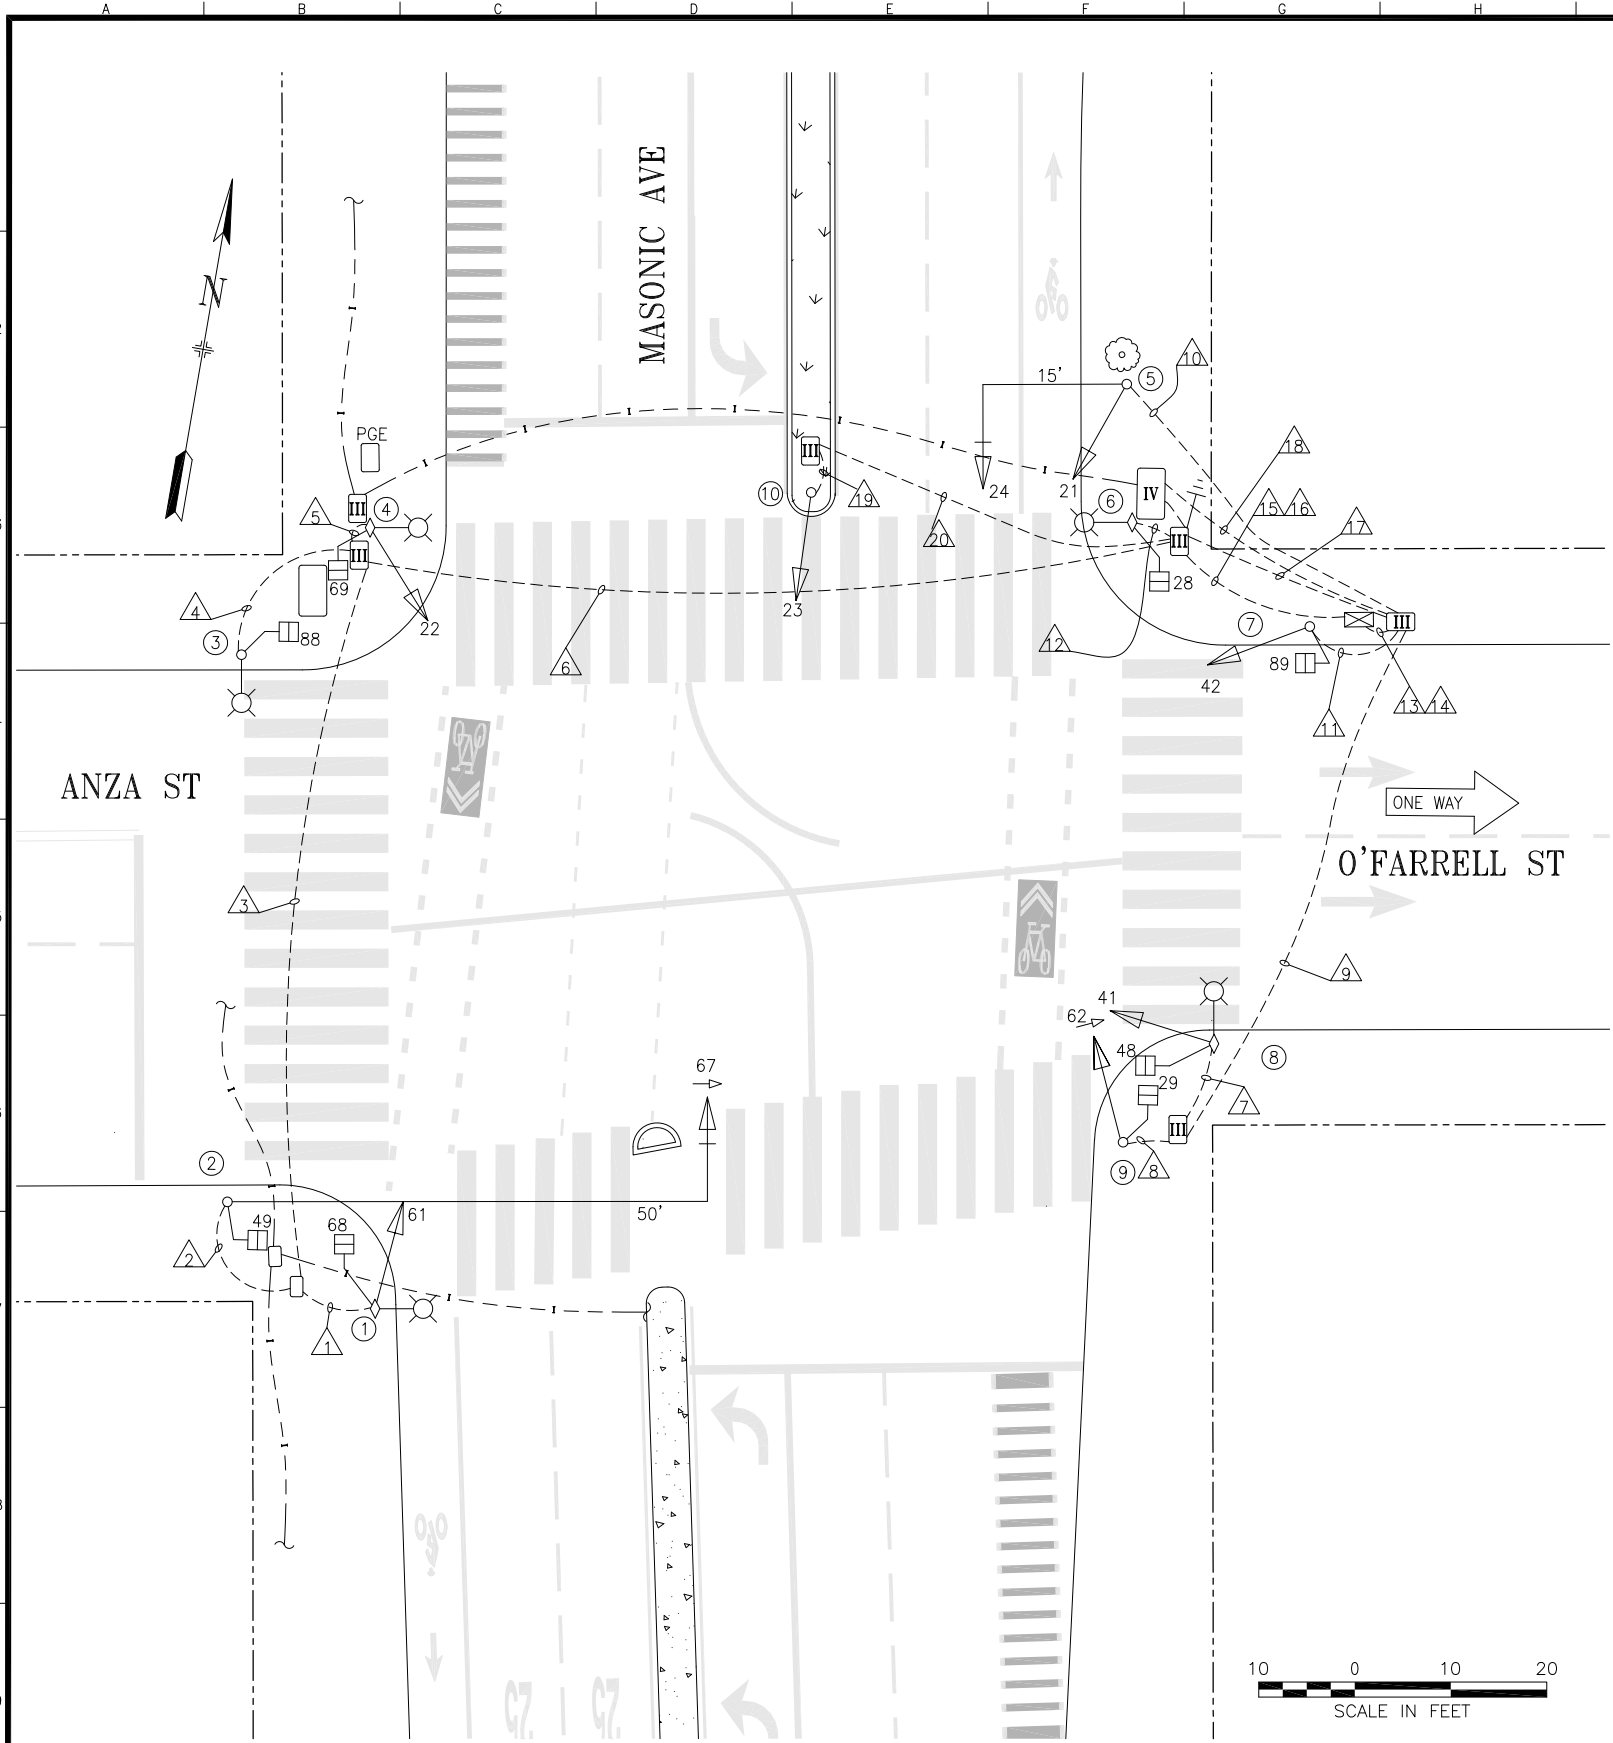

POLE AND EQUIPMENT SCHEDULE												
	POLE No.	TYPE OF POLE	LUMINAIRE VOLTAGE/ WATTAGE	VEHICLE SIGNAL					PEDESTRIAN SIGNAL			REMARKS
				No.	TYPE	MOUNTING	VISORS	LOUVERS/BP	No.	TYPE	MOUNTING	
①		MUNI POLE W/ SL		61	3S12"	SV-1-T	T		68	1S-COUNT	SP-1	
②		28-5-100 W/ 50' MAST ARM		67	5S12"YGLA	MAS	T	BP	49	1S-COUNT	SP-1	
③		MARBLELITE SL							88	1S-COUNT	SP-1	
④		MUNI POLE W/ STREET LIGHT		22	3S12"	SV-1-T	T		69	1S-COUNT	SP-1	
⑤		16-1-100 W/ 15' MAST ARM		24 21	3S12" 3S12"	MAS SV-1-T (36")	T T	BP				
⑥		MUNI POLE W/ STREET LIGHT							28	1S-COUNT	SP-1	
⑦		1-A (10')		42	3S12"	TV-1-T	T		89	1S-COUNT	SP-1	
⑧		MUNI POLE W/ SL		41	3S12"	SV-1-T	T		48	1S-COUNT	SP-1	
⑨		1-A (10')		62	5S12"YGLA	TV-1-T	T		29	1S-COUNT	SP-1	
⑩		1-A (15')		23	3S12"	SV-1-T	T					

2	1/31/23	RELOCATE SIGNAL 21 TO POLE 5 PER SRC 2023-016	CLeung	MVelasco	
1	4/18/18	ADD NEW POLE 10 AND SIGNAL 23 & NO BP FOR 62 (PER 2370J CONTRACT PLANS)	DYeung	G de Leon	
0	6/26/14	UPGRADE ACTIVATED THRU 2108J; CONVERTED FROM CONTRACT PLANS	JHornbostel	MVelasco	
NO.	DATE	DESCRIPTION	BY	APPROVED	
TABLE OF REVISIONS					
CHECKOUT DRAWING THROUGH THE SID CUSTODIAN FOR THE LATEST REVISION					



DRAWN BY:
JHornbostel

DATE:
09/2015

CHECKED BY:
MVelasco

DATE:
09/2015

SCALE

AS SHOWN

SHEET OF SHEETS
1 of 2

TRAFFIC SIGNAL INVENTORY DIAGRAM

ANZA ST, MASONIC AVE AND O'FARRELL ST

CNN NO:
26400000

REV NO:
2

[illegible]

							CNN NO: 26400000
2	1/31/23	RELOCATE SIGNAL 21 TO POLE 5 PER SRC 2023-016	CLeung	MVelasco	DRAWN BY:	DATE:	NONE SHEET OF SHEETS 2 OF 2
1	4/18/18	ADD NEW POLE 10 AND SIGNAL 23 & NO BP FOR 62 (PER 2370J CONTRACT PLANS)	DYeung	G de Leon	DYeung	07/2022	
0	6/26/14	UPGRADE ACTIVATED THRU 210B&; CONVERTED FROM CONTRACT PLANS	JHornbostel	MVelasco	CHECKED BY:	DATE:	TRAFFIC SIGNAL INVENTORY DIAGRAM ANZA ST, MASONIC AVE AND O'FARRELL ST CONDUIT AND WIRING SCHEDULE
NO.	DATE	DESCRIPTION	BY	APPROVED	GdeLeon	07/2022	
TABLE OF REVISIONS CHECKOUT DRAWING THROUGH THE SID CUSTODIAN FOR THE LATEST REVISION							