


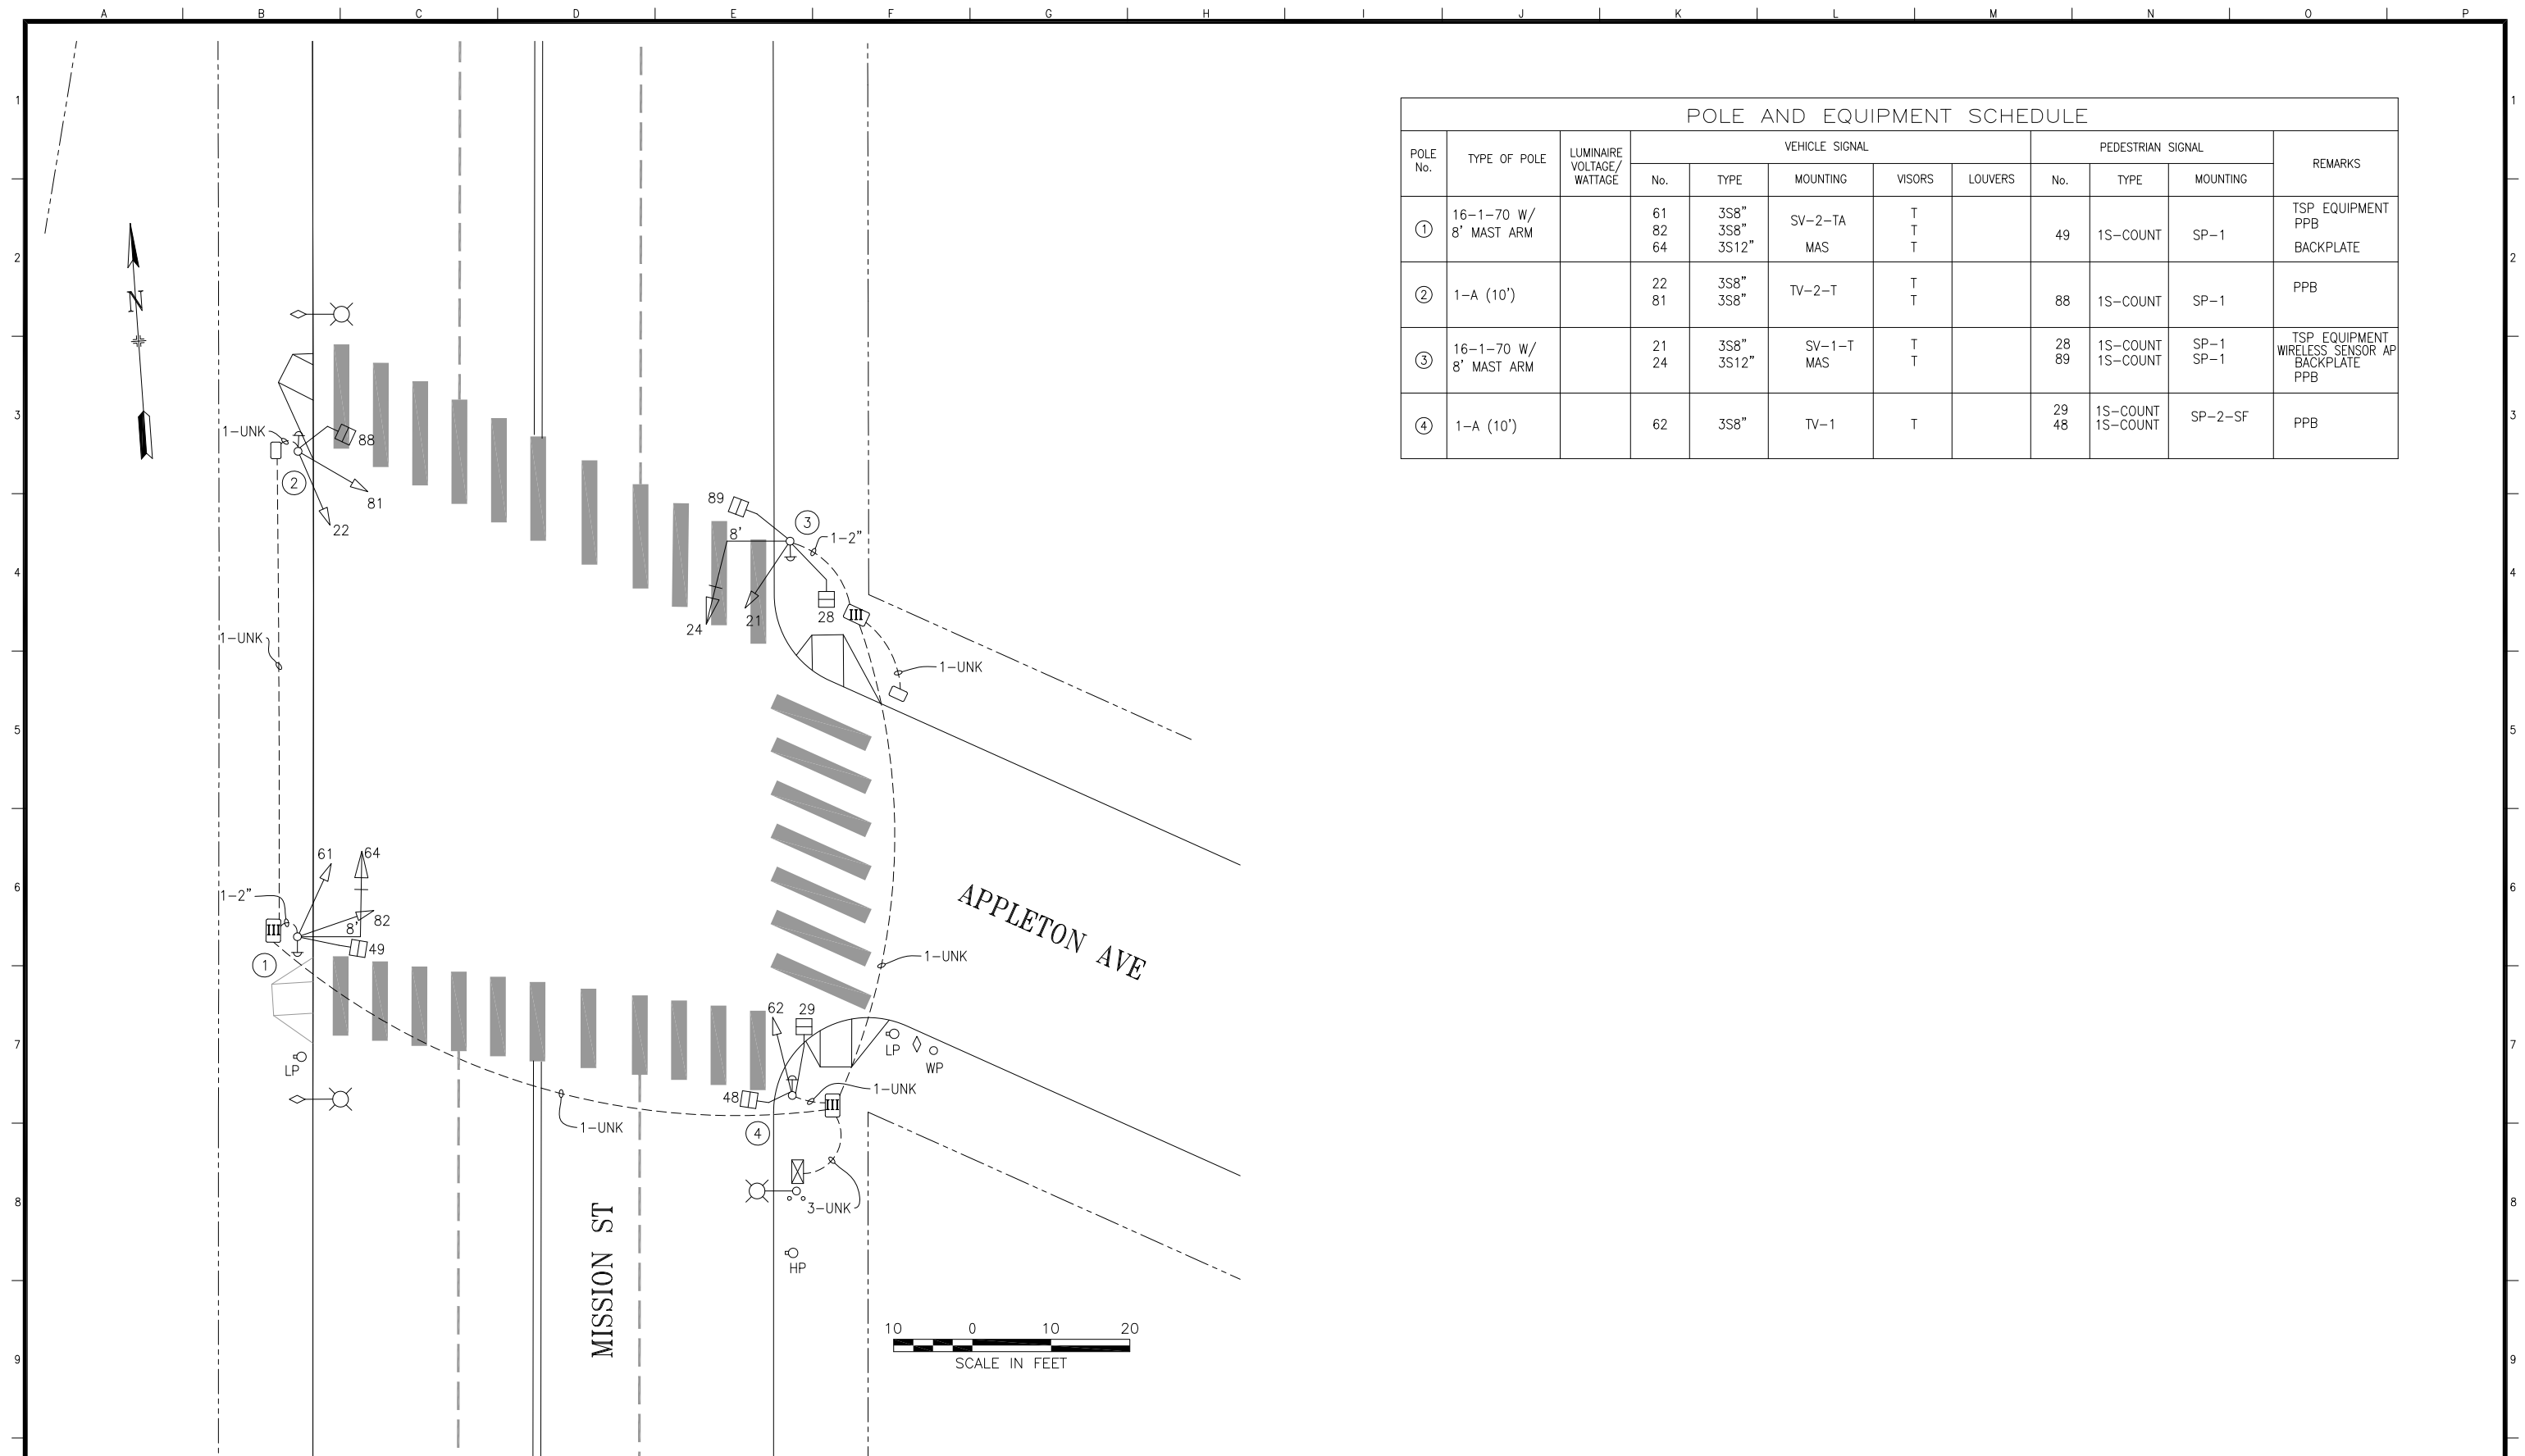

POLE AND EQUIPMENT SCHEDULE											
POLE No.	TYPE OF POLE	LUMINAIRE VOLTAGE/WATTAGE	VEHICLE SIGNAL					PEDESTRIAN SIGNAL			REMARKS
			No.	TYPE	MOUNTING	VISORS	LOUVERS	No.	TYPE	MOUNTING	
①	16-1-70 W/ 8' MAST ARM		61 82 64	3S8" 3S8" 3S12"	SV-2-TA MAS	T T T		49	1S-COUNT	SP-1	TSP EQUIPMENT PPB BACKPLATE
②	1-A (10')		22 81	3S8" 3S8"	TV-2-T	T T		88	1S-COUNT	SP-1	PPB
③	16-1-70 W/ 8' MAST ARM		21 24	3S8" 3S12"	SV-1-T MAS	T T		28 89	1S-COUNT 1S-COUNT	SP-1 SP-1	TSP EQUIPMENT WIRELESS SENSOR AP BACKPLATE PPB
④	1-A (10')		62	3S8"	TV-1	T		29 48	1S-COUNT 1S-COUNT	SP-2-SF	PPB

1	4/19/17	PED SIGNALS XING APPLETON VIA SRC 2016-317			ASCALESDLEON
0	11/30/99	UPGRADE ACTIVATED THRU 1389N-CONVERTED FROM AS BUILT	SACALESDLEON		
NO.	DATE	DESCRIPTION		BY	APP.

REFERENCE INFORMATION
& FILE NO. OF SURVEYS



SAN FRANCISCO MUNICIPAL TRANSPORTATION AGENCY
CITY AND COUNTY OF SAN FRANCISCO

		SCALE:		CNN NO.
DRAWN: DATE:		AS SHOWN	TRAFFIC SIGNAL INVENTORY DIAGRAM	21835000
AScales 7/14/17		SHEET OF SHEETS		REV NO.
CHECKED: DATE:		1 OF 1	APPLETON AVENUE AND MISSION STREET	
GDeLeon 7/17/17				1