


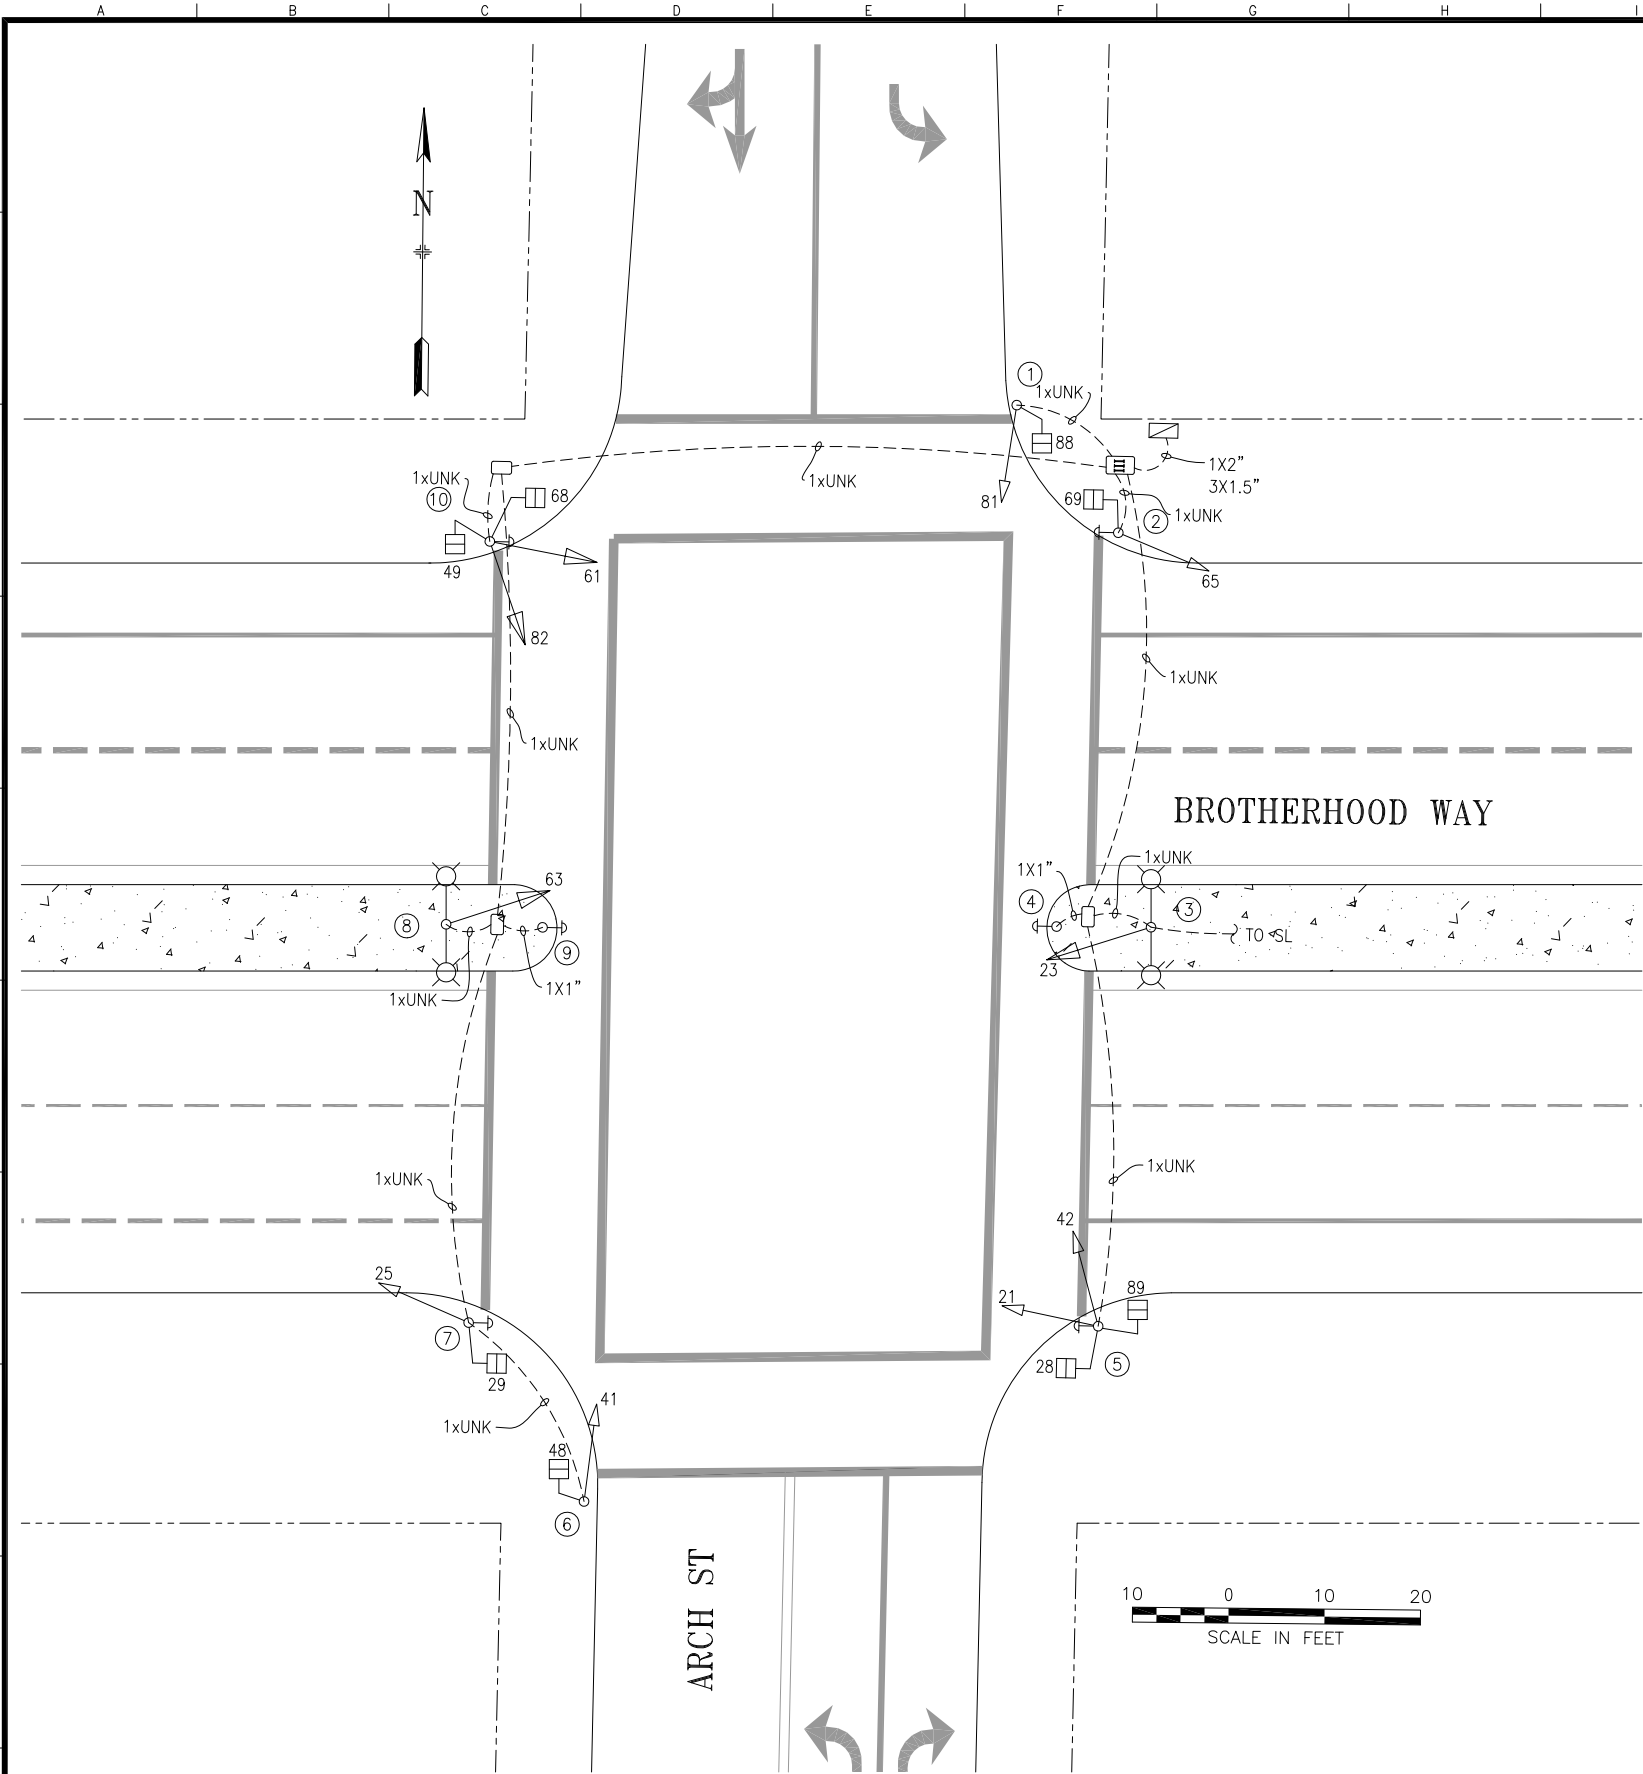

POLE AND EQUIPMENT SCHEDULE											
POLE No.	TYPE OF POLE	LUMINAIRE VOLTAGE/ WATTAGE	VEHICLE SIGNAL					PEDESTRIAN SIGNAL			REMARKS
			No.	TYPE	MOUNTING	VISORS	LOUVERS	No.	TYPE	MOUNTING	
①	EXISTING 10' MARBELITE POLE		81	3S8"FY	TV-1	T		88	1S-COUNT	SP-1	
②	EXISTING 10' MARBELITE POLE		65	3S8"	TV-1	T		69	1S-COUNT	SP-1	PPB
③	EX. MARBELITE STREET LIGHT W/ DUAL 6' LA		23	3S12"	SV-1-T	T					EXTERNAL CONDUIT
④	PPB POLE										PPB
⑤	EXISTING 10' MARBELITE POLE		21 42	3S8" 3S8"	TV-2-T-SFA	T T		28 89	1S-COUNT 1S-COUNT	SP-1 (22") SP-1-SF	PPB
⑥	1-B (10')		41	3S8"	TV-1	T		48	1S-COUNT	SP-1	
⑦	EXISTING 10' MARBELITE POLE		25	3S8"	TV-1	T		29	1S-COUNT	SP-1	PPB
⑧	EX. MARBELITE STREET LIGHT W/ DUAL 6' LA		63	3S12"	SV-1-T	T					EXTERNAL CONDUIT
⑨	PPB POLE										PPB
⑩	1-A (10')		61 82	3S12" 3S12"FY	TV-2-T-SFA	T T		49 68	1S-COUNT 1S-COUNT	SP-1-SF SP-1 (22")	PPB

NO.	DATE	DESCRIPTION	BY	APP.
2	7/12/16	ADD. PED. SIGNALS XING ARCH AND SWAP 22&62 FOR 65&25 PER SRC 2015-411; 61 & 82 UPGRADED TO 3S12" PER FIELD	A.Scales	M.Velasco
1	3/7/10	UPGRADE SIGNALS 23&63 TO 12" PER SRC 2009-273.	R.Olea	R.Olea
0	11/1/01	SIGNAL MOD CONTRACT 1434N; SID CONVERTED FROM AS-BUILTS	A.Scales	G.deLeon
TABLE OF REVISIONS CHECK WITH TRACING TO SEE IF YOU HAVE LATEST REVISION				

REFERENCE INFORMATION & FILE NO. OF SURVEYS
--



SAN FRANCISCO MUNICIPAL TRANSPORTATION AGENCY

CITY AND COUNTY OF SAN FRANCISCO

DRAWN:	DATE:
A.SCALES	8/30/2016
CHECKED:	DATE:
G.DELEON	8/30/2016

--

SCALE: AS SHOWN
SHEET OF SHEETS 1 OF 1

TRAFFIC SIGNAL INVENTORY DIAGRAM
ARCH STREET AND BROTHERHOOD WAY

CNN NO. 22524000
REV NO. 2