


ARGENT ALLEY AND MARKET ST

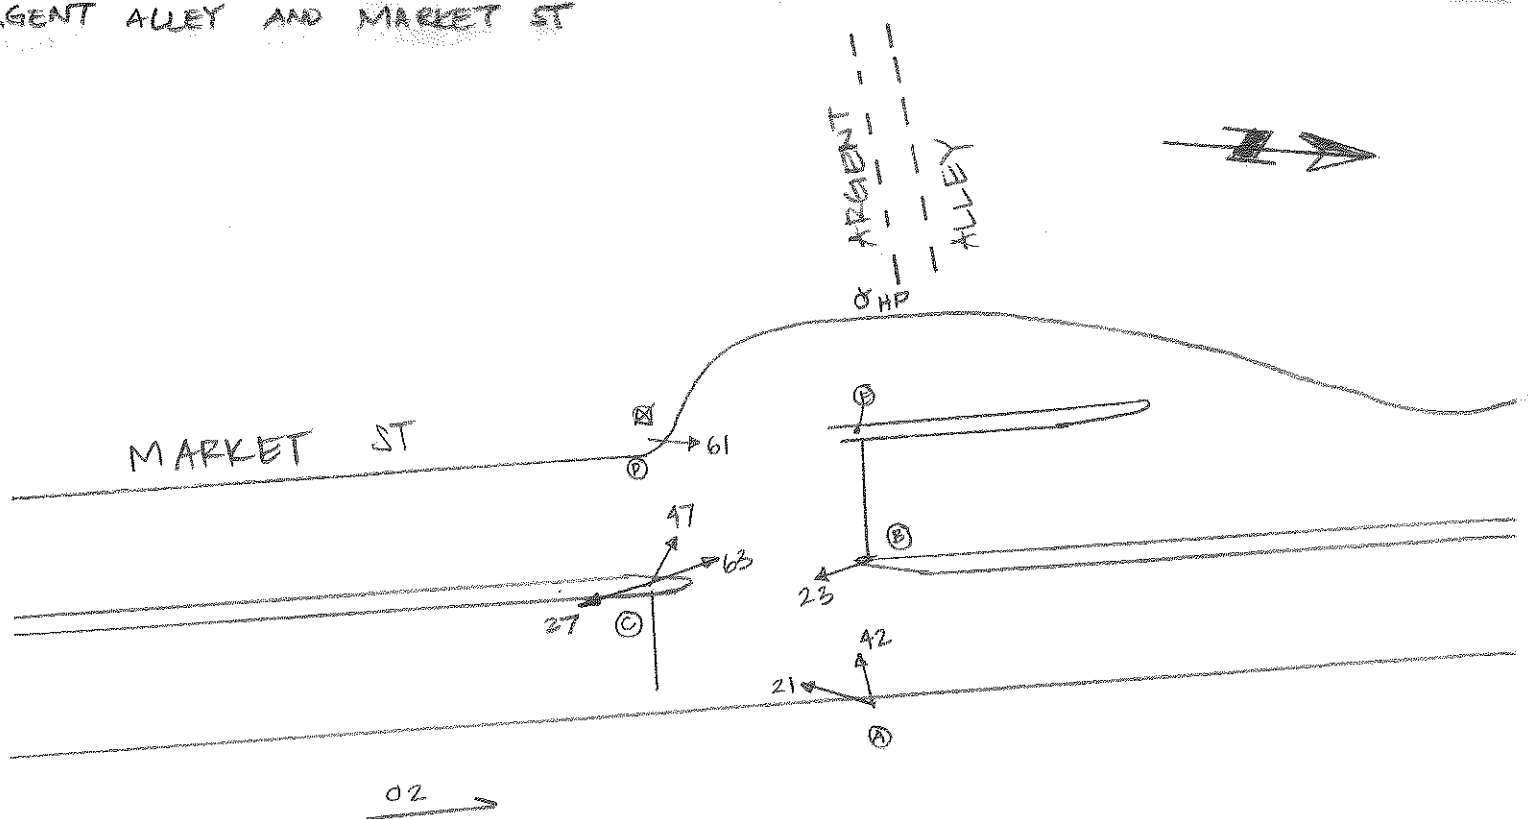

08-31-11

[illegible]

CONTROLLER CABINET SIZE : LARGE BASE CABINET: _____

COMMENTS: INSTALL 12" SIGNALS FOR ALL SIGNAL HEADS

ADDED HEAD 27

* HEADS 42 & 47 ARE 3-SECTION BUT THE MIDDLE & BOTTOM ARE BLANK.