


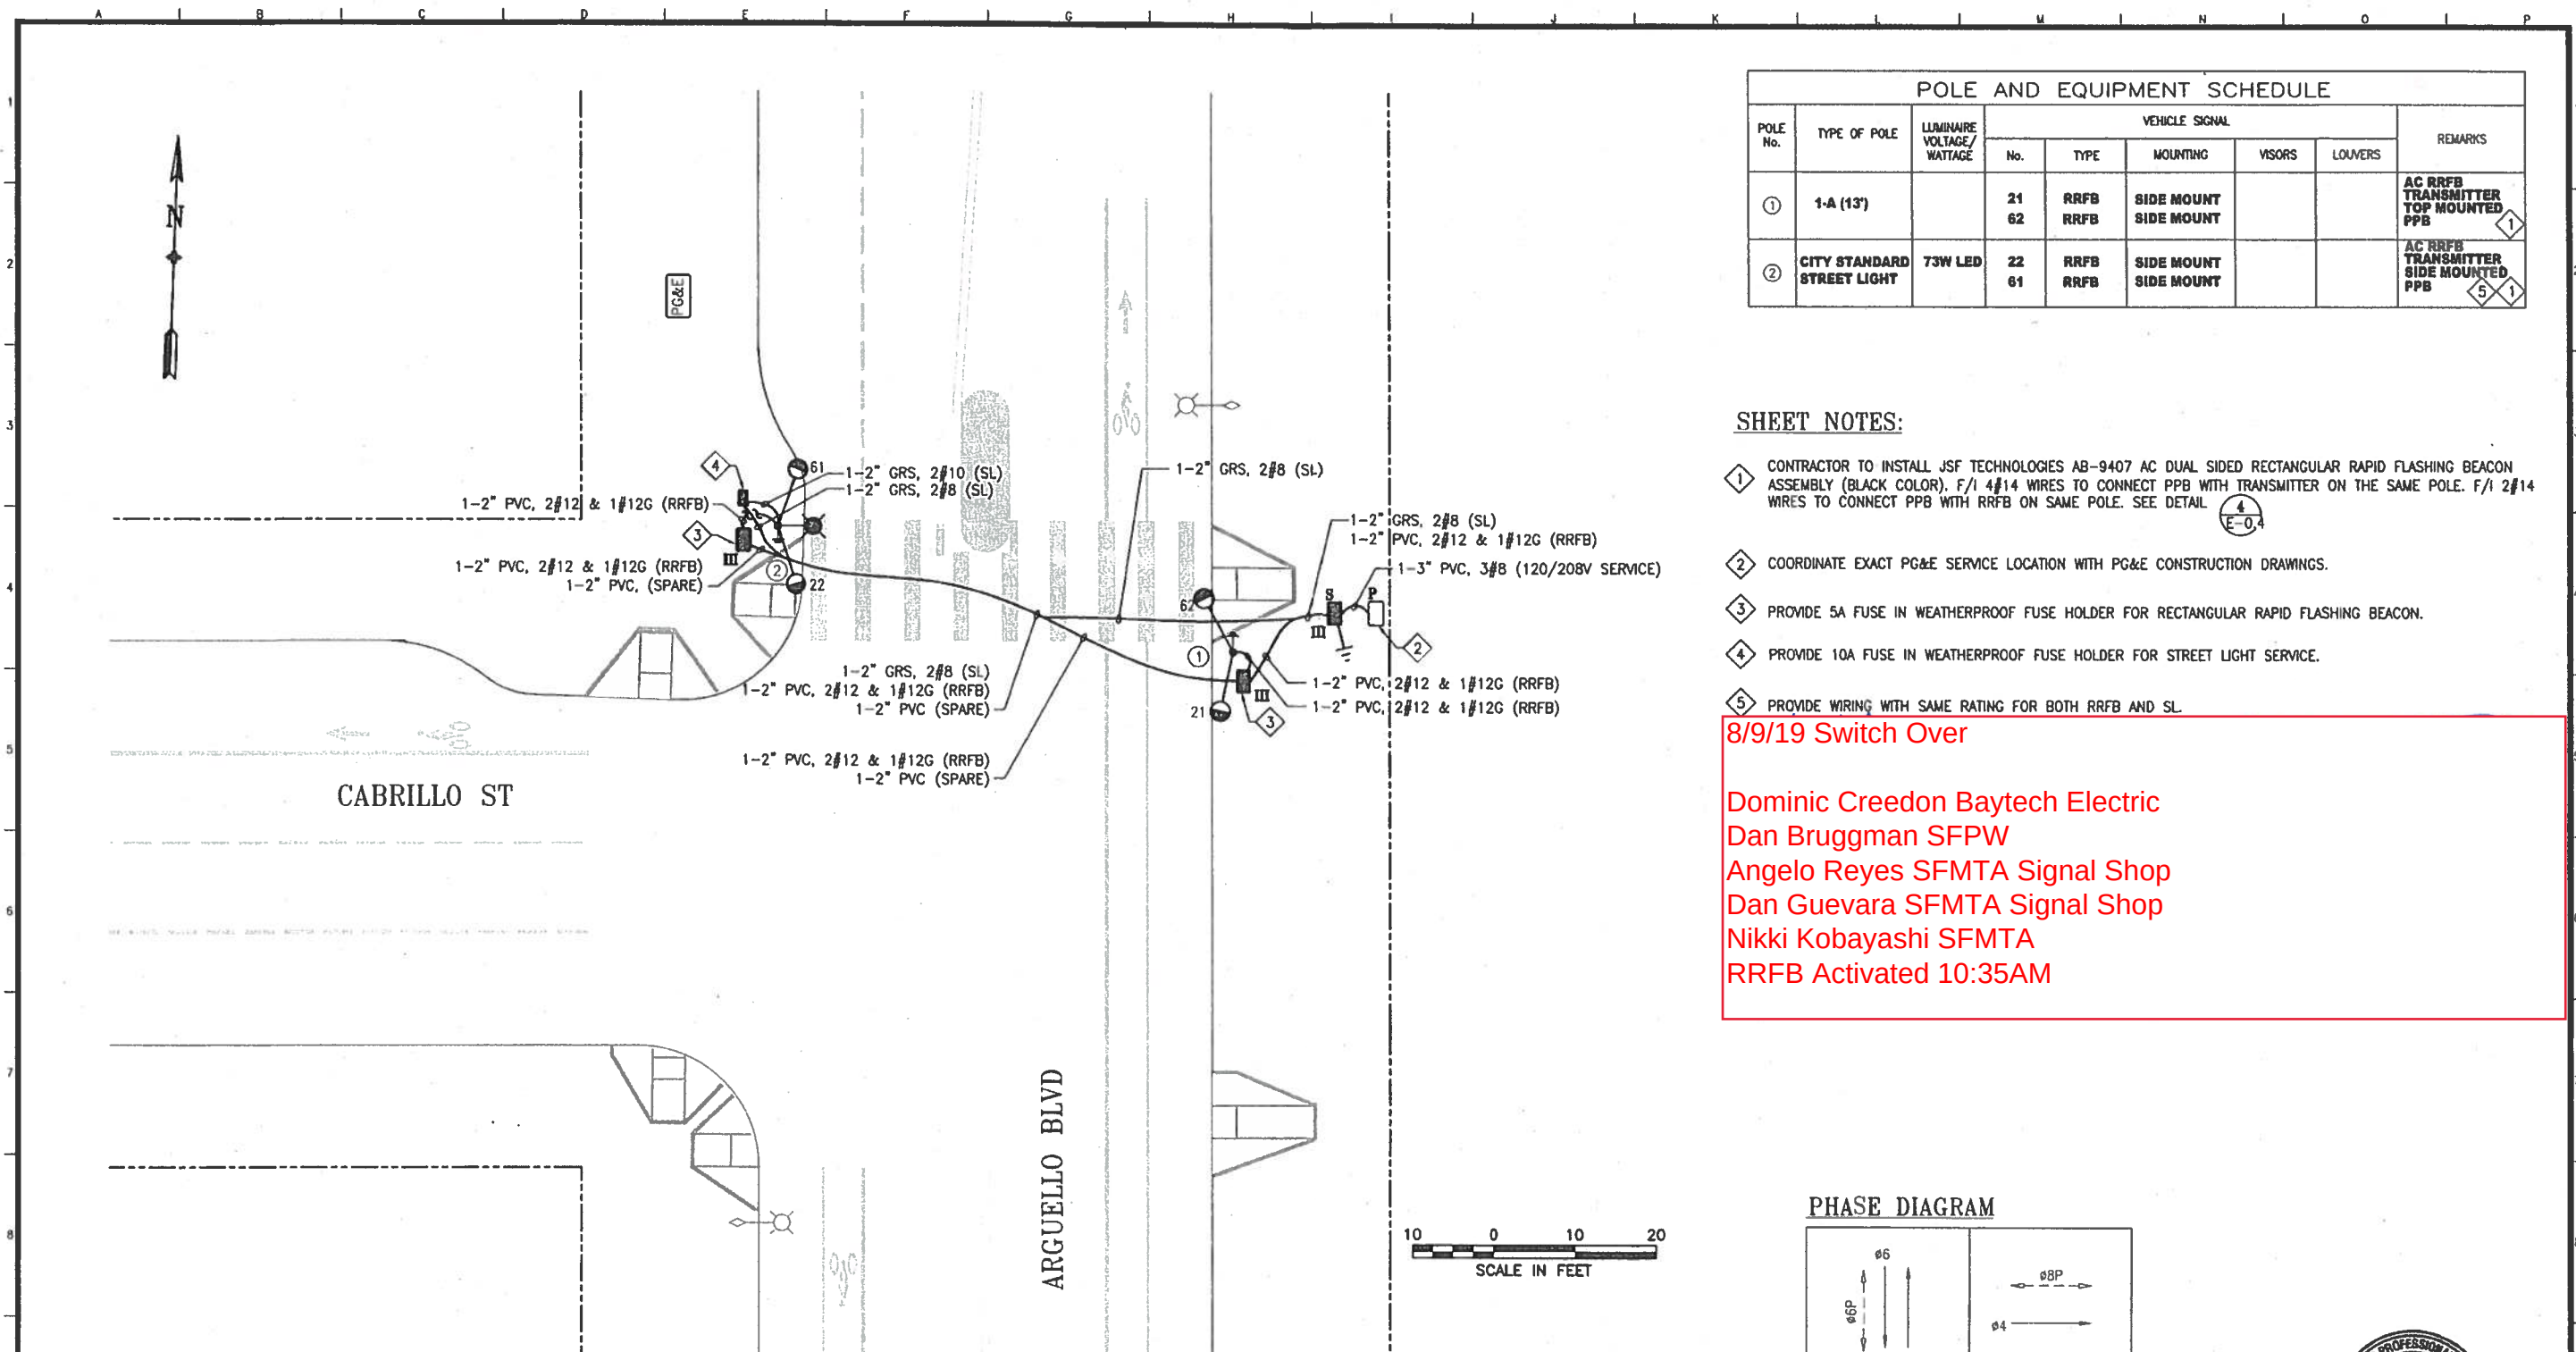


POLE AND EQUIPMENT SCHEDULE								
POLE No.	TYPE OF POLE	LUMINAIRE VOLTAGE/WATTAGE	VEHICLE SIGNAL					REMARKS
			No.	TYPE	MOUNTING	VISORS	LOUVERS	
①	1-A (13')		21 62	RRFB RRFB	SIDE MOUNT SIDE MOUNT			AC RRFB TRANSMITTER TOP MOUNTED PPB 1
②	CITY STANDARD STREET LIGHT	73W LED	22 61	RRFB RRFB	SIDE MOUNT SIDE MOUNT			AC RRFB TRANSMITTER SIDE MOUNTED PPB 5 1

SHEET NOTES:

- 1 CONTRACTOR TO INSTALL JSF TECHNOLOGIES AB-9407 AC DUAL SIDED RECTANGULAR RAPID FLASHING BEACON ASSEMBLY (BLACK COLOR). F/I 4#14 WIRES TO CONNECT PPB WITH TRANSMITTER ON THE SAME POLE. F/I 2#14 WIRES TO CONNECT PPB WITH RRFB ON SAME POLE. SEE DETAIL 
- 2 COORDINATE EXACT PG&E SERVICE LOCATION WITH PG&E CONSTRUCTION DRAWINGS.
- 3 PROVIDE 5A FUSE IN WEATHERPROOF FUSE HOLDER FOR RECTANGULAR RAPID FLASHING BEACON.
- 4 PROVIDE 10A FUSE IN WEATHERPROOF FUSE HOLDER FOR STREET LIGHT SERVICE.
- 5 PROVIDE WIRING WITH SAME RATING FOR BOTH RRFB AND SL.

8/9/19 Switch Over

Dominic Creedon Baytech Electric
Dan Bruggman SFPW
Angelo Reyes SFMTA Signal Shop
Dan Guevara SFMTA Signal Shop
Nikki Kobayashi SFMTA
RRFB Activated 10:35AM

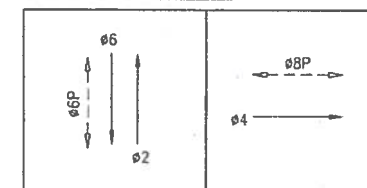

					REFERENCE INFORMATION & FILE NO. OF SURVEYS						DESIGN & ENGINEERING CITY & COUNTY OF SAN FRANCISCO SAN FRANCISCO PUBLIC WORKS 30 VAN NESS AVENUE, 15TH FLOOR SAN FRANCISCO, CA 94112 - 8028		<table><tr><td>Section Mgr:</td><td>PHILIP THWIN</td><td>Date:</td><td></td></tr><tr><td>Deputy Division Mgr:</td><td>IOBAL BHAI DHAPA</td><td></td><td></td></tr><tr><td>Division Mgr:</td><td>PATRICK RIVERA</td><td></td><td></td></tr></table>		Section Mgr:	PHILIP THWIN	Date:		Deputy Division Mgr:	IOBAL BHAI DHAPA			Division Mgr:	PATRICK RIVERA			<table><tr><td>DESIGNED: DATE:</td><td>AS/DG 12/2016</td></tr><tr><td>DRAWN: DATE:</td><td>AS/DG 12/2016</td></tr><tr><td>CHECKED: DATE:</td><td>SL 12/2016</td></tr></table>		DESIGNED: DATE:	AS/DG 12/2016	DRAWN: DATE:	AS/DG 12/2016	CHECKED: DATE:	SL 12/2016			SCALE: AS SHOWN SHEET OF SHEETS 52 OF 65		VARIOUS LOCATIONS PAVEMENT RENOVATION NO. 34		CONTRACT NO. 2795J DRAWING NO. E-1.0 FILE NO. 107,729 REV. NO. 0	
Section Mgr:	PHILIP THWIN	Date:																																								
Deputy Division Mgr:	IOBAL BHAI DHAPA																																									
Division Mgr:	PATRICK RIVERA																																									
DESIGNED: DATE:	AS/DG 12/2016																																									
DRAWN: DATE:	AS/DG 12/2016																																									
CHECKED: DATE:	SL 12/2016																																									
<table><tr><td>NO.</td><td>DATE</td><td>DESCRIPTION</td><td>BY</td><td>APP.</td></tr><tr><td colspan="5">TABLE OF REVISIONS</td></tr><tr><td colspan="5">THIS DRAWING WAS LAST MODIFIED: 05/13/17 16:27, BY: dgargantze</td></tr></table>					NO.	DATE	DESCRIPTION	BY	APP.	TABLE OF REVISIONS					THIS DRAWING WAS LAST MODIFIED: 05/13/17 16:27, BY: dgargantze					ARGUELLO BOULEVARD AND CABRILLO STREET																						
NO.	DATE	DESCRIPTION	BY	APP.																																						
TABLE OF REVISIONS																																										
THIS DRAWING WAS LAST MODIFIED: 05/13/17 16:27, BY: dgargantze																																										

Drawing Path: V:\2955_Various_Location_Pavement_Renovation_No_34\2_Design\Working_Drawings\CEL\Current\CableReinforcement\Relationship_Model Units: Feet
 Plot Time: Sat, 13 May 2017 - 4:36pm
 Login: dpgurtekin@icloud.com
 T:\E_FILES\Special Projects & Street Use\Design_Sust\CAD Standards\BDC Title Block.dwg
 U:\Ortho Project\SID_OIR\Orthogrid.dwg
 V:\2955_Various_Location_Pavement_Renovation_No_34\2_Design\Working_Drawings\CEL\Current\REF\051_TB_22234.dwg