

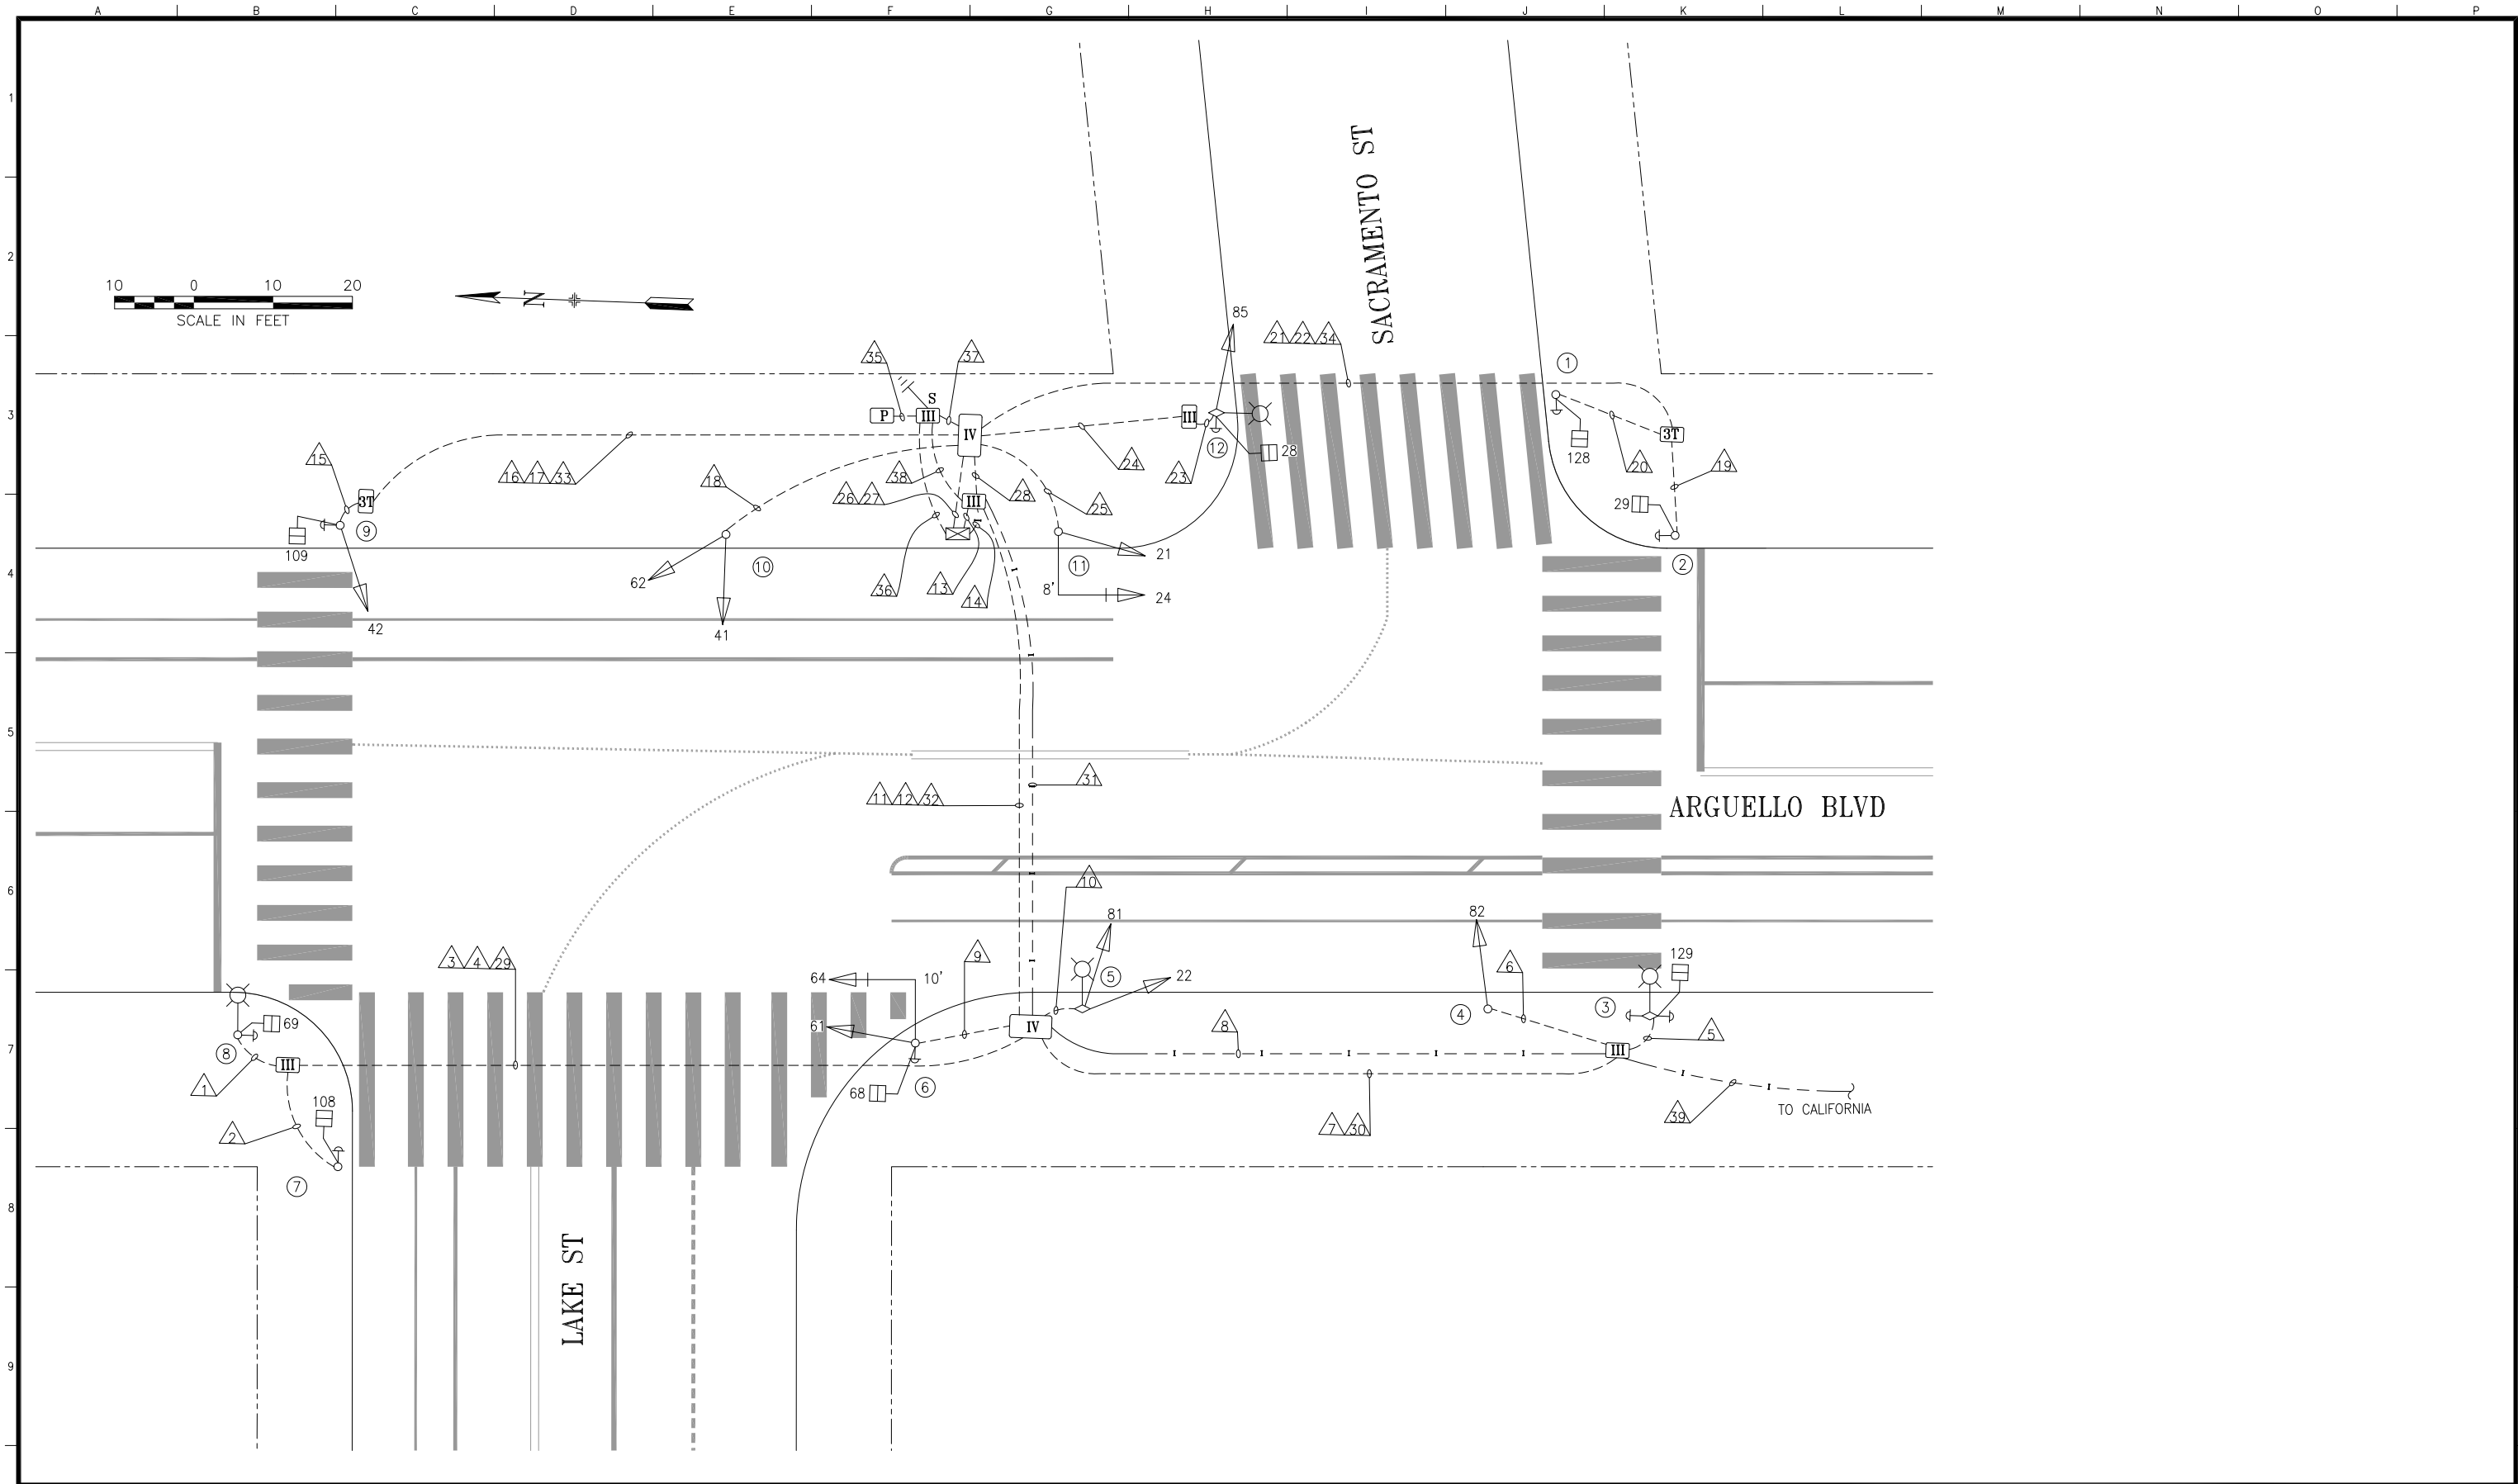


TABLE OF REVISIONS			CHECK WITH TRACING TO SEE IF YOU HAVE LATEST REVISION	
NO.	DATE	DESCRIPTION	BY	APP.
1	02/18/21	ADD APS PER SRC 2020-198	E.LUU	G.DELEON
0	12/05/19	ARGUELLO SIGNAL UPGRADE, CONVERTED FROM CP AND AB	E.LUU	G.DELEON

REFERENCE INFORMATION & FILE NO. OF SURVEYS



SAN FRANCISCO MUNICIPAL TRANSPORTATION AGENCY
CITY AND COUNTY OF SAN FRANCISCO

E.LUU	02/2020
DRAWN:	DATE:
E.LUU	02/2020
CHECKED:	DATE:
G.DELEON	02/2020

SCALE:
AS SHOWN
SHEET OF SHEETS
1 OF 3

TRAFFIC SIGNAL INVENTORY DIAGRAM
ARGUELLO BOULEVARD, LAKE STREET, AND SACRAMENTO STREET

CNN NO.
27578000
REV NO.
1

	A	B	C	D	E	F	G	H	I	J	K	L	M	N	O	P
1																
2																
3																
4																
5																
6																
7																
8																
9																

POLE AND EQUIPMENT SCHEDULE											
POLE No.	TYPE OF POLE	LUMINAIRE TYPE	VEHICLE SIGNAL					PEDESTRIAN SIGNAL			REMARKS
			No.	TYPE	MOUNTING	VISORS	LOUVERS/BP	No.	TYPE	MOUNTING	
①	1-A (7')							128	1S-COUNT	TP-1	APS-2W
②	1-A (7')							29	1S-COUNT	TP-1	APS-2W
③	MUNI POLE W/ 6' LA	LED						129	1S-COUNT	SP-1	APS-2W x 2
④	1-A (13')		82	3S12"	TV-1-T	T					
⑤	MUNI POLE W/ 6' LA	LED	22 81	3S12" 3S12"	SV-2-TC	T T					
⑥	16-2-100 W/ 10' MAST ARM		61 64	3S12" 3S12"	SV-1-T MAS	T T	BP	68	1S-COUNT	SP-1	64 - PLUMBIZER MOUNT BTWN Y&G APS-2W
⑦	1-A (7')							108	1S-COUNT	TP-1	APS-2W
⑧	CITY STANDARD STREETLIGHT	145W LED						69	1S-COUNT	SP-1	APS-2W
⑨	1-A (13')		42	3S12"	TV-1-T	T		109	1S-COUNT	SP-1	APS-2W
⑩	1-A (13')		41 62	3S12" 3S12"	TV-2-T	T T					
⑪	16-2-100 W/ 8' MAST ARM		21 24	3S12" 3S12"	SV-1-T MAS	T T	BP				24-PLUMBIZER MOUNTED BTWN Y & G
⑫	MUNI POLE W/ 6' LA	LED	85	3S12"	SV-1	T		28	1S-COUNT	SP-1	APS-2W

--	--	
[illegible][illegible]