


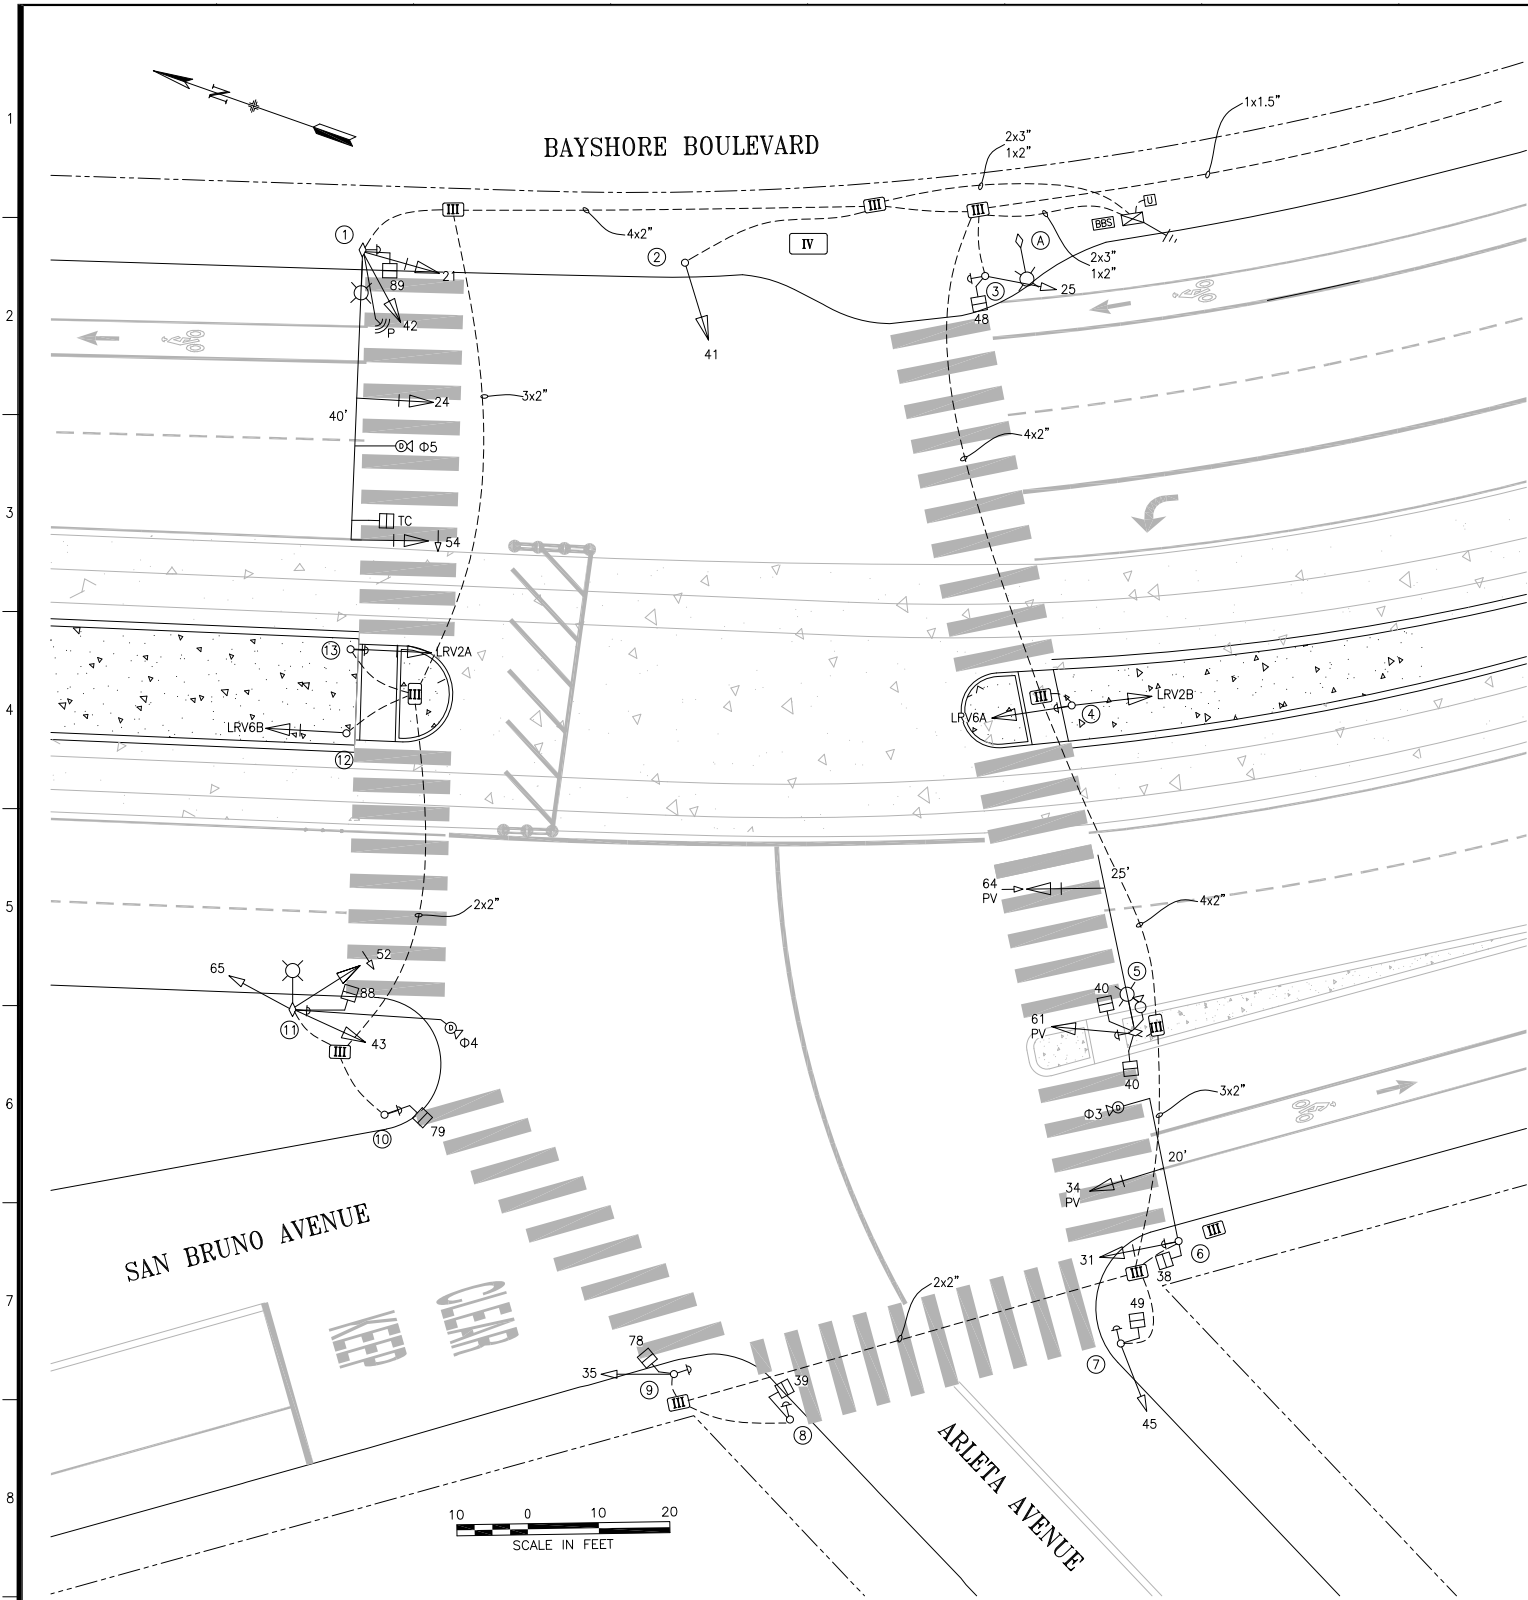

NOTE:
1. CABINET FOUNDATION TYPE: M-SF
2. SIGNALS SWITCHED OVER 6/29/04.
3. ALL PPB ARE ACCESSIBLE.

POLE AND EQUIPMENT SCHEDULE										
POLE No.	TYPE OF POLE	LUMINAIRE (HPS)	VEHICLE SIGNAL			PEDESTRIAN SIGNAL			REMARKS	
		VOLTAGE/ WATTS	No.	TYPE	MOUNTING (F/I)	No.	TYPE	MOUNTING (F/I)		
①	MUNI COMBO POLE (TYPE 770) WITH 40' M.A. & LUMINAIRE ARM		21 42 24 TC 54	3S12" 3S12" 3S12" IS 16"x16" 3S12" LA	SV-2-T MAS MAT MAS	89	1S-COUNT	SP-1	BACKPLATE BACKPLATE BACKPLATE BACKPLATE	DETECTION CAMERA ø5 (BAYSHORE NBLT) PPB PREEMPTION RADIO
②	1-A (10')		41	3S12"	TV-1-T					
③	1-A (10')		25	3S8"	TV-1-T	48	1S-COUNT	SP-1	PPB	
④	1-A (12')		LRV2B LRV6A	2S12" LB-1 2S12" LB-1	TV-2-T				PPB	
⑤	MUNI COMBO POLE (TYPE 770) WITH 25' M.A. & LUMINAIRE ARM		61 64	PV3S12" PV3S12"GVA	SV-1-T MAS	40 40	1S-COUNT 1S-COUNT	SP-2-T	BACKPLATE	PPB CCTV CAMERA
⑥	POLE TYPE 18-2-129 WITH 20' M.A.		31 34	3S12"FR** PV3S12"FR**	SV-1-T MAS	38	1S-COUNT	SP-1	BACKPLATE BACKPLATE	DETECTION CAMERA (ø3 SAN BRUNO SB) PPB
⑦	1-A (10')		45	3S8"	TV-1-T	49	1S-COUNT	SP-1	PPB	
⑧	1-A (10')					39	1S-COUNT	SP-1	PPB	
⑨	1-A (10')		35	3S8"FR**	TV-1-T	78	1S-COUNT	SP-1	PPB	
⑩	1-A (10')					79	1S-COUNT	SP-1	PPB	
⑪	MUNI COMBO POLE (TYPE 770) W/ LUMINARE ARM		65 43 52	3S8" 3S12" 3S12" LA	SV-3-T	88	1S-COUNT	SP-1	DETECTION CAMERA ø4 (ARLETA EB) PPB BACKPLATE	
⑫	1-A (12')		LRV6B	2S12" LB-1	TV-1-T				BACKPLATE	
⑬	1-A (15')		LRV2A	2S12" LB-1	TV-1-T				PPB BACKPLATE	
Ⓐ	MUNI COMBO POLE (TYPE 767) W/ LUMINARE ARM									

M.A. = MAST ARM
**YELLOW AND GREEN SECTIONS ARE NOT USED

NO.	DATE	DESCRIPTION	BY	APPROVED
3	10/28/22	UPDATE TO VIDEO DETECTION PER SHOP MAINTENANCE	C.SKERRIT	G.DELEON
2	1/12/14	SRC 2013-327: UPDATE LRV LUNAR BARS, CONVERT 64 TO GVA, REMOVE 51	C.WONG	B.WOO
1	6/23/08	PER FIELD CHECK 6/23/08	D.YEUNG	A.HERCE
0	6/29/04	TRAFFIC SIGNAL UPGRADE FOR THIRD ST. LIGHT RAIL	K.KWONG	A.HERCE
TABLE OF REVISIONS		CHECKOUT DRAWING THROUGH THE SID CUSTODIAN FOR THE LATEST REVISION		



SFMTA

DRAWN BY: K.KWONG	DATE: 09/2005
CHECKED BY:	DATE:

SCALE AS SHOWN
SHEET OF SHEETS 01 OF 01

TRAFFIC SIGNAL INVENTORY DIAGRAM
ARLETA, BAYSHORE, AND SAN BRUNO AVE

CNN NO: 20298000
REV NO: 3