



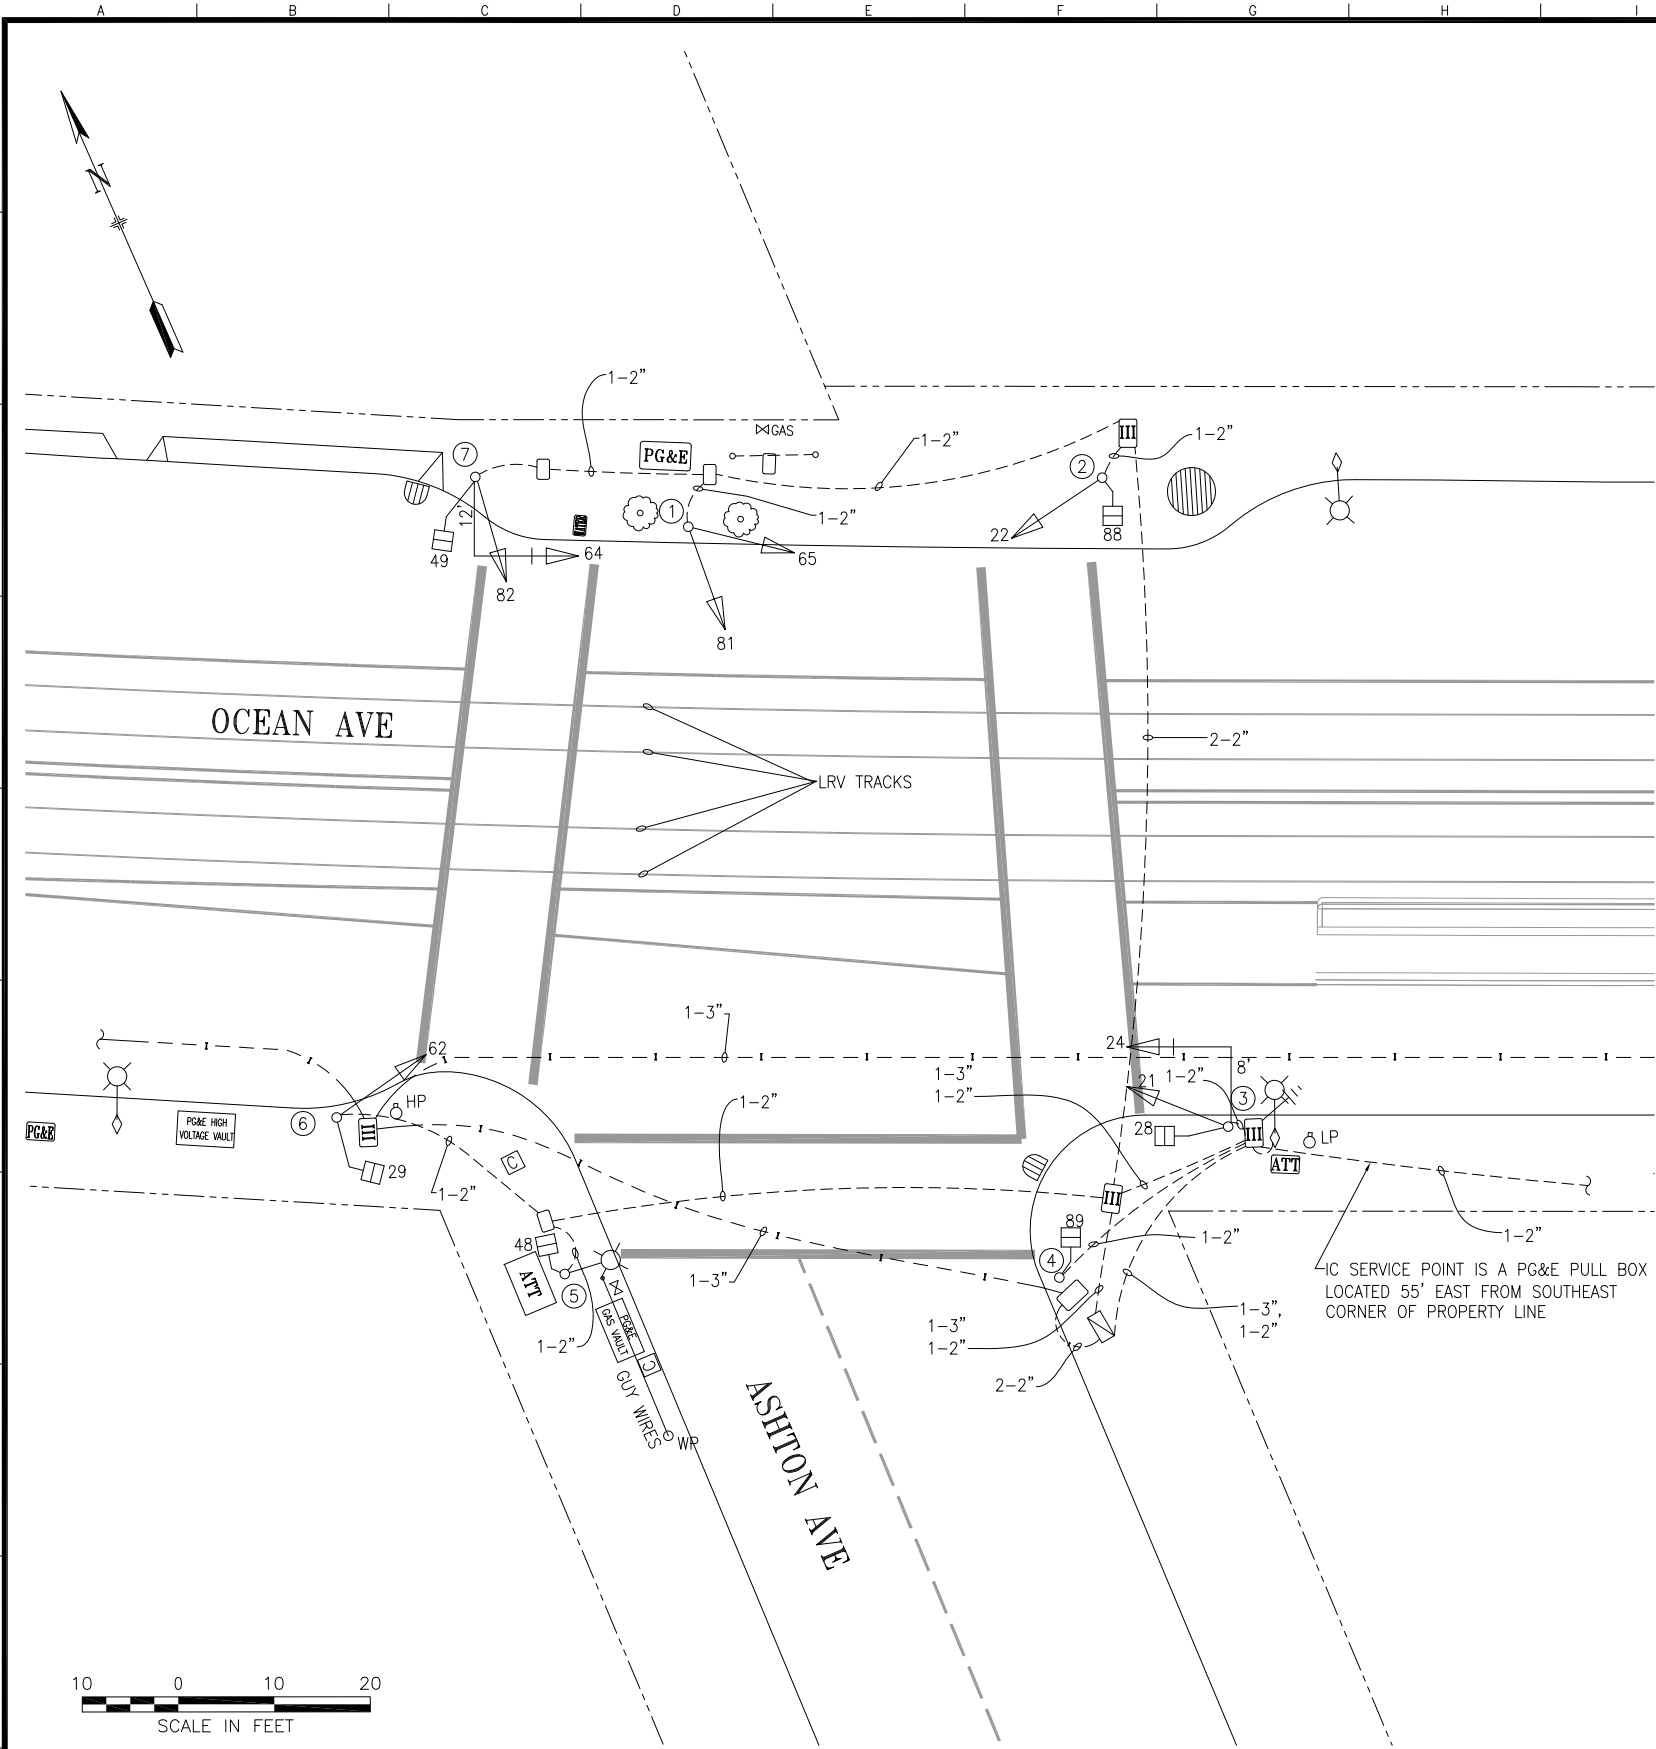

POLE AND EQUIPMENT SCHEDULE											
POLE No.	TYPE OF POLE	LUMINAIRE VOLTAGE/ WATTAGE	VEHICLE SIGNAL					PEDESTRIAN SIGNAL			REMARKS
			No.	TYPE	MOUNTING	VISORS	LOUVERS	No.	TYPE	MOUNTING	
①	1-A (10')		65 81	3S12" 3S12"	TV-2-T	T T					
②	1-A (10')		22	3S12"	TV-1-T	T		88	1S-COUNT	SP-1	
③	16-1-100 WITH 8' MAST ARM		24 21	3S12" 3S12"	MAS SV-1-T	T T		28	1S-COUNT	SP-1	BACKPLATE
④	1-A (7')							89	1S-COUNT	TP-1	
⑤	CITY STANDARD STREET LIGHT	120V 150W						48	1S-COUNT	SP-1	
⑥	1-A (10')		62	3S12"	TV-1-T	T		29	1S-COUNT	SP-1	
⑦	16-1-100 WITH 12' MAST ARM		64 82	3S12" 3S12"	MAS SV-1-T	T T		49	1S-COUNT	SP-1	BACKPLATE

PHASE DIAGRAM

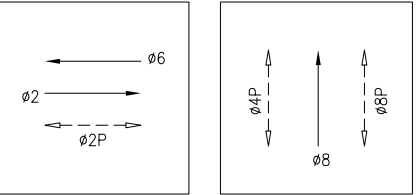

PHASE SEQUENCE
(STEADY DEMAND)

G	Y	R		OCEAN AVE (EB & WB) - 02 & 06
R		G	Y R	ASHTON AVE (NB) - 08
WM	FRH	RH		PED XING ASHTON AVE (SS) - 02P
RH		WM	FRH RH	PED XING OCEAN AVE (WS & ES) - 04P & 08P

0	05/03/12	NEW SIGNAL ACTIVATED THROUGH CT. 60	GH	GD	
NO.	DATE	DESCRIPTION	BY	APP.	
TABLE OF REVISIONS					
CHECK WITH TRACING TO SEE IF YOU HAVE LATEST REVISION					

REFERENCE INFORMATION & FILE NO. OF SURVEYS



SAN FRANCISCO MUNICIPAL TRANSPORTATION AGENCY

CITY AND COUNTY OF SAN FRANCISCO

DESIGNED:	DATE:
GD	12/2013
DRAWN:	DATE:
GD	12/2013
CHECKED:	DATE:
MV	12/2013

--

SCALE:
AS SHOWN
SHEET OF SHEETS
1 OF 1

TRAFFIC SIGNAL INVENTORY DIAGRAM
ASHTON AVE AND OCEAN AVE

CNN NO.
22661000
REV NO.
0