














11/17/202 9:59AM flashing in red & red


Attendees:
Celine Leung (SFMTA SSD)
Victor Ruiz-Vera (SFPW CM)
Phong Nguyen & Dennis Verhalen (Signal Shop)
Mylon Tom & Jim Lau (Bay Area Lightworks)

11/19/2020 10:01am in 3-Color operation

Attendees:
Celine Leung (SFMTA SSD)
Phong Nguyen, Dennis Verhalen & Dennis Dominguez (Signal Shop)

			POLE AND EQUIPMENT SCHEDULE								
POLE No.	TYPE OF POLE	FIXTURE TYPE 	VEHICLE SIGNAL					PEDESTRIAN SIGNAL			REMARKS
			No.	TYPE	MOUNTING	VISORS	LOUVERS	No.	TYPE	MOUNTING	
①	PPB POLE										APS 
②	STEEL STREET LIGHT POLE		22	3S12"	SV-1-T	T		69 88	1S-COUNT 1S-COUNT	SP-1 SP-1	MOUNT 22 AT 10' HIGH APS 
③	(E) MUNI SL POLE	(E) 72W LED	21	3S12"	SV-1-T	T		28	1S-COUNT	SP-1	APS 
④	STEEL STREET LIGHT POLE		42 85	3S12" 3S12"	SV-1-T SV-1-T	T T		89	1S-COUNT	SP-1	MOUNT 42 AT 15' HIGH MOUNT 85 AT 10' HIGH APS 
⑤	1-A (13')		41	3S12"	TV-1-T	T		48	1S-COUNT	SP-1	APS 
⑥	STEEL STREET LIGHT POLE		62	3S12"	SV-1-T	T		29	1S-COUNT	SP-1	MOUNT 62 AT 13' HIGH APS 
⑦	(E) MUNI SL POLE	(E) 72W LED	61 87	3S12" 3S12"	SV-1-T SV-1-T	RA LA		68	1S-COUNT	SP-1	MOUNT 61 AT 15' HIGH MOUNT 87 AT 10' HIGH APS 
⑧	17-2-100 (15')		82 84	3S12" 3S12"	SV-1-T MAS	T T		49	1S-COUNT	SP-1	APS  BACKPLATE

- SHEET NOTES:**
- A PRIOR TO SIGNAL ACTIVATION, CONTACT SFMTA FOR REMOVAL OF STOP SIGN AND PAVEMENT MARKING.
 - B REMOVE AS CONTRACTOR'S PROPERTY EXISTING STREET LIGHT WIRES. RECONNECT EXISTING STREET LIGHT FIXTURE PER WIRING SCHEDULE.
 - C ABANDON EXISTING CONDUIT. CUT WIRING AND CONDUIT TO FACE OF PULLBOX AND CAP BOTH ENDS.
 - D COORDINATE WITH PUC TO VERIFY AND MAINTAIN SERVICE TO OTHER EQUIPMENT. COORDINATE WITH PG&E VIA PUC FOR DE-ENERGIZATION OF EXISTING STREET LIGHT SERVICE AFTER NEW SERVICE IS IN OPERATION.
 - E CONTRACTOR TO PROVIDE APS WIRING. CITY FORCES TO PROVIDE APS PUSH BUTTON PER ADA REQUIREMENTS.
 - F SEE FIXTURE SCHEDULE ON E-0.4.

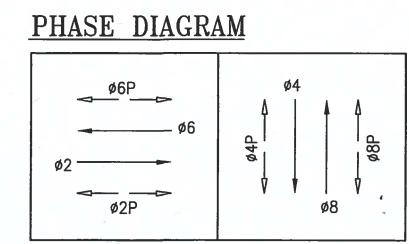

REFERENCE INFORMATION & FILE NO. OF SURVEYS				BUREAU OF DESIGN & ENGINEERING CITY & COUNTY OF SAN FRANCISCO SAN FRANCISCO PUBLIC WORKS 30 VAN NESS AVENUE, 5TH FLOOR SAN FRANCISCO, CA 94102 - 6028		Section Mgr: PHILIP THWIN Deputy Bureau Mgr: IQBALBHAI DHAPA Bureau Mgr: PATRICK RIVERA	Date: 4/10/19 4/11/19 4/11/19	DESIGNED: DATE: 01/2019 DRAWN: DATE: 01/2019 CHECKED: DATE: 01/2019 KK/SL		SCALE: AS SHOWN SHEET OF SHEETS 19 OF 21	LOWER HAIGHT TRAFFIC SIGNALS HAIGHT STREET, BAKER STREET, AND BUENA VISTA AVENUE EAST TRAFFIC SIGNAL PLAN		CONTRACT NO. 1000013166 DRAWING NO. E-6.0 FILE NO. 113,612 REV. NO. 0
TABLE OF REVISIONS THIS DRAWING WAS LAST MODIFIED: 03/27/19 17:47, BY: dgargaritano													

Drawing Path: V:\00000_Muni_Foreward_Haight_Signals\2_Design\Working_Drawings\EEL\Current_Vet\DEI_TB_2234.dwg
Xrefs: \DPT Title Block.dwg
V:\CADD Standards\BOE Title Block.dwg
V:\00000_Muni_Foreward_Haight_Signals\2_Design\Working_Drawings\EEL\Current_Vet\DEI_TB_2234.dwg
Login: dgargaritano
Model Units: Inches
Plot Time: Mon, 08 Apr 2019 - 5:59pm

