


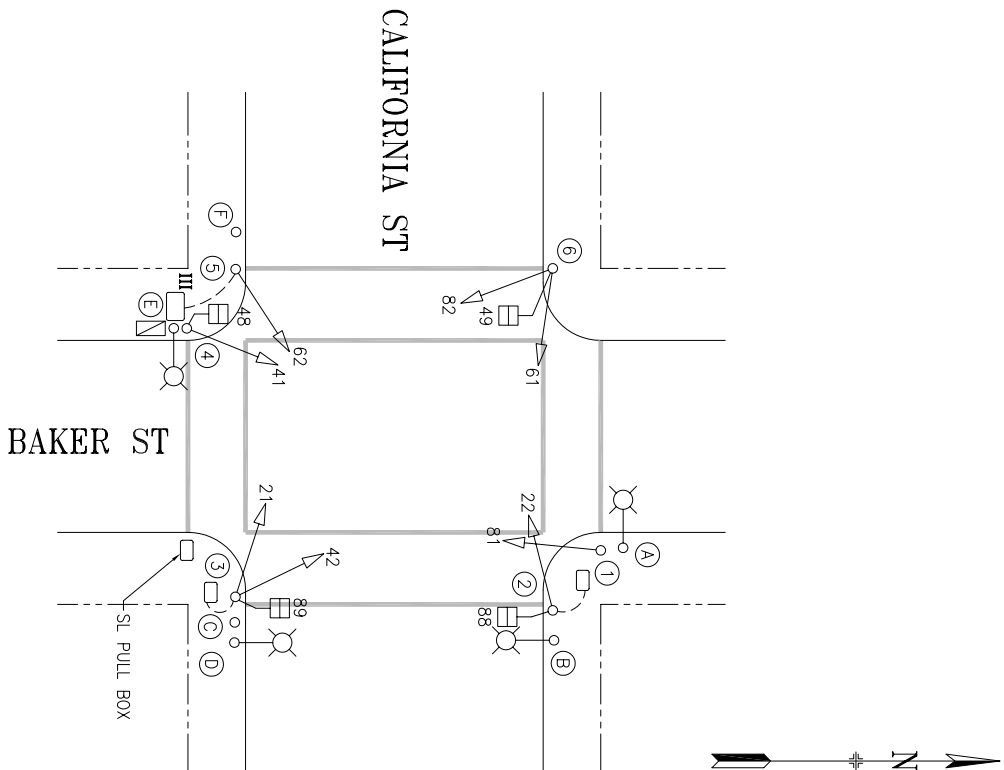

NOTE:
CABINET FOUNDATION TYPE: STD

POLE AND EQUIPMENT SCHEDULE										
POLE No.	TYPE OF POLE	VEHICLE SIGNAL					PEDESTRIAN SIGNAL			REMARKS
		No.	TYPE	MOUNTING	VISORS	LOUVERS	No.	TYPE	MOUNTING	
①	UTILITY	81	3S8"	SV-1	FC					POLE PLATE WITH LAG SCREWS
②	1-A (10')	22	3S8"	TV-1	FC		88	1S-IN	SP-1	
③	1-A (10')	21 42	3S8" 3S8"	TV-2-T	FC FC		89	1S-IN	SP-1	
④	1-A (10')	41	3S8"	TV-1	FC		48	1S-IN	SP-1	
⑤	1-A (10')	62	3S8"	TV-1	FC					
⑥	1-A (10')	61 82	3S8" 3S8"	TV-2-T-SF	FC FC		49	1S-IN	SP-1	
Ⓐ	SL									
Ⓑ	SL									
Ⓒ	UTILITY									
Ⓓ	SL									
Ⓔ	SL									
Ⓕ	UTILITY									



TABLE OF REVISIONS				COMPLETION DATE / ELECTROMAN INITIAL
NO.	DATE	DESCRIPTION	BY APP.	
1	06/95	SIGNAL MODIFICATION C122.	CXL BW	
CHECK WITH TRACKING TO SEE IF YOU HAVE LATEST REVISION				



**DEPARTMENT OF PARKING AND TRAFFIC
DIVISION OF TRAFFIC ENGINEERING
CITY AND COUNTY OF SAN FRANCISCO**

DRAWN:	DATE:	SCALE:	TRAFFIC SIGNAL INVENTORY DIAGRAM	CNN. NO.
CXL	07/09/99	1" = 40'		26827000
CHECKED:	DATE:	SHEET OF SHEETS 1 OF 1		REV. NO.