


POLE AND EQUIPMENT SCHEDULE										
POLE No.	TYPE OF POLE	VEHICLE SIGNAL					PEDESTRIAN SIGNAL			REMARKS
		No.	TYPE	MOUNTING	VISORS	LOUVERS	No.	TYPE	MOUNTING	
①	EX. MARBELITE SL	81	3S8"	SV-1-T	T		69 88	1S-COUNT 1S-COUNT	SP-1 SP-1	
②	EX. SL									
③	EX. 1-A (10')	42 21	3S8" 3S8"	TV-2-T-SFA	T T		28 89	1S-COUNT 1S-COUNT	SP-2-T-SF (AT 90 DEGREES)	PED MOUNTING NIPPLE LENGTHS AT 12"/16"
④	EX. MARBELITE SL	41	3S8"	SV-1-T	T		48	1S-COUNT	SP-1	
⑤	EX. 1-A (10')	62	3S8"	TV-1	T		29	1S-COUNT	SP-1	
⑥	EX. 17-1-70 W/ 15' MA	61 64	3S8" 3S12"	SV-1-T MAS	T T		49	1S-COUNT	SP-1	
⑦	EX. 1-A (10')	82	3S8"	TV-1	T		68	1S-COUNT	SP-1	

PHASE DIAGRAM

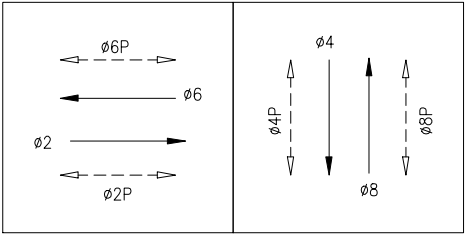

PHASE SEQUENCE

G	Y	R		FELL (EB AND WB) - ø2 AND ø6
R		G	Y R	BAKER (SB AND NB) - ø4 AND ø8
WM	FRH	RH		PED XING BAKER (S/S AND N/S) - 2P AND 6P
RH		WM	FRH RH	PED XING FELL (W/S AND E/S) - 4P AND 8P

1	04-21-11	PED SIGNALS FOR XING FELL INSTALLED VIA SRC #11-068		GD	HQ
NO.	DATE	DESCRIPTION		BY	APP.
TABLE OF REVISIONS					
CHECK WITH TRACING TO SEE IF YOU HAVE LATEST REVISION					

REFERENCE INFORMATION & FILE NO. OF SURVEYS



SAN FRANCISCO MUNICIPAL TRANSPORTATION AGENCY

TRANSPORTATION ENGINEERING

CITY AND COUNTY OF SAN FRANCISCO

DRAWN:	DATE:
GD	03/28/11
CHECKED:	DATE:
HQ	3/28/11

SCALE:
AS SHOWN
SHEET OF SHEETS
1 OF 1

TRAFFIC SIGNAL INVENTORY DIAGRAM

BAKER ST AND FELL ST
TRAFFIC SIGNAL WORK

CNN NO.
26350000
FILE NO.
REV. NO.