


CLAY & BATTERY

42

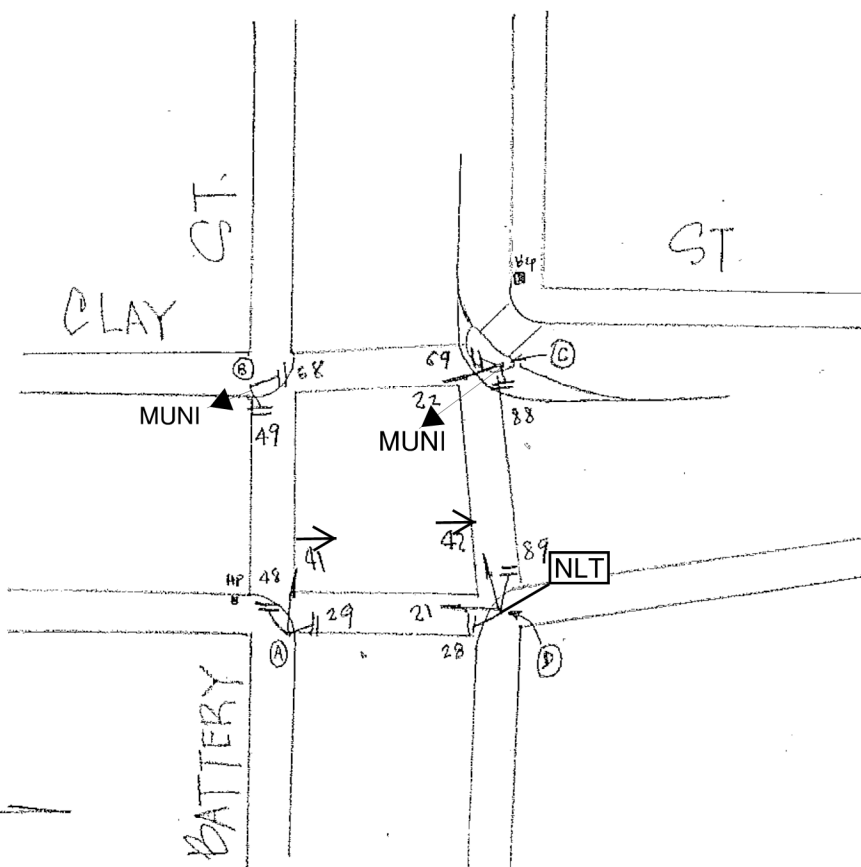

POLE	FUNC.	MAT'L	SIGNAL NO.	MAKE	NO. OF SECT.	SIZE	VISOR	B.P. OR LOUVERS	MOUN'T	PED SIGNAL NO.	LEGEND	MESSAGE		MAKE	MOUN'T
												ELEMENT	COLOR		
A	L	S	41	EC	4	12"GLA	T 12"	NO	S	29	W/DW	GRD	W/OR	ED	S
B	L	S	22	EC	3	12"	T 12"	NO	S	48	W/DW	GRD	W/OR	ED	S
C	L	S	42	EC	4	12"GLA	T 12"	Vertical Louver (green ball)	S	49	W/DW	GRD	W/OR	ED	S
D	L	S	21	EC	3	12"	T 12"	NO	S	68	W/DW	GRD	W/OR	ED	S
			MUNI		2	12"T	T 12"	NO	S	69	W/DW	GRD	W/OR	ED	S
			MUNI		2	12"T	T 12"	NO	S	88	W/DW	GRD	W/OR	ED	S
			NLT		IS	24"X24"		NO	S	89	W/DW	GRD	W/OR	ED	S
										28	W/DW	GRD	W/OR	ED	S

CONTROLLER CABINET SIZE : ORDINARY BASE CABINET: YES

COMMENTS :

Add vertical louver on signal 42 green ball only per SRC 2023-034 - W.Lee 02/20/2023