


42

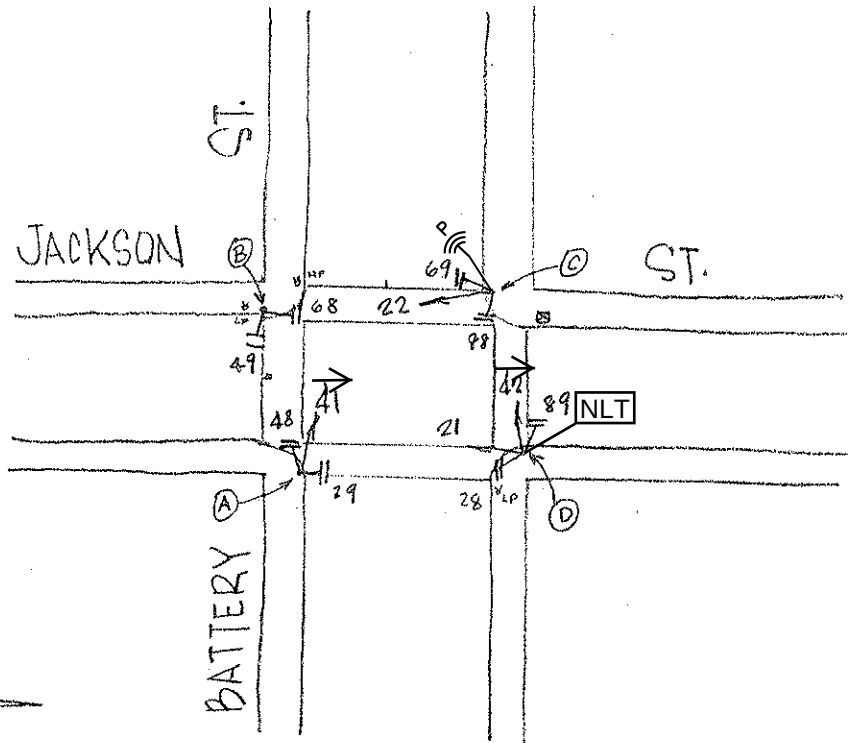

12/28/2022

POLE	FUNC.	MAT'L	SIGNAL NO.	MAKE	NO. OF SECT.	SIZE	VISOR	B.P. OR LOUVERS	MOUN'T	PED SIGNAL NO.	LEGEND	MESSAGE		MAKE	MOUN'T
												ELEMENT	COLOR		
A	L	S	41	EA	4	12"GLA	T 12"	NO	S	29	W/DW	GRD	W/OR	ED	S
B	L	S	22	EA	3	12"	T 12"	NO	S	48	W/DW	GRD	W/OR	ED	S
C	L	S	42	EA	4	12"GLA	T 12"	NO	S	49	W/DW	GRD	W/OR	ED	S
D	L	S	21	EA	3	12"	T 12"	NO	S	68	W/DW	GRD	W/OR	ED	S
			NLT			IS 24"X24"			S	69	W/DW	GRD	W/OR	ED	S
										88	W/DW	GRD	W/OR	ED	S
										89	W/DW	GRD	W/OR	ED	S
										28	W/DW	GRD	W/OR	ED	S

CONTROLLER CABINET SIZE : ORDINARY BASE CABINET: YES

COMMENTS :

Add LT Blank-out Sign, Changed 41 & 42 to 4S12"GLA, Upgrade 22 to 12-inch, per SRC 2022-205 - P.Panyam, W.Lee
Per field: signal 21 is 12-inch.

Add preempt radio on Pole C, per SRC 2022-205 - S.Alexander, M.Velasco