


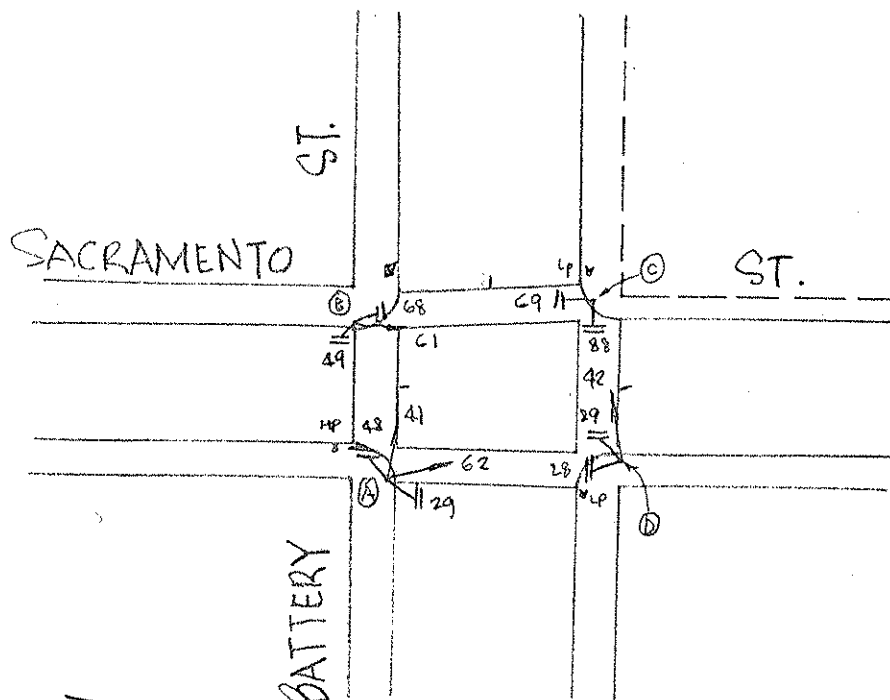

φ2

7-13-79

POLE	FUNC.	MAT'L	SIGNAL NO.	MAKE	NO. OF SECT.	SIZE	VISOR	B.P. OR LOUVERS	MOUN'T	PED SIGNAL NO.	LEGEND	MESSAGE		MAKE	MOUN'T
												ELEMENT	COLOR		
A	L	S	62	EC	3	8"	Fc 8"	No	S	29	W/DW	GRD	W/DW	ED	S
B	L	S	41	EC	3	8"	Fc 8"	No	S	48	W/DW	GRD	W/DW	ED	S
C	L	S	61	GA	3	8"	Fc 8"	No	S	49	W/DW	GRD	W/DW	ED	S
D	L	S	42	EC	3	8"	Fc 8"	No	S	68	W/DW	GRD	W/DW	ED	S
										69	W/DW	GRD	W/DW	ED	S
										88	W/DW	GRD	W/DW	ED	S
										89	W/DW	GRD	W/DW	ED	S
										28	W/DW	GRD	W/DW	ED	S

CONTROLLER CABINET SIZE : ORDINARY BASE CABINET: YES

COMMENTS :