



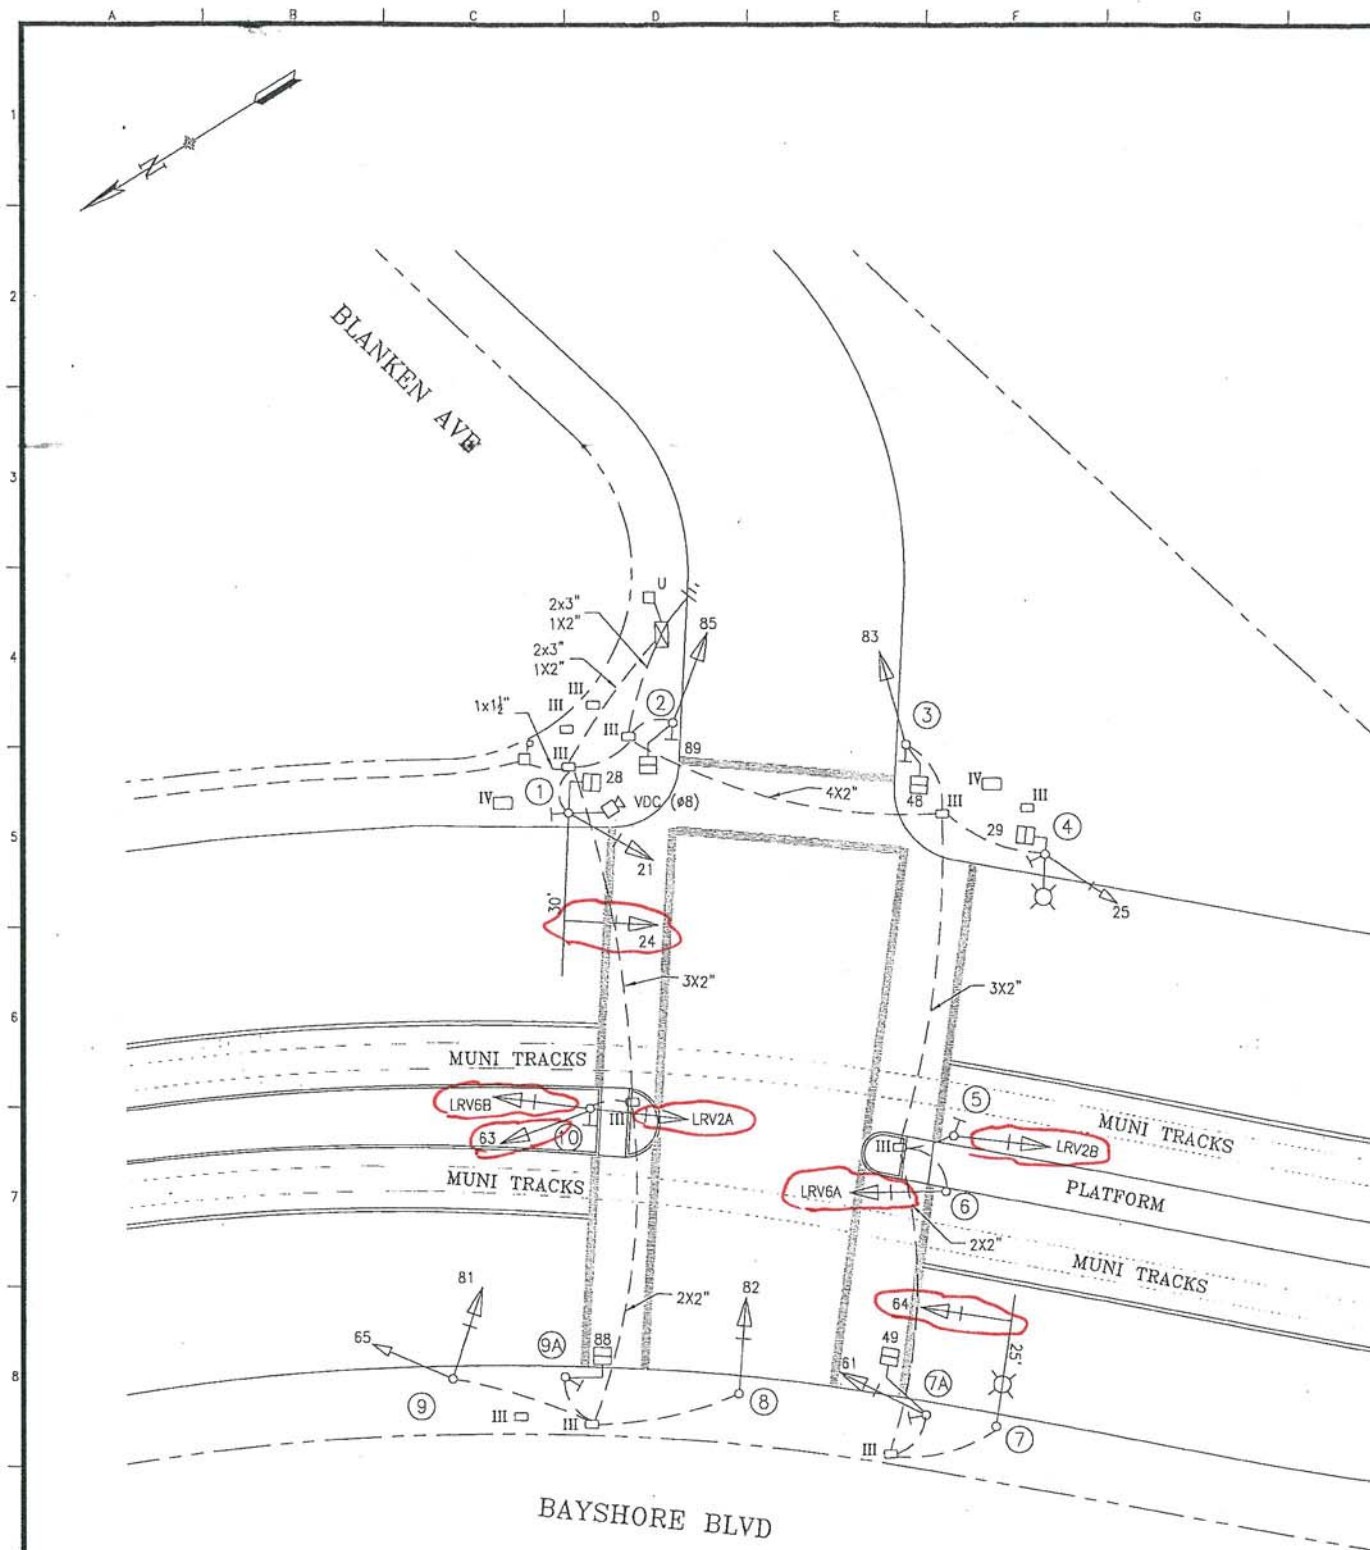

POLE AND EQUIPMENT SCHEDULE									
POLE No.	TYPE OF POLE	LUMINAIRE (HPS) VOLTAGE/ WATTS	VEHICLE SIGNAL			PEDESTRIAN SIGNAL			REMARKS
			No.	TYPE	MOUNTING (F/I)	No.	TYPE	MOUNTING (F/I)	
①	MUNI COMBO POLE (TYPE 767) W/ 30' M.A. AND LUMINAIRE ARM		21 24	3S12" 3S12" <i>GVA</i>	SV-1-T MAS	28	1S-COUNT	SP-1	PPB VDC (#8) BLANKEN BACKPLATE BACKPLATE
②	1-A (10')		85	3S12"	TV-1-T	89	1S-COUNT	SP-1	PPB
③	1-A (10')		83	3S12"	TV-1-T	48	1S-COUNT	SP-1	PPB
④	MUNI COMBO POLE (TYPE 765N) W/ LUMINAIRE ARM		25	3S8"	SV-1-T	29	1S-COUNT	SP-1	PPB BACKPLATE
⑤	1-A (10')			LRV2B 2S12" <i>T</i>	TV-1-T				PPB
⑥	1-A (10')			LRV6A 2S12" <i>T</i>	TV-1-T				BACKPLATE
⑦	MUNI COMBO POLE (TYPE 767) W/ 25' M.A. & LUMINAIRE ARM		64	3S12" <i>GVA</i>	MAS				BACKPLATE
⑦A	1-A (10')		61	3S12"	TV-1-T	49	1S-COUNT	SP-1	PPB BACKPLATE
⑧	1-A (10')		82	3S12"	TV-1-T				BACKPLATE
⑨	MUNI COMBO POLE (TYPE 765N) WITH LUMINAIRE ARM		65 81	3S8" 3S12"	SV-2-T				BACKPLATE
⑨A	1-A (10')					88	1S-COUNT	SP-1	PPB
⑩	1-A (12')			LRV2A 2S12" <i>T</i> LRV6B 2S12" <i>T</i> 63 3S12" <i>GVA</i>	TV-2-T SV-1-T				PPB BACKPLATE BACKPLATE

M.A. = MAST ARM

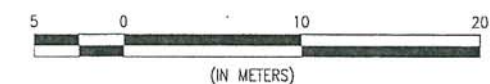

3 1/12/14 RED MARK CHANGES PER SRC 2013-327 2 8/19/10 AS PER FIELD CHECK 1 6/18/08 PER FIELD CHECK 6/18/08 0 6/29/04 NEW TRAFFIC SIGNAL FOR THIRD ST. LIGHT RAIL		BW CW AH AH DY AH KK AH BY APP.			DEPARTMENT OF PARKING AND TRAFFIC DIVISION OF TRAFFIC ENGINEERING CITY AND COUNTY OF SAN FRANCISCO		DRAWN: DATE: SCALE: KK 9/05 1:200	TRAFFIC SIGNAL INVENTORY DIAGRAM BAYSHORE AND BLANKEN	CNN NO. 20299000
NO. DATE DESCRIPTION CHECK WITH TRACING TO SEE IF YOU HAVE LATEST REVISION		COMPLETION DATE / ELECTRICIAN INITIAL			CHECKED: DATE: SHEET OF SHEETS 1 OF 1	REV. NO. 3			