




POLE AND EQUIPMENT SCHEDULE										
POLE No.	TYPE OF POLE	STREETLIGHT LUMINAIRE WATTAGE & TYPE (AND SL)	VEHICLE SIGNAL				PEDESTRIAN SIGNAL			REMARKS
			No.	TYPE	MOUNTING	VISORS	No.	TYPE	MOUNTING	
①	TYPE 1-A (10')	-	52 65	3S12" LA 3S12"	TV-2-T	T T	69	1S-COUNT	SP-1	APS
②	MUNI POLE W/ 6' LUMINAIRE	-	-	-	-	-	88	1S-COUNT	SP-1-T	APS EXTERNAL CONDUIT REPEATER
③	TYPE 1-A (10')	-	45	3S12"	TV-1-T	T	-	-	-	APS
④	19-1-100 POLE W/ 8' MAST ARM & 6' LUMINAIRE ARM	250W HPS (52A)	67	3S12"	MAS	T	49 68	1S-COUNT 1S-COUNT	SP-1 w/ 36" NIPPLE SP-1 w/ 36" NIPPLE	BACKPLATE APS ACCESS POINT
⑤	16-1-100 W/ 15' MAST ARM	-	63 64	3S12" 3S12"	SV-1 MAS	T T	-	-	-	BACKPLATE
⑥	28-5-100 POLE W/50' MAST ARM	-	21 42 24 54	3S12" 3S12" 3S12" 3S12" LA	SV-2-TC MAS MAS MAS	T T T T	89	1S-COUNT	SP-1 w/ 36" NIPPLE	BACKPLATES APS REPEATER
⑦	TYPE 1-A (10')	-	47	3S12"	TV-1-T	T	-	-	-	-
⑧	TYPE 1-A (10')	-	25 41	3S12" 3S12"	TV-2-T	T T	48	1S-COUNT	SP-1 w/ 36" NIPPLE	2 APS
⑨	PPB POLE									APS
	EX. SL POLE	-	-	-	-	-	-	-	-	REPEATER
	EX. SL POLE	-	-	-	-	-	-	-	-	REPEATER

NO.		DATE	DESCRIPTION	BY	APP.
2	7/12/19		ADDED PPB POLE 9 PER SRC 2018-278	KAS	MV
1	06/XX/16		ADDED APS PER FIELD	CS2	GDL
0	10/4/10		FULL INTERSECTION UPGRADE	DY	CH
TABLE OF REVISIONS					
CHECK WITH TRACING TO SEE IF YOU HAVE LATEST REVISION					

REFERENCE INFORMATION & FILE NO. OF SURVEYS	

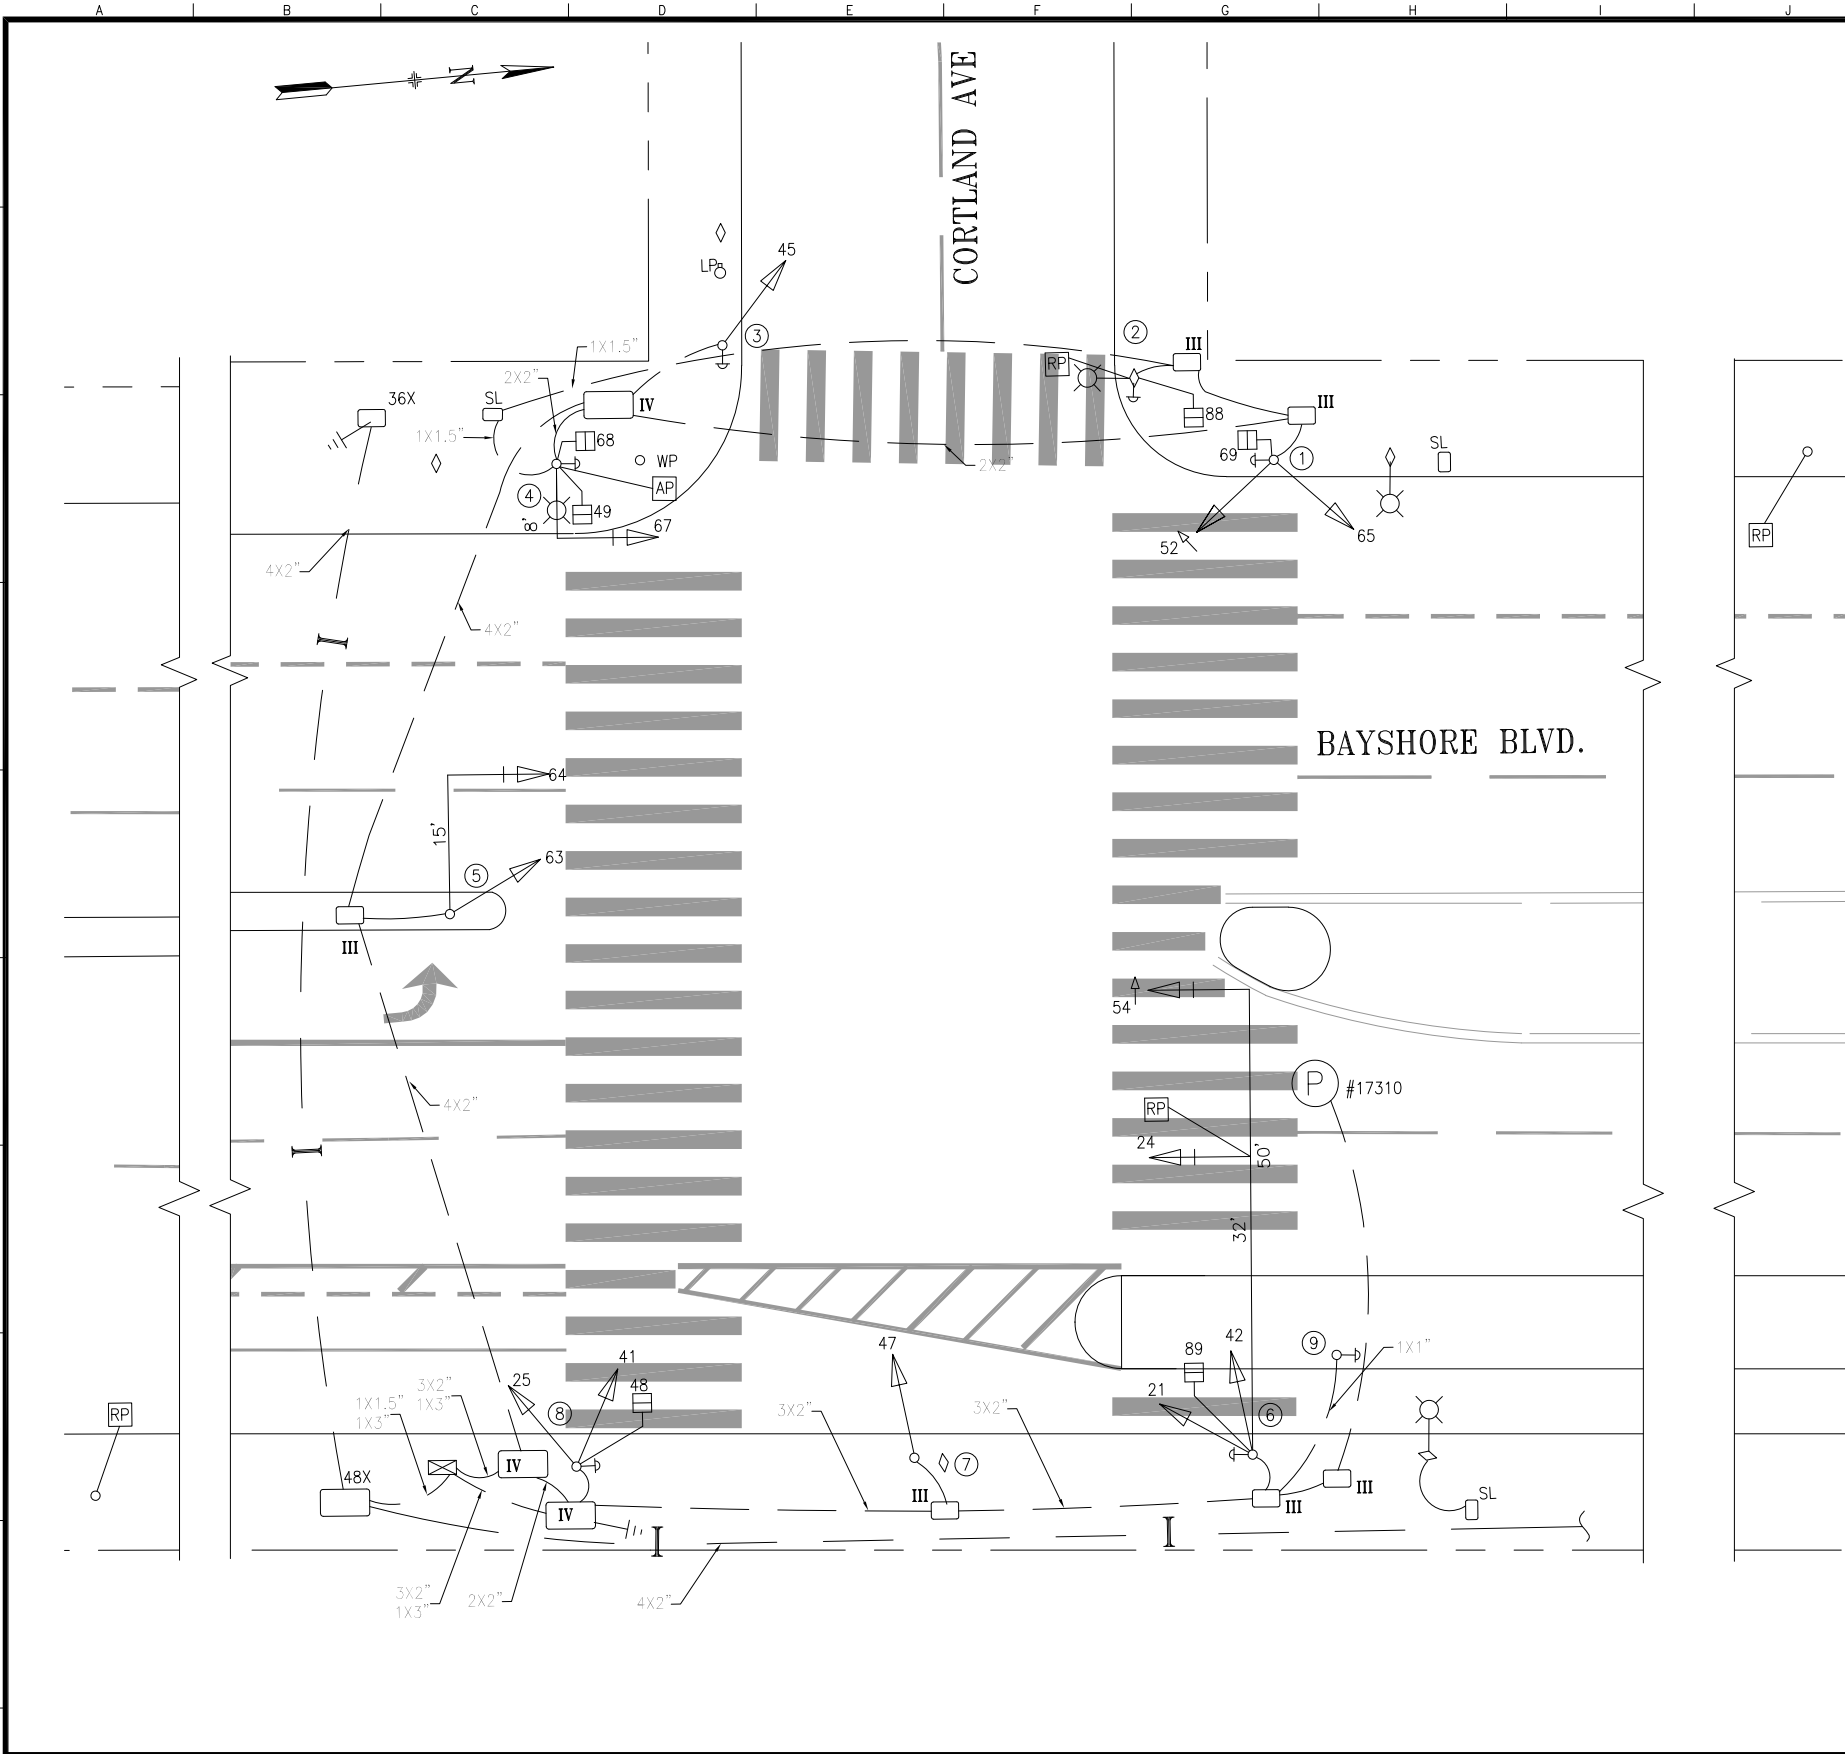

SAN FRANCISCO MUNICIPAL TRANSPORTATION AGENCY
CITY AND COUNTY OF SAN FRANCISCO

DRAWN: DY	DATE: 8/12
CHECKED: RJ	DATE: 8/12

SCALE: 1" = 10'
SHEET OF SHEETS 1 OF 1

TRAFFIC SIGNAL INVENTORY DIAGRAM
BAYSHORE BLVD AND CORTLAND AVE

CNN NO. 21023000
REV NO. 2