



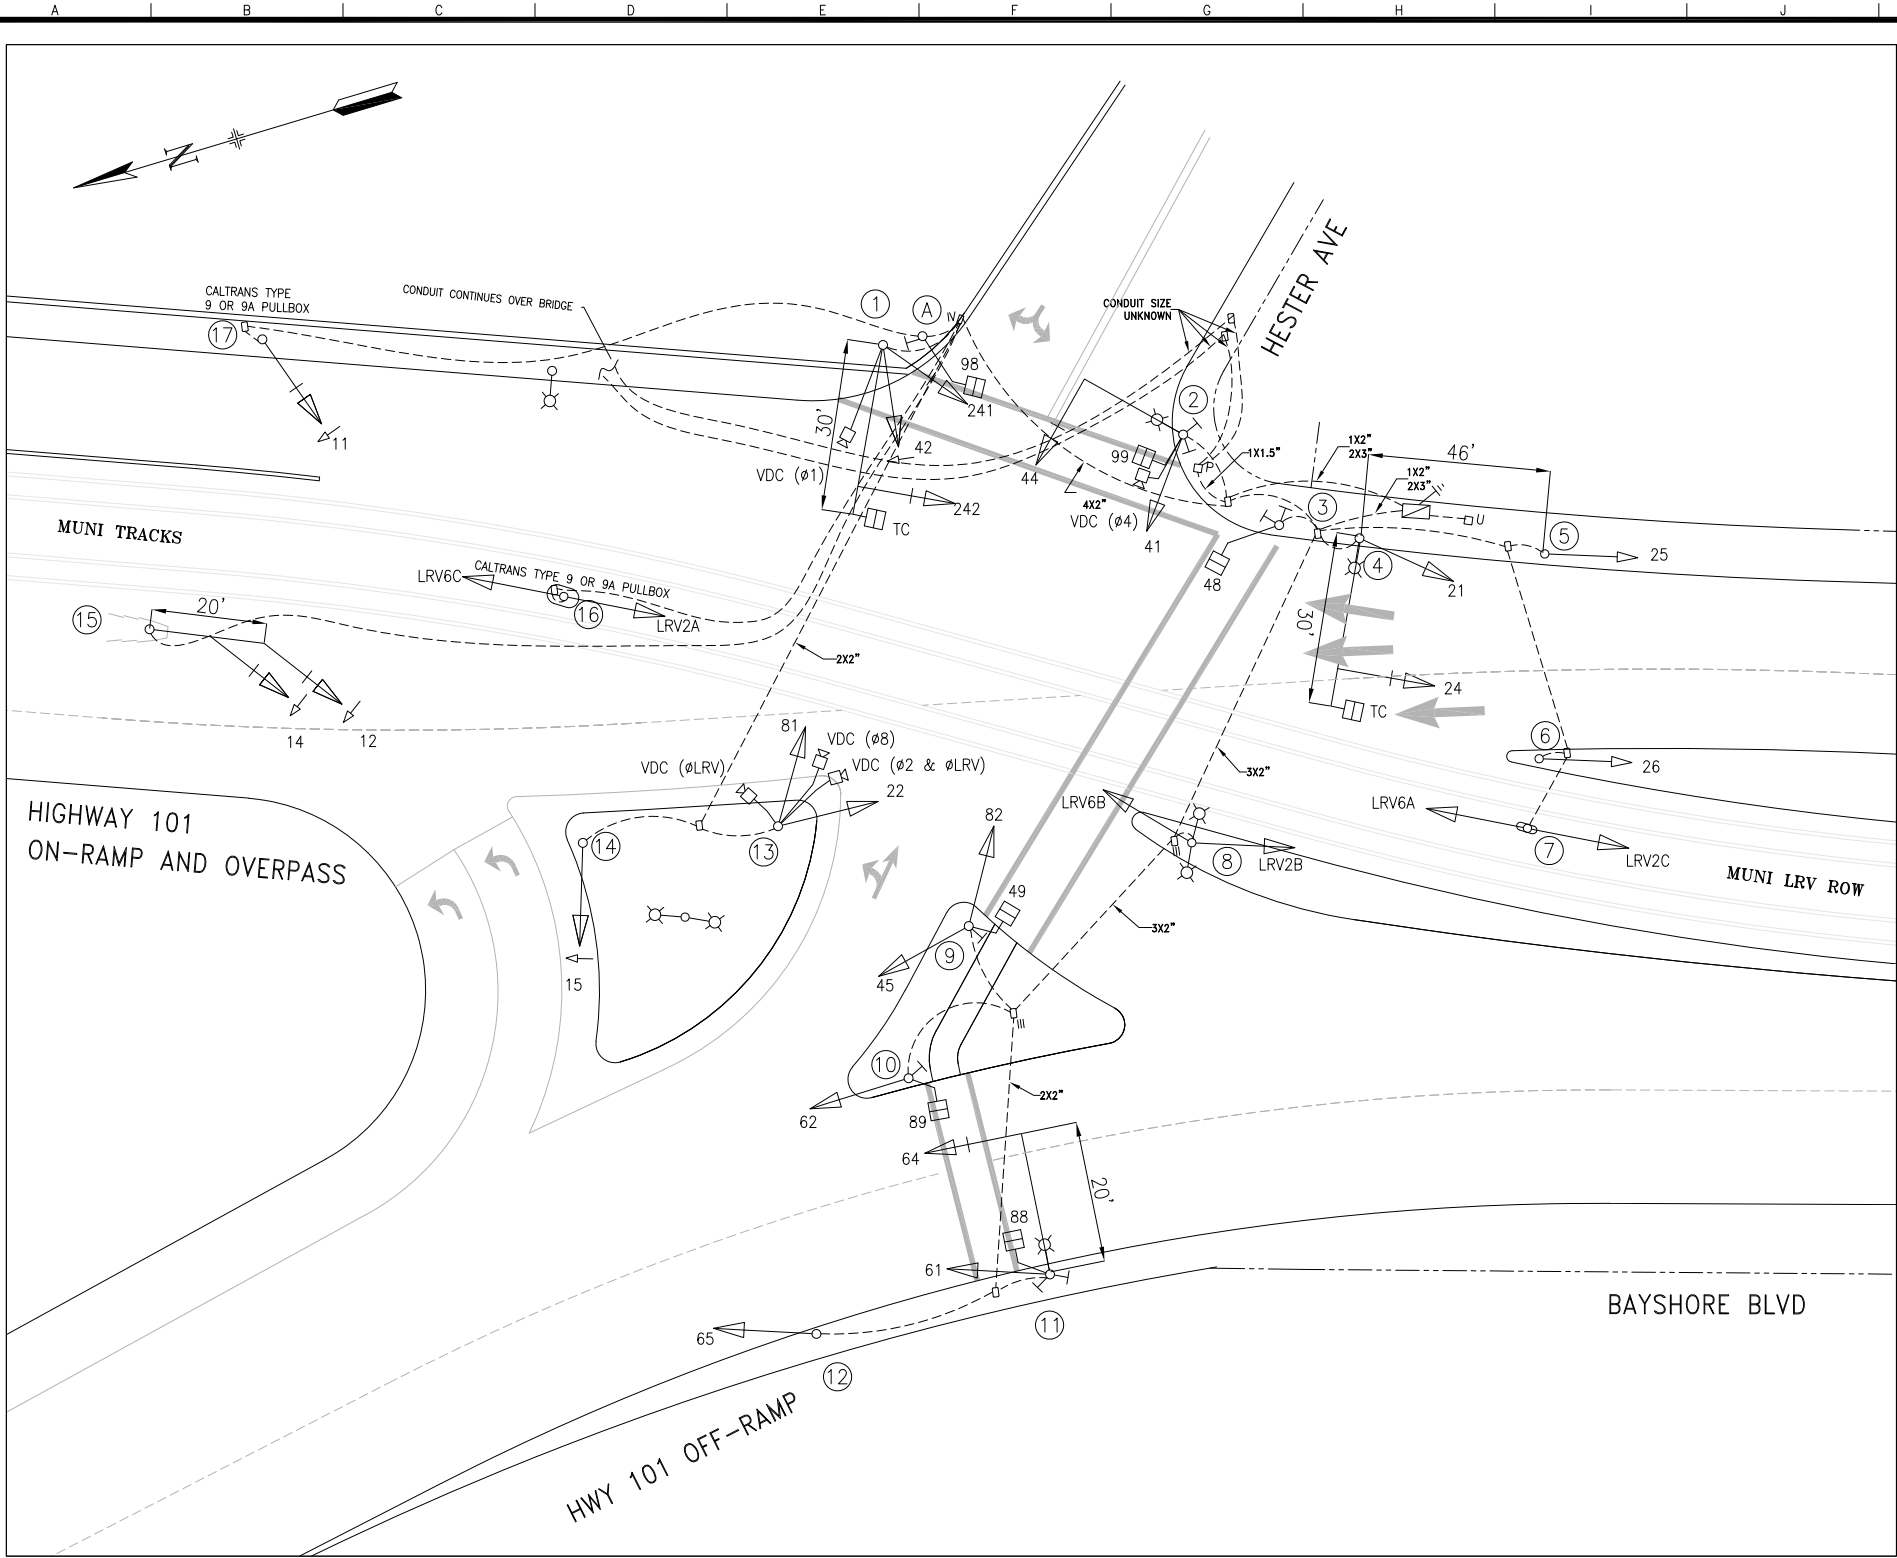

NOTES:
1. THIS INTERSECTION IS ON CALTRANS PROPERTY
2. CABINET TYPE: M-SF

POLE AND EQUIPMENT SCHEDULE									
POLE No.	TYPE OF POLE	LUMINAIRE (HPS)		VEHICLE SIGNAL		PEDESTRIAN SIGNAL		REMARKS	
		VOLTAGE/ WATTS	No.	TYPE	MOUNTING (F/I)	No.	TYPE		
①	TYPE 18-3-80 (MODIFIED) W/ 30' M.A.		42 241 242 TC	3S12" R,Y,G(LA) 3S12" 3S12" IS 16" x 16"	SV-2-T MAS MAT			POLE HEIGHT = 14' MAST ARM SECOND TENON IS 5' FROM THE END CAP VDC (#1 NB HWY 101 OFF-RAMP)	
②	TYPE 17-2-80 W/ 20' M.A.		41 44	3S12" 3S12"	SV-1-T MAS	99	IS-C	SP-1	PPB PPB VDC (#4 SB HWY 101 OFF-RAMP)
③	TYPE 1-A (7')					48	IS-C	TP-1	PPB PPB
④	MUNI COMBO POLE W/ 30' M.A.		21 24 TC	3S12" 3S12" IS 16" x 16"	SV-1-T MAS MAT			MAST ARM SECOND TENON IS 5' FROM THE END CAP TSP EQUIPMENT	
⑤	TYPE 1-A (10')		25	3S8"	TV-1				
⑥	TYPE 1-A (10')		26	3S8"	TV-1				
⑦	TYPE 1-A (15')		LRV2C LRV6A	2S12" - 2S12" -	TV-2-T				
⑧	STREET LIGHT		LRV2B LRV6B	2S12" - 2S12" -	SV-2-T				
⑨	TYPE 1-A (10')		45 82	3S12" 4S12" R,Y,GLA,GRA	TV-2-T	49	IS-C	SP-1	PPB
⑩	TYPE 1-A (10')		62	3S12"	TV-1	89	IS-C	SP-1	PPB
⑪	TYPE 19A-1-80 W/ 20' M.A.		61 64	3S12" 3S12"	SV-1-T MAS	88	IS-C	SP-1	PPB PPB
⑫	TYPE 1-A (10')		65	3S12"	TV-1-T				
⑬	MUNI COMBO POLE		81 22	4S12" R,Y,GLA,GRA 3S12"	SV-2-T			VDC (#8 NB HESTER) VDC (#LRV SB BAYSHORE) VDC (#2 NB & #LRV NB BAYSHORE)	
⑭	MUNI COMBO POLE		15	3S12" R,YLA,GLA	SV-1-T				
⑮	TYPE 18-2-80 (MODIFIED) WITH 20' M.A.		12 14	3S12" R,YLA,GLA 3S12" R,YLA,GLA	MAS MAS			POLE HEIGHT = 14' MAST ARM SECOND TENON IS 10' FROM THE END CAP	
⑯	TYPE 1-A (12')		LRV2A LRV6C	2S12" - 2S12" -	TV-2-T			POLE HEIGHT = 14'	
⑰	TYPE 18-1-80 (MODIFIED) WITH 5' M.A.		11	3S12" R,Y,GLA	MAS			POLE HEIGHT = 14'	
A	TYPE 1-A (7')					98	IS-C	TP-1	PPB

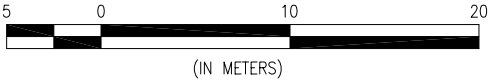

3	6/10/20	REVISE PED PHASES 28 & 29 TP 98 & 99 PER TIMING CARD AND SRC 2019-085	ECT	BT
2	11/18/14	PER FIELD CHECK- ONLY 1 PPB ON POLES 9 & 10. ADD STREETLIGHTS.	DYoung	BWoo
		NEW Y LENSES POLES 14 & 15. 12" SIGNAL POLE 12. NEW LRV LUNAR BARS		
1	6/21/10	PER FIELD CHECK	DC	CH
0	11/3/04	3RD STREET LIGHT RAIL PROJECT - SEGMENT E		
		CONTRACT NO. MR-1144		
NO.	DATE	DESCRIPTION	BY	APP.
TABLE OF REVISIONS CHECK WITH TRACING TO SEE IF YOU HAVE LATEST REVISION				

REFERENCE INFORMATION & FILE NO. OF SURVEYS
--



SAN FRANCISCO MUNICIPAL TRANSPORTATION AGENCY
CITY AND COUNTY OF SAN FRANCISCO

DRAWN: DY	DATE: 12/05
CHECKED:	DATE:

SCALE: 1:200
SHEET OF SHEETS

TRAFFIC SIGNAL INVENTORY DIAGRAM
BAYSHORE BLVD AND HESTER/HWY 101 OFF-RAMP INTERSECTION

CNN NO. 33209000
REV NO. 3