

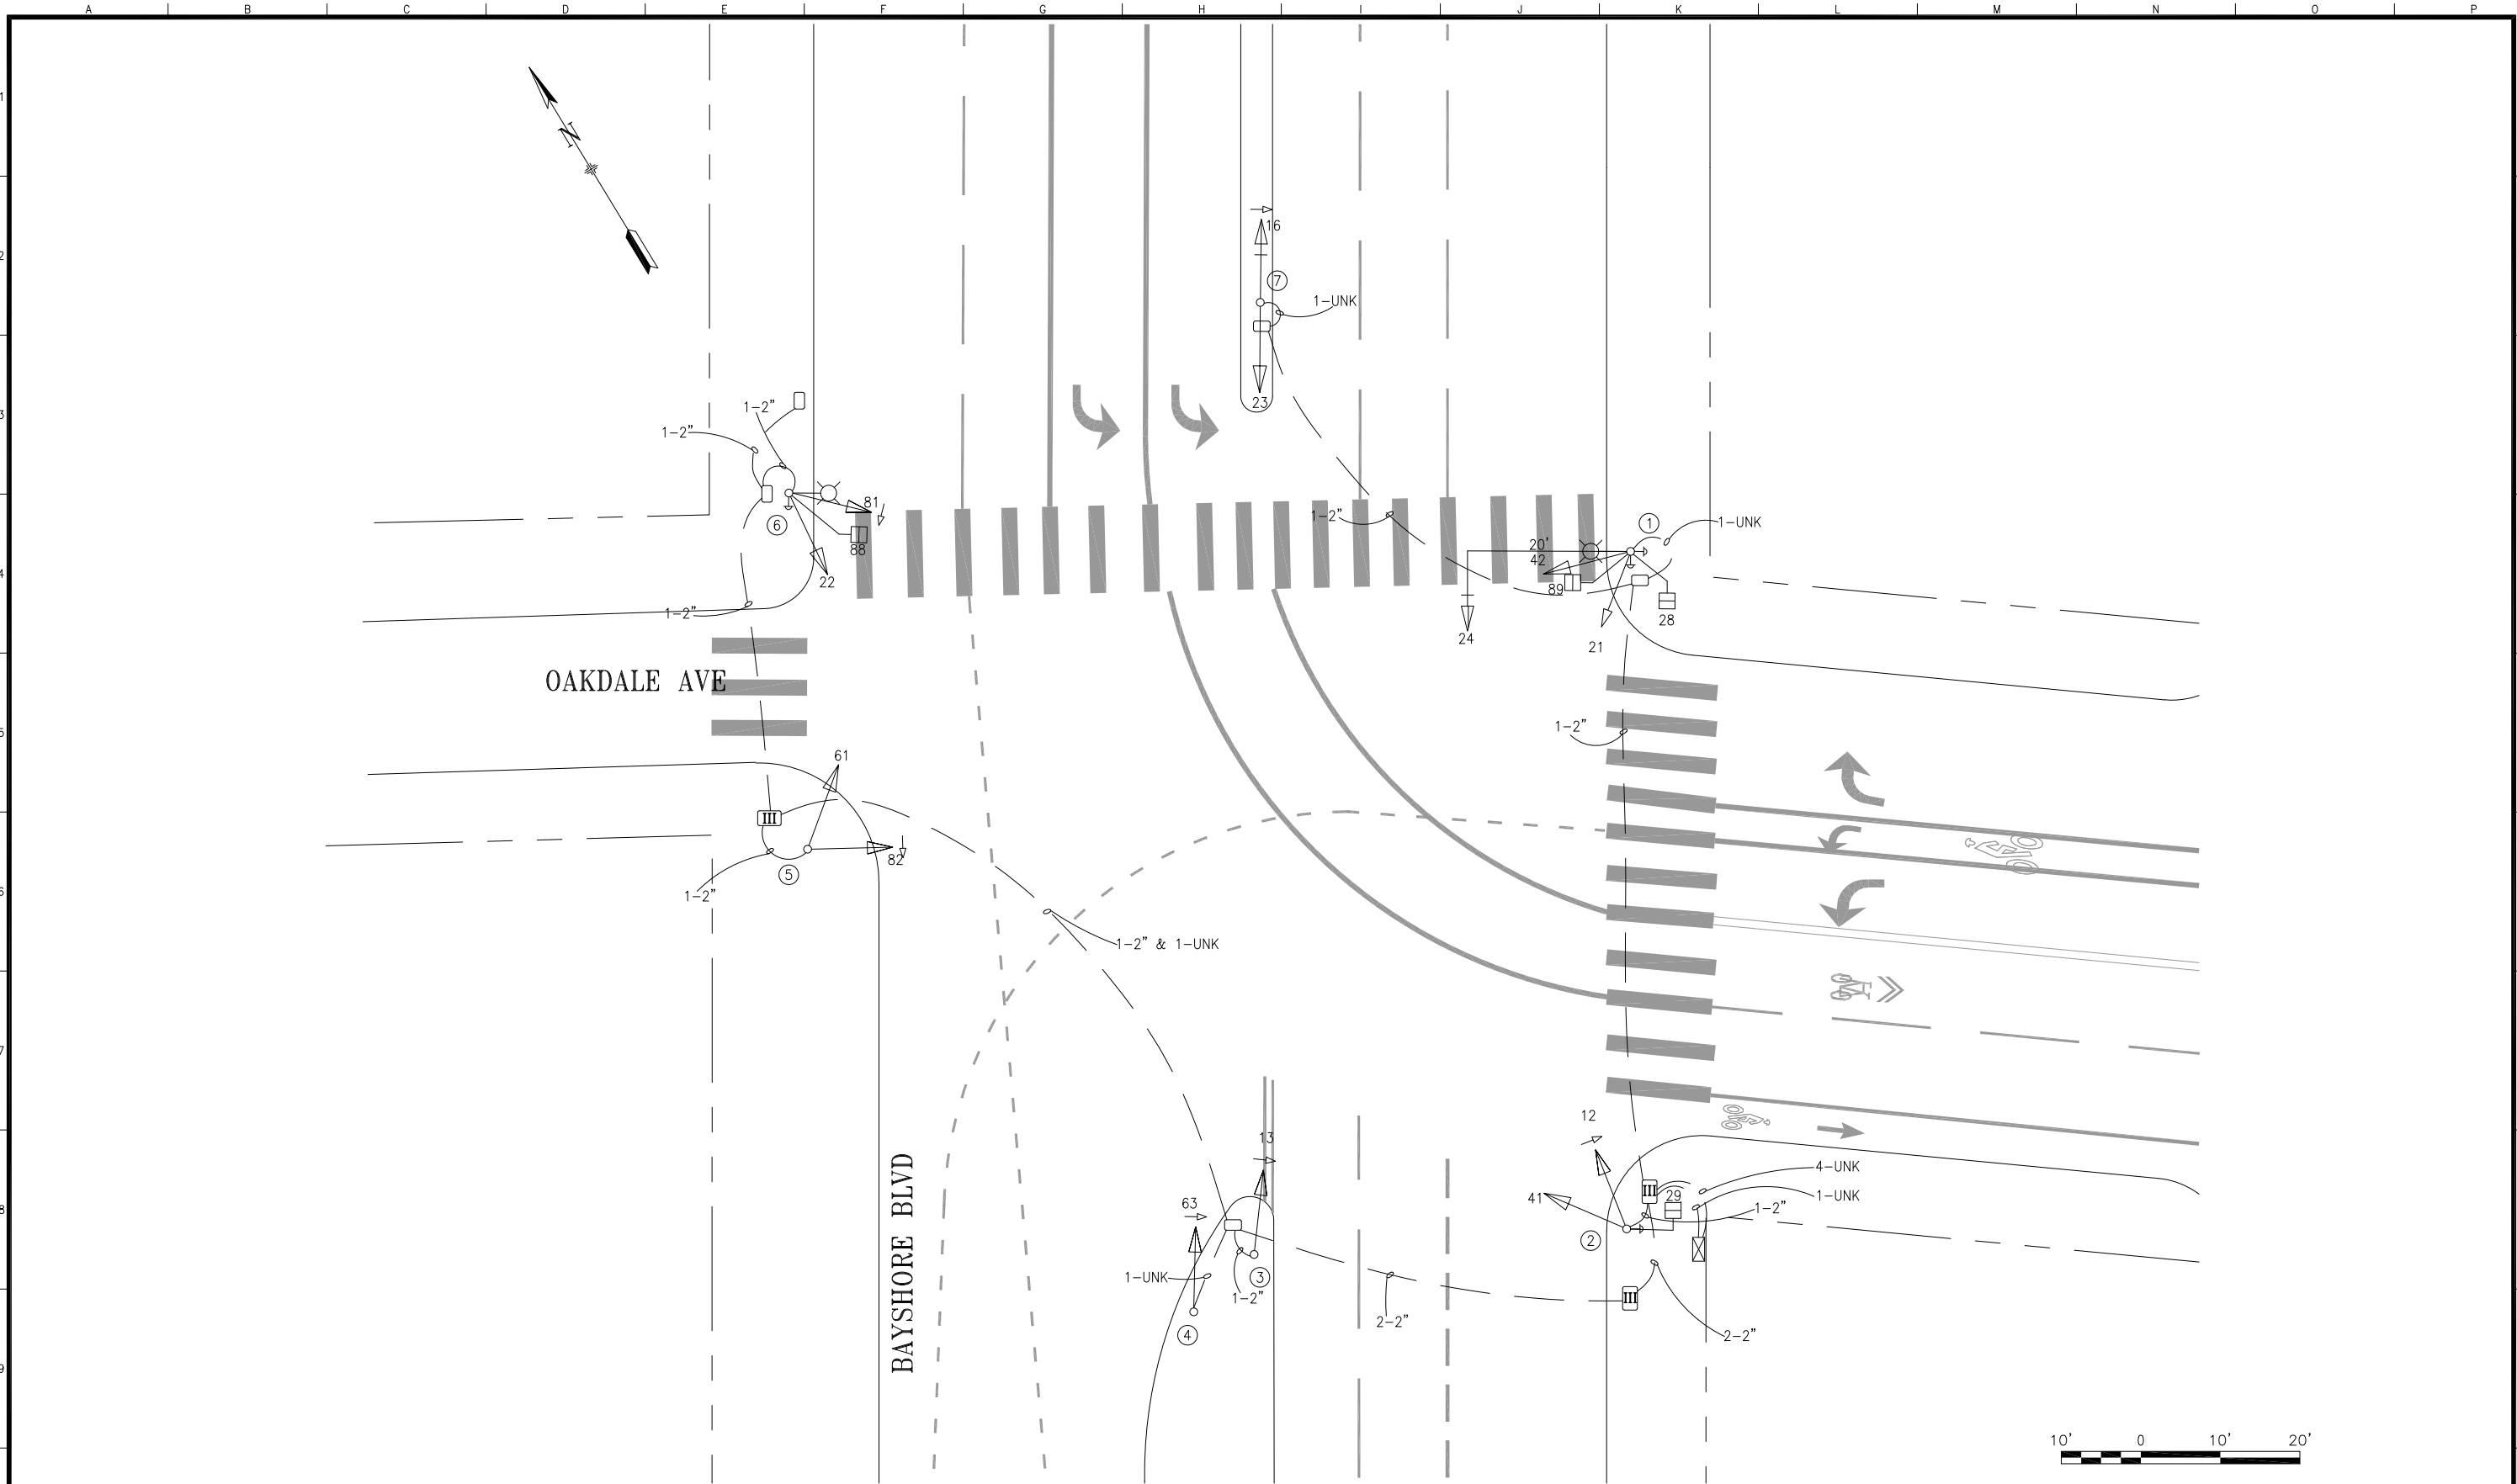


TABLE OF REVISIONS				CHECK WITH TRACING TO SEE IF YOU HAVE LATEST REVISION			
NO.	DATE	DESCRIPTION	BY	APP.			
2	2/28/17	SIG. MOD BY 2577J. CHANGED POLE 5 TO TYPE 1-A (10')	KAS	MV			
1	12/20/16	81&82 REPLACED AS 4512*GLA PER 2016-234; REMOVE LOOPS PER FIELD	JH	ET			
0	8/3/06	UPGRADED BY 1812J; CONVERTED FROM CONTRACT PLANS	JH	ET			

REFERENCE INFORMATION & FILE NO. OF SURVEYS	



SAN FRANCISCO MUNICIPAL TRANSPORTATION AGENCY
CITY AND COUNTY OF SAN FRANCISCO

DRAWN:	DATE:
JH	8/16
CHECKED:	DATE:
ET	8/16

SCALE:
AS SHOWN
SHEET OF SHEETS
1 OF 2

TRAFFIC SIGNAL INVENTORY DIAGRAM
BAYSHORE BLVD & OAKDALE AVE

CNN NO.
20816000
REV NO.
2

POLE AND EQUIPMENT SCHEDULE											
POLE No.	TYPE OF POLE	LUMINAIRE (HPS)	VEHICLE SIGNAL					PEDESTRIAN SIGNAL			REMARKS
		VOLTAGE/ WATTS	No.	TYPE	MOUNTING	VISORS	LOUVERS	No.	TYPE	MOUNTING	
①	17B-1-70 W/20' MAST ARM STREET LIGHT	240/250	24 21 42	3S12" 3S8" 1S12"FR	MAS SV-2-TA	T T		28 89	1S-COUNT 1S-COUNT	SP-1(22") SP-1-SF(12")	BP PPB PPB
②	SIGNAL PEDESTAL		12 41	3S12"LA 1S12"R	TV-2-T-SFA	T T		29	1S-COUNT	SP-1	PPB
③	1 -A (10)		13	3S12"	TV-1-T	T					
④	SIGNAL PEDESTAL		63	3S12"	TV-1-T	T					
⑤	1-A (10')		61 82	3S12" 4S12"GCLA	TV-2-TC	T T					
⑥	STREET LIGHT		22 81	3S12" 4S12"GCLA	SV-2-T-SF	T T		88	1S-COUNT	SP-1	PPB
⑦	1-A (10)		16 23	3S12"LA 3S12"	SV-1 TV-1-T	T T					SV-1 AT 4'

				REFERENCE INFORMATION & FILE NO. OF SURVEYS			SAN FRANCISCO MUNICIPAL TRANSPORTATION AGENCY				SCALE:		TRAFFIC SIGNAL INVENTORY DIAGRAM		CNN NO.		
							CITY AND COUNTY OF SAN FRANCISCO				NONE				26005000		
2		2/28/17		CHANGED POLE 5 TO TYPE 1-A (10'), UPDATED STRIPING			KAS		MV								
1		12/20/16		81&82 REPLACED AS 4S12"GCLA PER 2016-234; REMOVE LOOPS PER FIELD			JH		ET								
0		8/3/06		UPGRADED BY 1812J; CONVERTED FROM CONTRACT PLANS			JH		ET								
NO.		DATE		DESCRIPTION		BY		APP.				SHEET OF SHEETS		REV NO.			
												2 OF 2		BAYSHORE BLVD & OAKDALE AVE			
TABLE OF REVISIONS																2	
CHECK WITH TRACING TO SEE IF YOU HAVE LATEST REVISION																	