

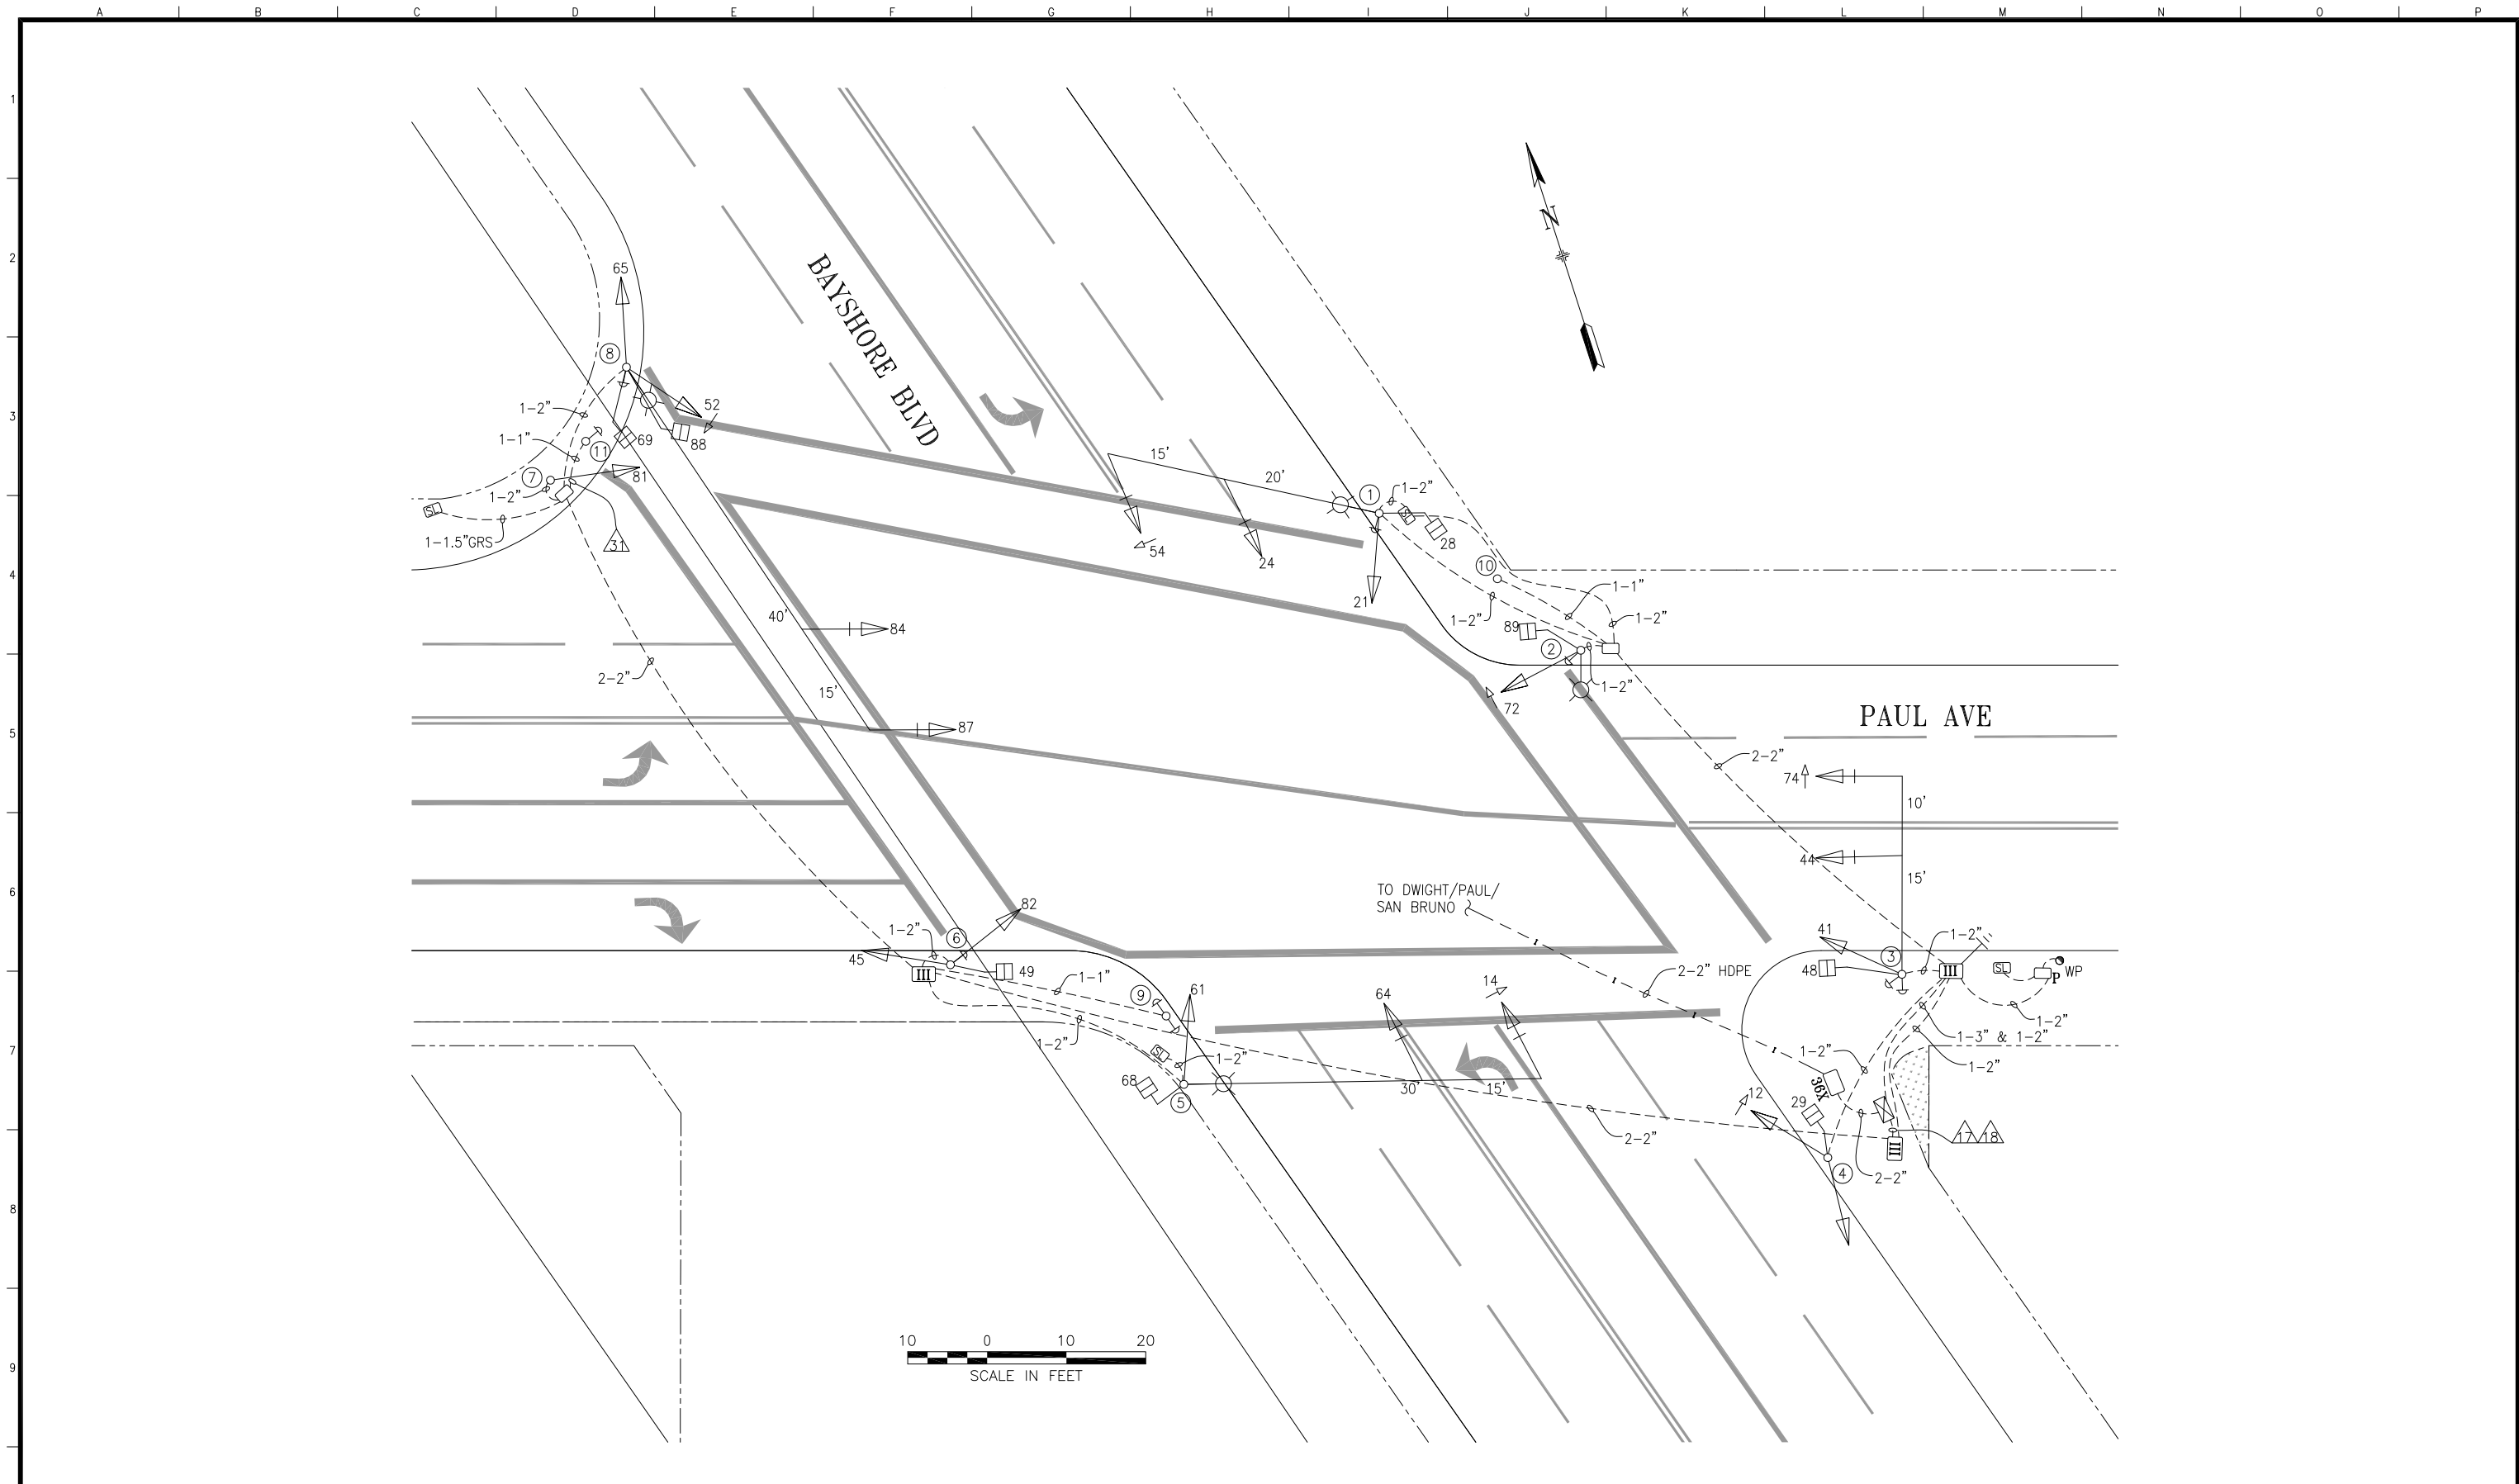


TABLE OF REVISIONS				CHECK WITH TRACING TO SEE IF YOU HAVE LATEST REVISION			
NO.	DATE	DESCRIPTION	BY	APP.			
1	3/25/15	REMOVED 2X PPB POLES AT SE CORNER PER SRC 2015-007	ET	MV			
0	11/20/14	SIGNAL UPGRADE ACTIVATED THROUGH 1993J	JH	GD			

REFERENCE INFORMATION & FILE NO. OF SURVEYS	



SAN FRANCISCO MUNICIPAL TRANSPORTATION AGENCY
CITY AND COUNTY OF SAN FRANCISCO

DRAWN:	DATE:
JH	1/2018
CHECKED:	DATE:
GD	1/2018

SCALE:
AS SHOWN
SHEET OF SHEETS
1 OF 2

TRAFFIC SIGNAL INVENTORY DIAGRAM
BAYSHORE BOULEVARD AND PAUL AVENUE

CNN NO.
20574000
REV NO.
1

