


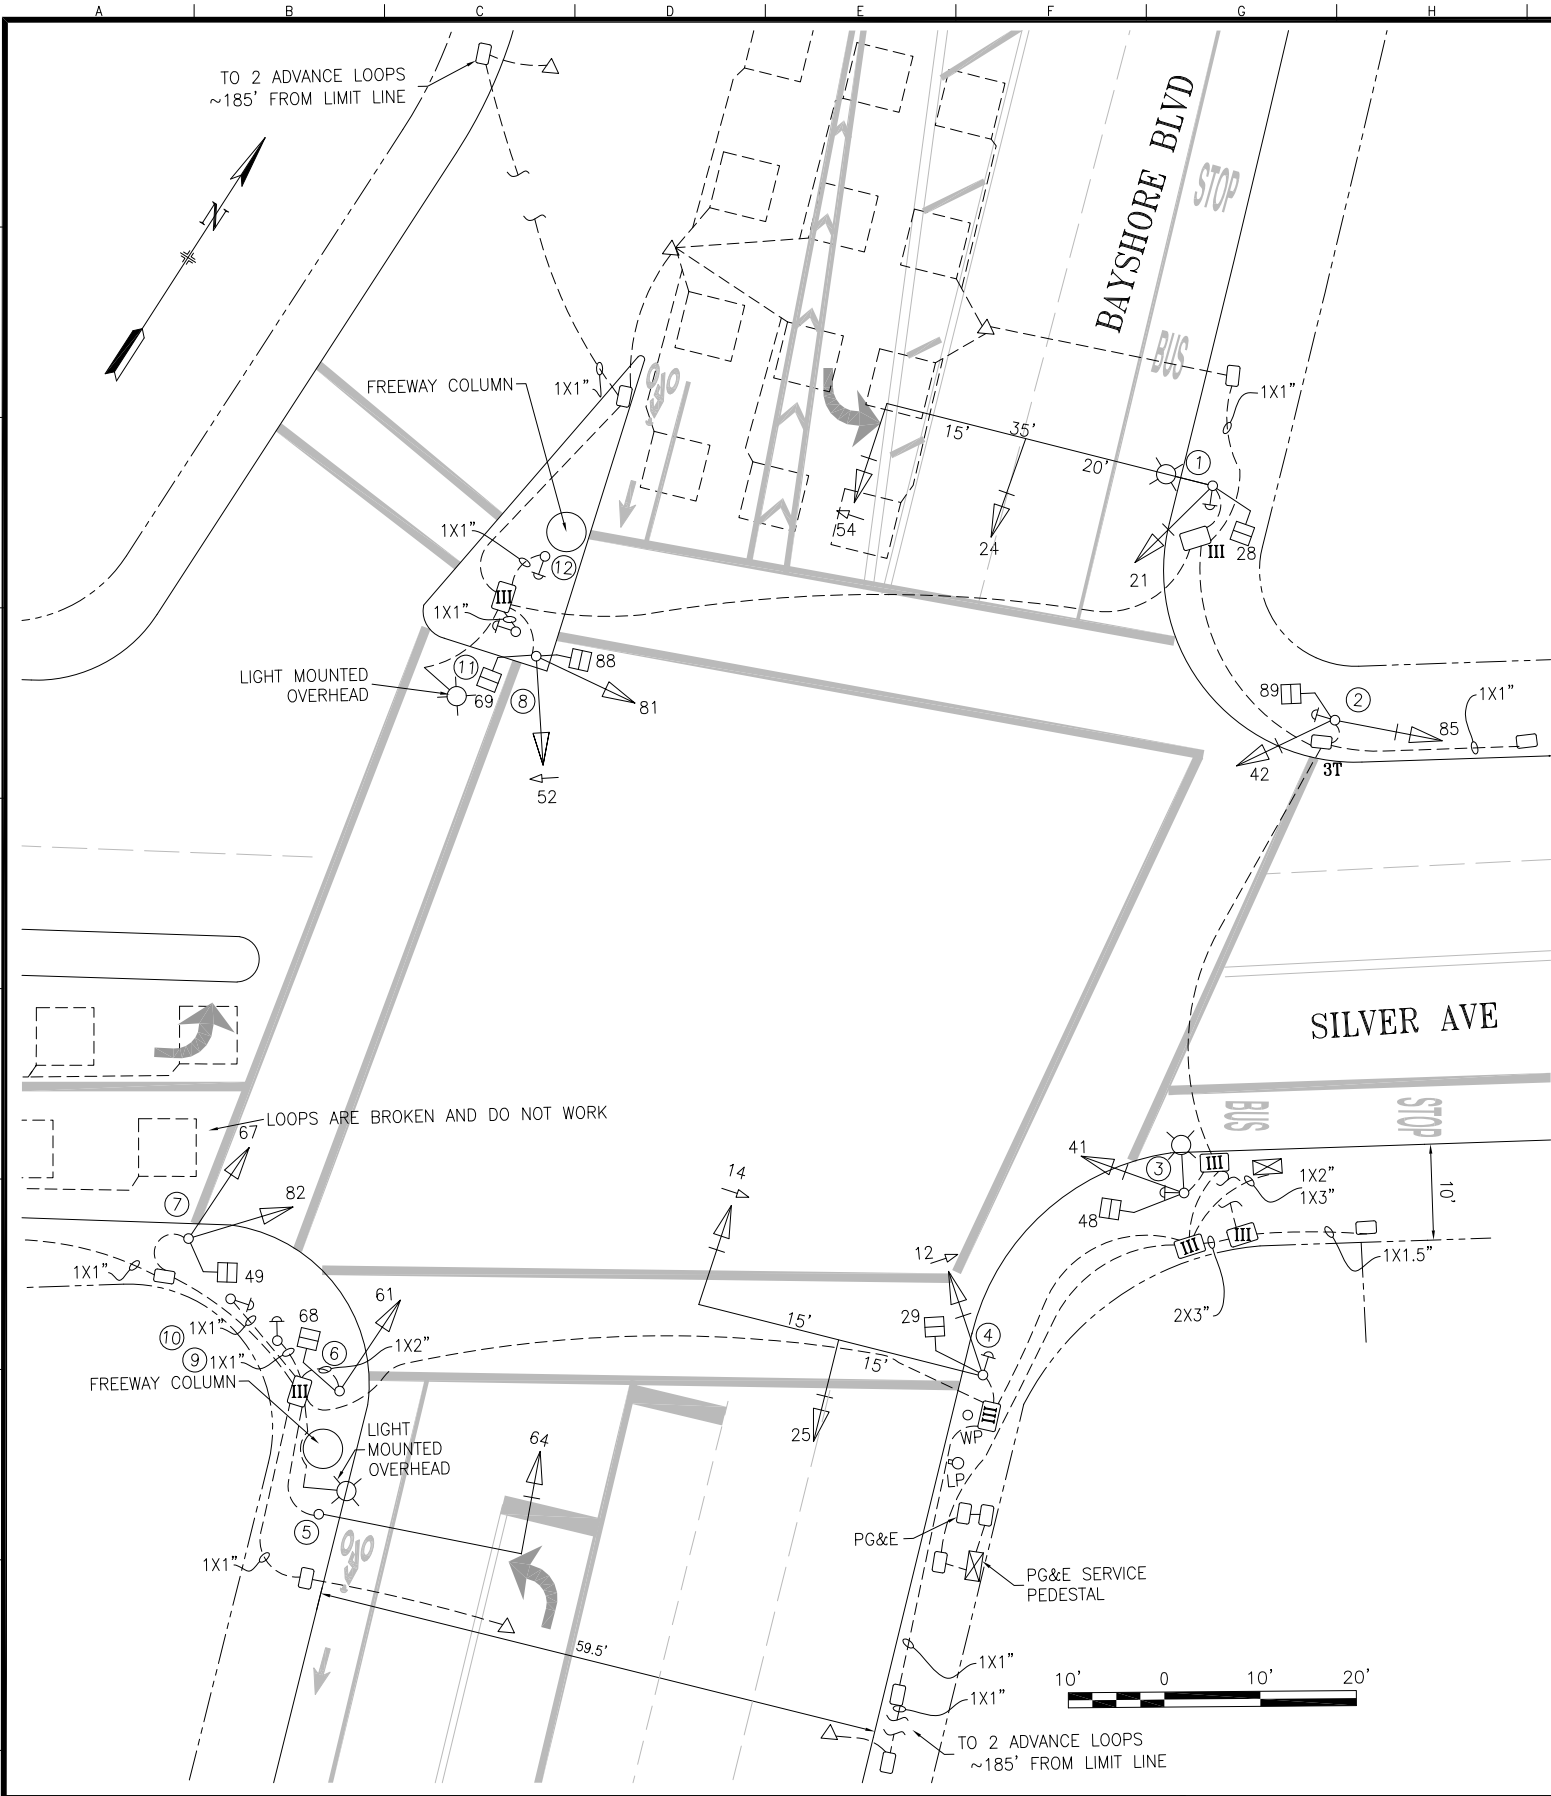

POLE AND EQUIPMENT SCHEDULE											
POLE No.	TYPE OF POLE	LUMINAIRE WATTAGE/ VOLTAGE	VEHICLE SIGNAL					PEDESTRIAN SIGNAL			REMARKS
			No.	TYPE	MOUNTING	VISORS	LOUVERS	No.	TYPE	MOUNTING	
①	24-3-100 W/ 35' MAST ARM, 15' LUMINAIRE ARM, AND LUMINAIRE	200W HPS	21 24 54	3S12" 3S12" 3S12"LA	SV-1-T MAS MAS	T T T		28	1S-COUNT	SP-1-T	BACKPLATE APS-2W BACKPLATE BACKPLATE WIRELESS SENSOR
②	1-B (10')		42 85	3S12" 3S12"	TV-2-T	T T		89	1S-COUNT	SP-1-T	BACKPLATE BACKPLATE APS-2W
③	STREETLIGHT	200W HPS	41	3S12"	SV-1-T	FC		48	1S-COUNT	SP-1-T	BACKPLATE APS-2W
④	18-3-100 W/ 30' MAST ARM		12 14 25	3S12"LA 3S12"LA 3S12"	SV-1-T MAS MAS	T T T		29	1S-COUNT	SP-1	BACKPLATE BACKPLATE BACKPLATE APS-2W WIRELESS TSP EQUIPMENT SENSOR
⑤	16-1-70 W/ 20' MAST ARM		64	3S12"	MAS	T					BACKPLATE
⑥	1-A (10')		61	3S12"	TV-1-T	T		68	1S-COUNT	SP-1	
⑦	1-A (10') ON 1-B ADAPTER PLATE		82 67	3S12" 3S12"	TV-2-T-SFA	T T		49	1S-COUNT	SP-1	
⑧	1-A (10')		52 81	3S12"LA 3S12"	TV-2-T-SFA	T T		69 88	1S-COUNT 1S-COUNT	SP-1 SP-1	
⑨	PPB POST										APS-2W
⑩	PPB POST										APS-2W
⑪	PPB POST										APS-2W
⑫	PPB POST										APS-2W

- NOTES:
1. CABINET FOUNDATION TYPE: M-SF.
2. CABINET TYPE : M-SF
3. SIGNALS WERE SWITCHED OVER ON 5/7/08

NO.	DATE	DESCRIPTION	BY	APPROVED
3	2/23/22	NEW APS & 4 PPB POSTS PER 2021-2026 & CALTRANS PROJECT. PER FIELD REMO BP (61). ADD DAMAGED EB SILVER LOOP NOTE.	DYeung	GdeLeon
2	10/22/21	UPDATE PER FIELD: RELOCATE 28 TO POLE 1 AND REMOVE POLE 9. BACKPLATES: NONE FOR 61 AND ADD FOR 21.	DYeung	GdeLeon
1	6/21/11	SIGNAL UPGRADE: ADD PROT. NBT & SBT, NEW POLES 1, 4 & 9, LARGER 12" SIGNALS FOR 42 & 85. NEW CABINET & FOUNDATION	DYeung	CHui
0	5/8/08	SIGNALS TRANSFERRED TO CITY FROM CALTRANS (NEW HOMERUNS, CONTROLLER, CABINET, PPB AND COUNTDOWNS)	DYeung	RJindal
NO.	DATE	DESCRIPTION	BY	APPROVED

TABLE OF REVISIONS
CHECKOUT DRAWING THROUGH THE SID CUSTODIAN FOR THE LATEST REVISION



SFMTA

DRAWN BY: DY	DATE: 05/08
CHECKED BY: RJ	DATE: 05/08

SCALE 1" = 10'
SHEET OF SHEETS 1 OF 1

TRAFFIC SIGNAL INVENTORY DIAGRAM	CNN NO: 20770000
BAYSHORE BLVD AND SILVER AVE	REV NO: 3