


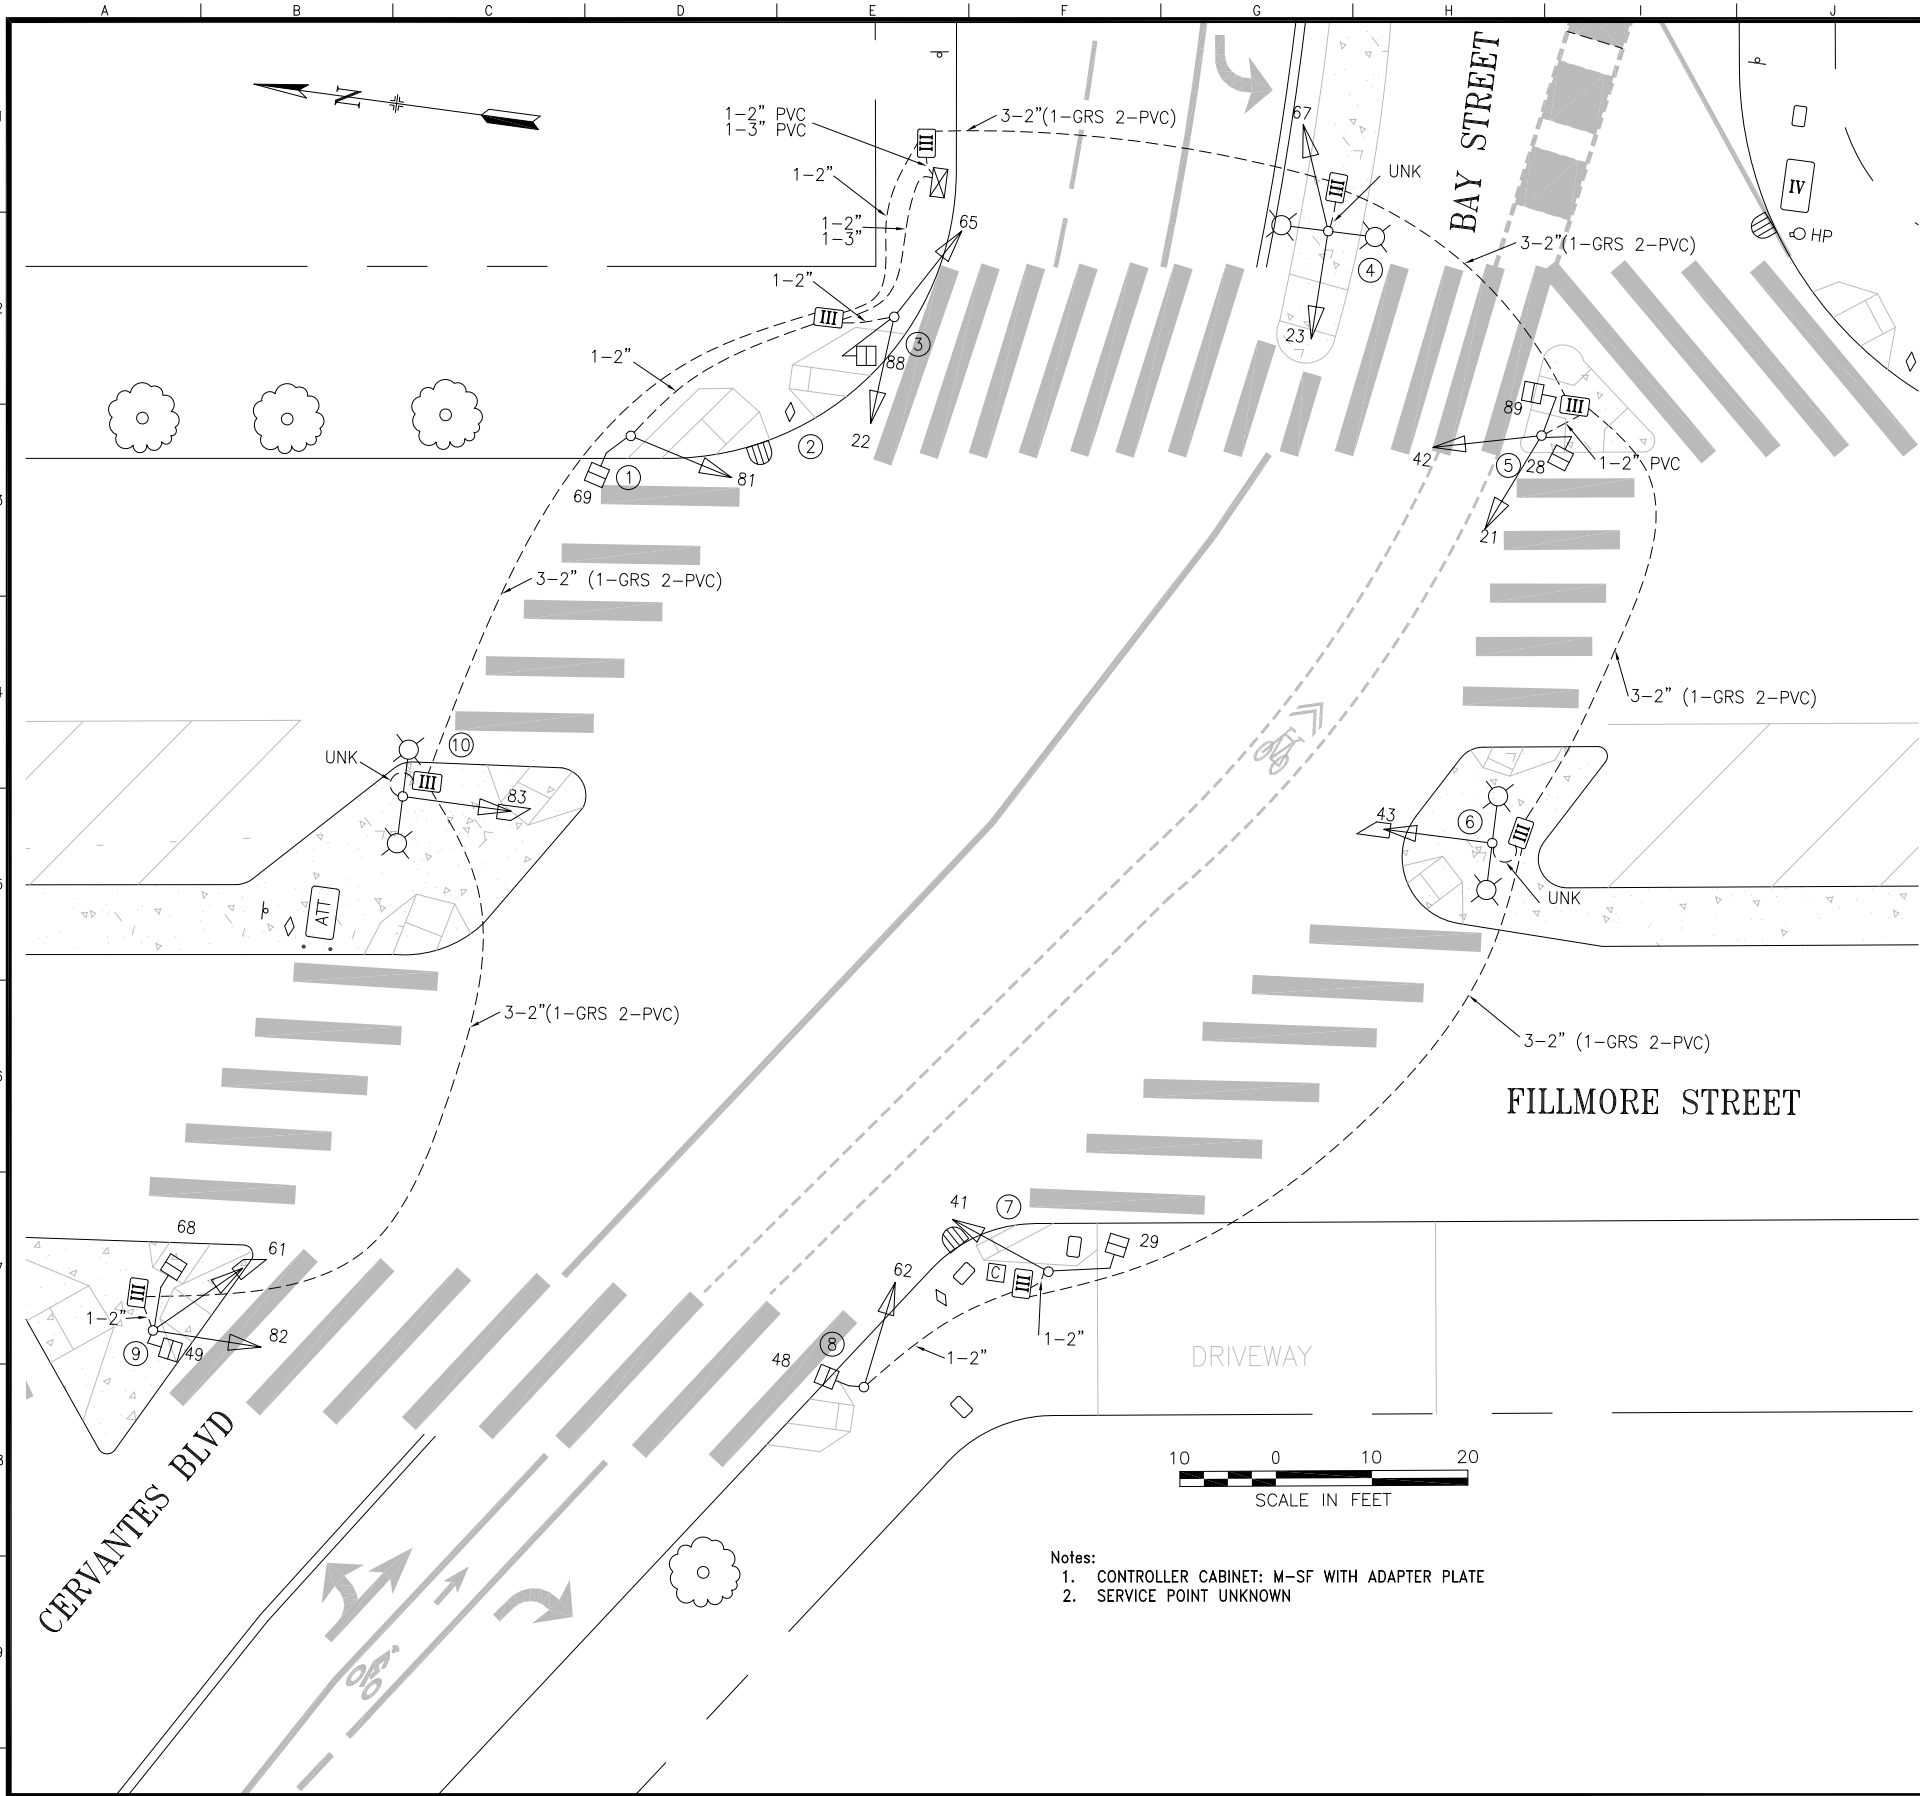

POLE AND EQUIPMENT SCHEDULE									
POLE No.	TYPE OF POLE	VEHICLE SIGNAL				PEDESTRIAN SIGNAL			REMARKS
		No.	TYPE	MOUNTING	VISORS	No.	TYPE	MOUNTING	
①	1-A (10')	81	3S12"	TV-1-T	T	69	1S-C	SP-1	
②	MUNI POLE								
③	1-A (13')	22 65	3S12" 3S12"	TV-2-T-SFA	T T	88	1S-C	SP-1	
④	SL	23 67	3S12" 3S12"	SV-1 SV-1	T T				
⑤	1-A (10')	21 42	3S12" 3S12"	TV-2-T-SFA	T T	28 89	1S-C 1S-C	SP-1 SP-1	VERT LOUVERS ON 21 & 42
⑥	SL	43	3S12"	SV-1	LEFT ANGLE				
⑦	1-A (10')	41	3S12"	TV-1-T	T	29	1S-C	SP-1	
⑧	1-A (10')	62	3S12"	TV-1-T	T	48	1S-C	SP-1	
⑨	1-A (10')	61 82	3S12" 3S12"	TV-2-T-SFA	RIGHT ANGLE T	49 68	1S-C 1S-C	SP-1 SP-1	VERT LOUVERS ON 82
⑩	SL	83	3S12"	SV-1	LEFT ANGLE				

- Notes:
1. CONTROLLER CABINET: M-SF WITH ADAPTER PLATE
 2. SERVICE POINT UNKNOWN

<table><tr><td></td><td></td><td></td><td></td></tr><tr><td>1</td><td>7/19/17</td><td>ANGLE VISORS: 43, 61, 83. VERT LOUVERS: 21, 42, 82-SRC 2017-188</td><td>DY GD</td></tr><tr><td>0</td><td>3/22/17</td><td>RELOC TO 1-As. ADD #67 & PCS. REMO PV43-SRC 2016-298</td><td>DY GD</td></tr><tr><td>NO.</td><td>DATE</td><td>DESCRIPTION</td><td>BY APP.</td></tr></table>								1	7/19/17	ANGLE VISORS: 43, 61, 83. VERT LOUVERS: 21, 42, 82-SRC 2017-188	DY GD	0	3/22/17	RELOC TO 1-As. ADD #67 & PCS. REMO PV43-SRC 2016-298	DY GD	NO.	DATE	DESCRIPTION	BY APP.	REFERENCE INFORMATION & FILE NO. OF SURVEYS	 SAN FRANCISCO MUNICIPAL TRANSPORTATION AGENCY CITY AND COUNTY OF SAN FRANCISCO	DRAWN: DATE: DYeung 6/8/17	SCALE: AS SHOWN SHEET OF SHEETS 1 OF 1	TRAFFIC SIGNAL INVENTORY DIAGRAM BAY ST, CERVANTES BLVD, AND FILLMORE ST	CNN NO. 26764000
1	7/19/17	ANGLE VISORS: 43, 61, 83. VERT LOUVERS: 21, 42, 82-SRC 2017-188	DY GD																						
0	3/22/17	RELOC TO 1-As. ADD #67 & PCS. REMO PV43-SRC 2016-298	DY GD																						
NO.	DATE	DESCRIPTION	BY APP.																						
TABLE OF REVISIONS CHECK WITH TRACING TO SEE IF YOU HAVE LATEST REVISION		CHECKED: DATE: GDeLeon 6/19/17	REV NO.																						
			1																						