


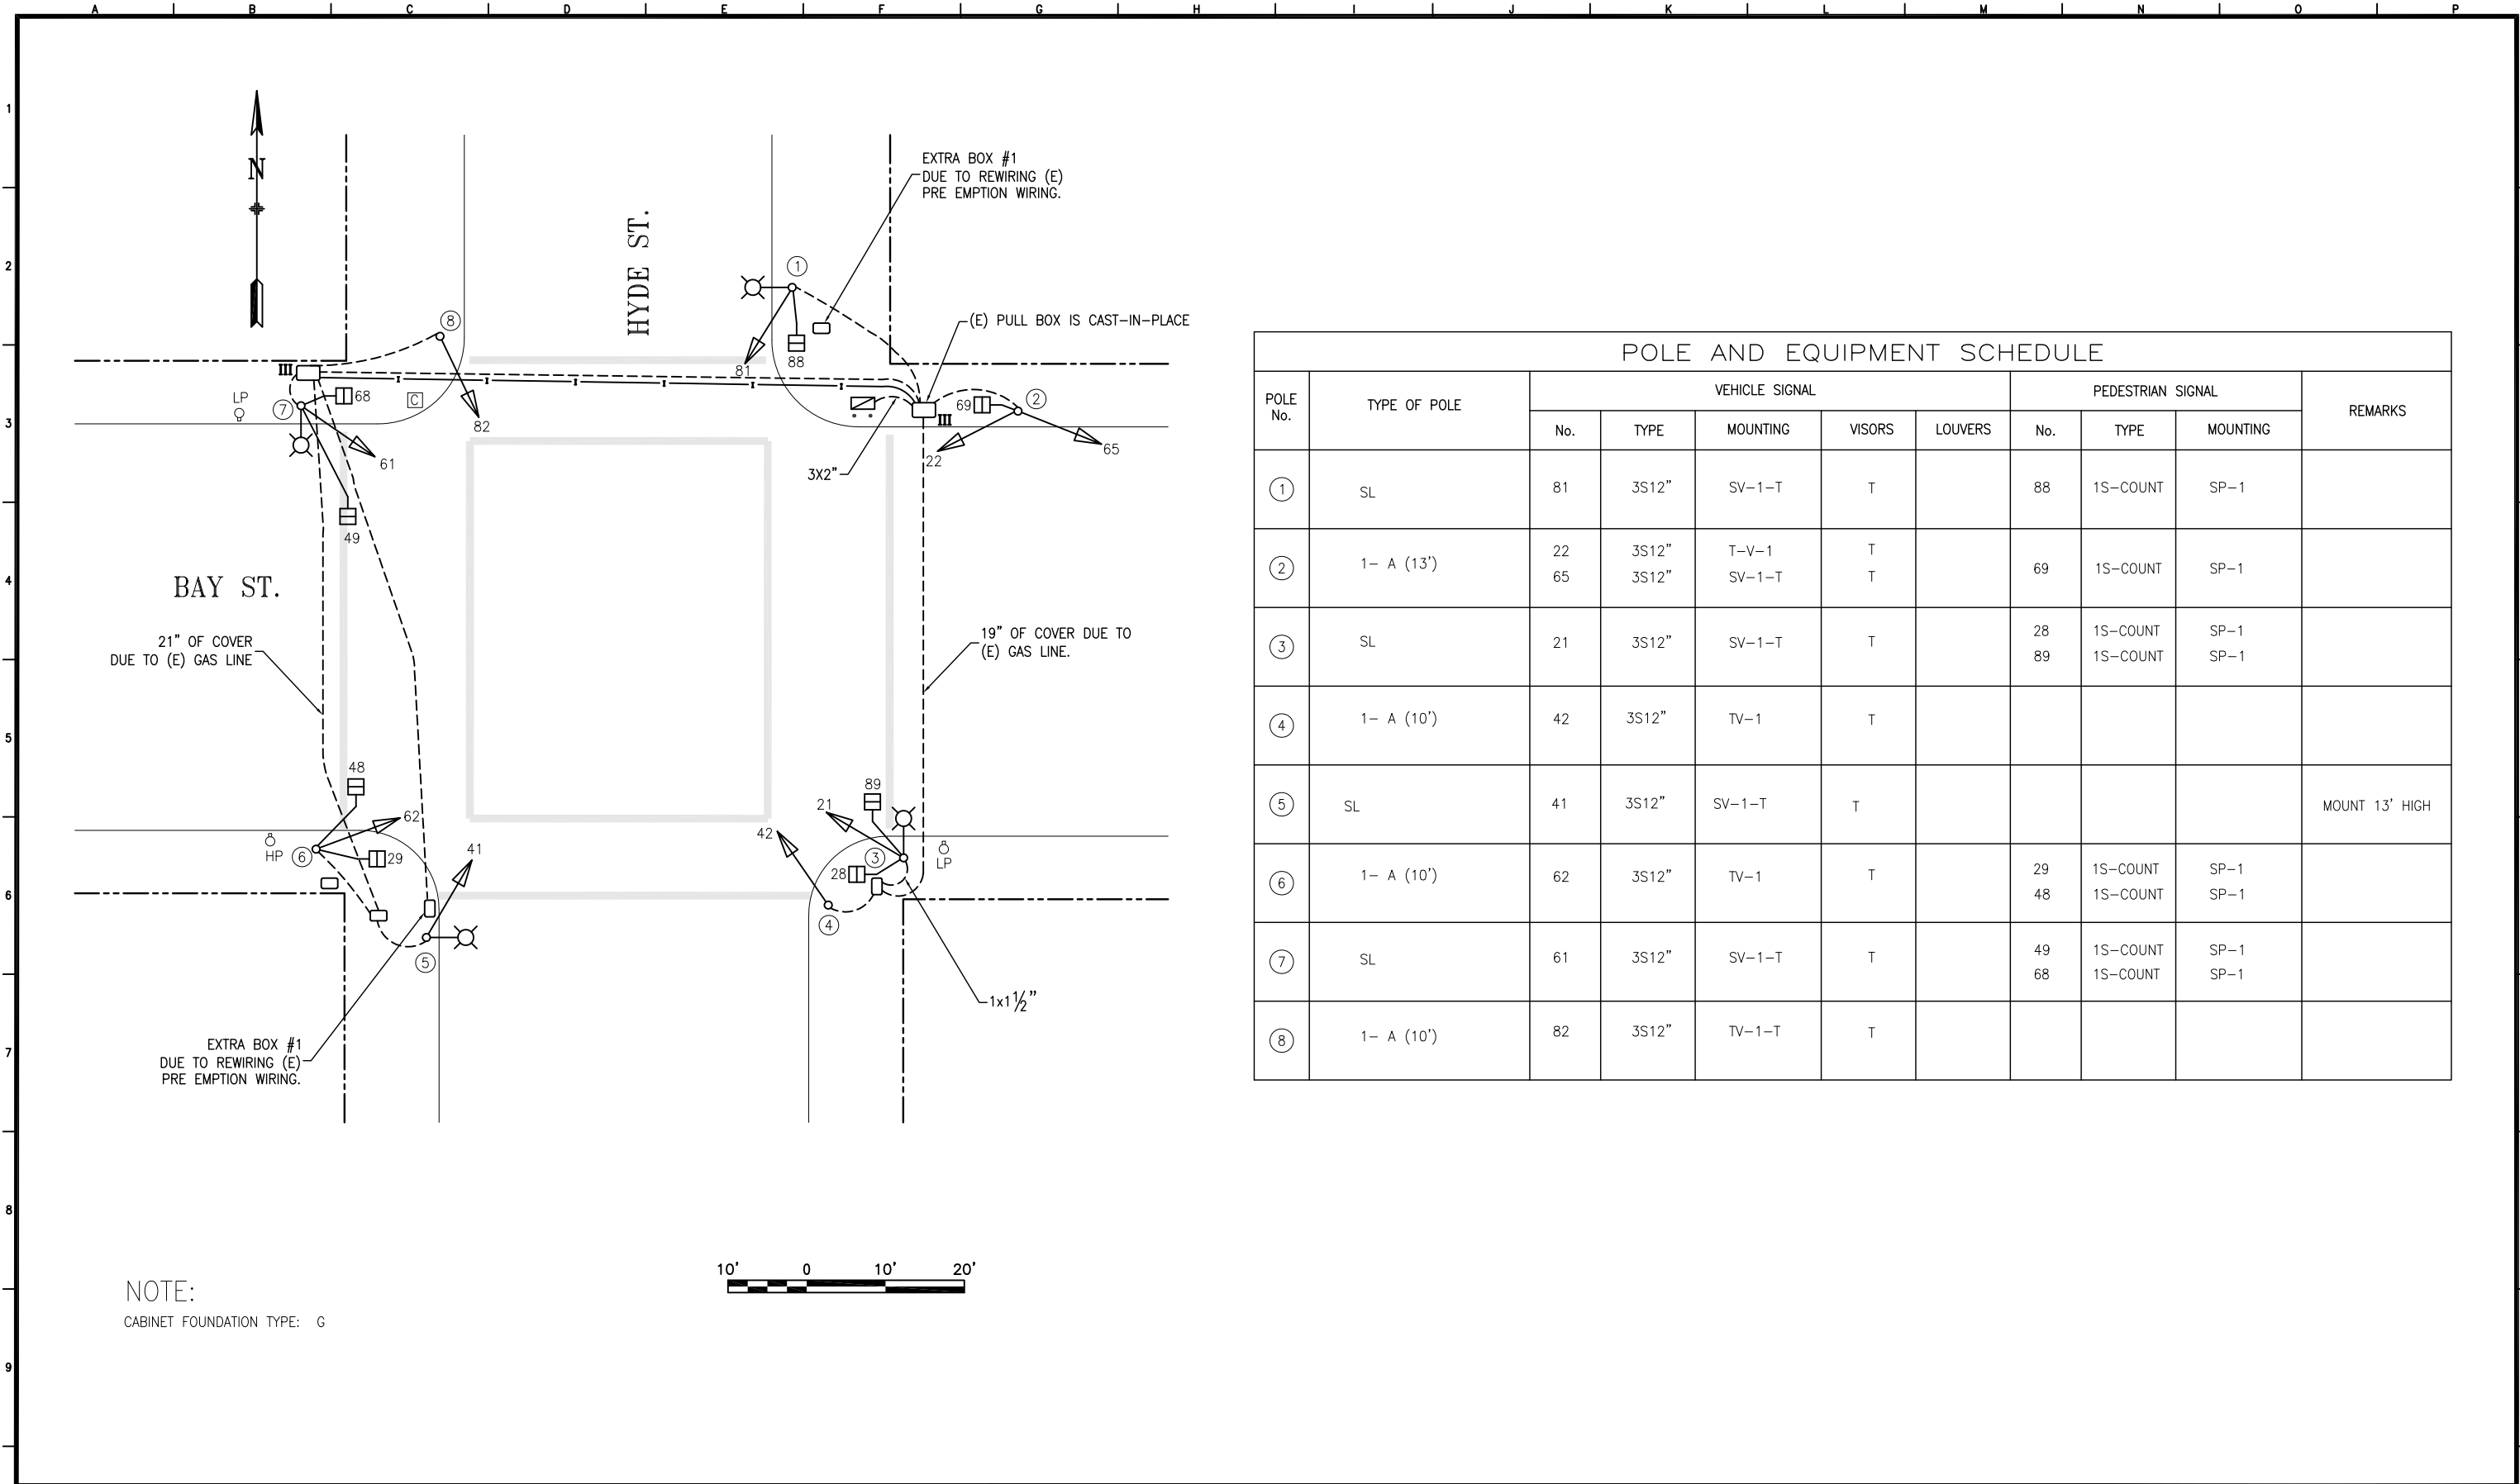

POLE AND EQUIPMENT SCHEDULE										
POLE No.	TYPE OF POLE	VEHICLE SIGNAL					PEDESTRIAN SIGNAL			REMARKS
		No.	TYPE	MOUNTING	VISORS	LOUVERS	No.	TYPE	MOUNTING	
①	SL	81	3S12"	SV-1-T	T		88	1S-COUNT	SP-1	
②	1- A (13')	22 65	3S12" 3S12"	T-V-1 SV-1-T	T T		69	1S-COUNT	SP-1	
③	SL	21	3S12"	SV-1-T	T		28 89	1S-COUNT 1S-COUNT	SP-1 SP-1	
④	1- A (10')	42	3S12"	TV-1	T					
⑤	SL	41	3S12"	SV-1-T	T					MOUNT 13' HIGH
⑥	1- A (10')	62	3S12"	TV-1	T		29 48	1S-COUNT 1S-COUNT	SP-1 SP-1	
⑦	SL	61	3S12"	SV-1-T	T		49 68	1S-COUNT 1S-COUNT	SP-1 SP-1	
⑧	1- A (10')	82	3S12"	TV-1-T	T					

4	10/07/22	SRC 2022-101: UPGRADED 22, 62, 65, AND 81 TO 3S12".	E.TANG	E.TSUI
		PER FIELD, UPDATED 82 TO 3S12" TV-1-T.		
3	08/31/21	UPGRADED 41 AND 42 TO 3S12" & RAISED	A.LAM	E.TSUI
		41 TO 13' HIGH. PER FIELD, UPDATED		
		48,49,88,89 TO 1S-COUNT		
2	04/18/12	ADD SIGNALS 28,29,68,69 PER SRC 10-182	E.TSUI	H.QUAN
NO.	DATE	DESCRIPTION	BY	APPROVED
TABLE OF REVISIONS				
CHECKOUT DRAWING THROUGH THE SID CUSTODIAN FOR THE LATEST REVISION				



SFMTA

DRAWN BY:	DATE:
DVC	8/29/01
CHECKED BY:	DATE:

SCALE
AS SHOWN
SHEET OF SHEETS
1 OF 1

TRAFFIC SIGNAL INVENTORY DIAGRAM	CNN NO: 25577000
BAY ST & HYDE ST	REV NO: