


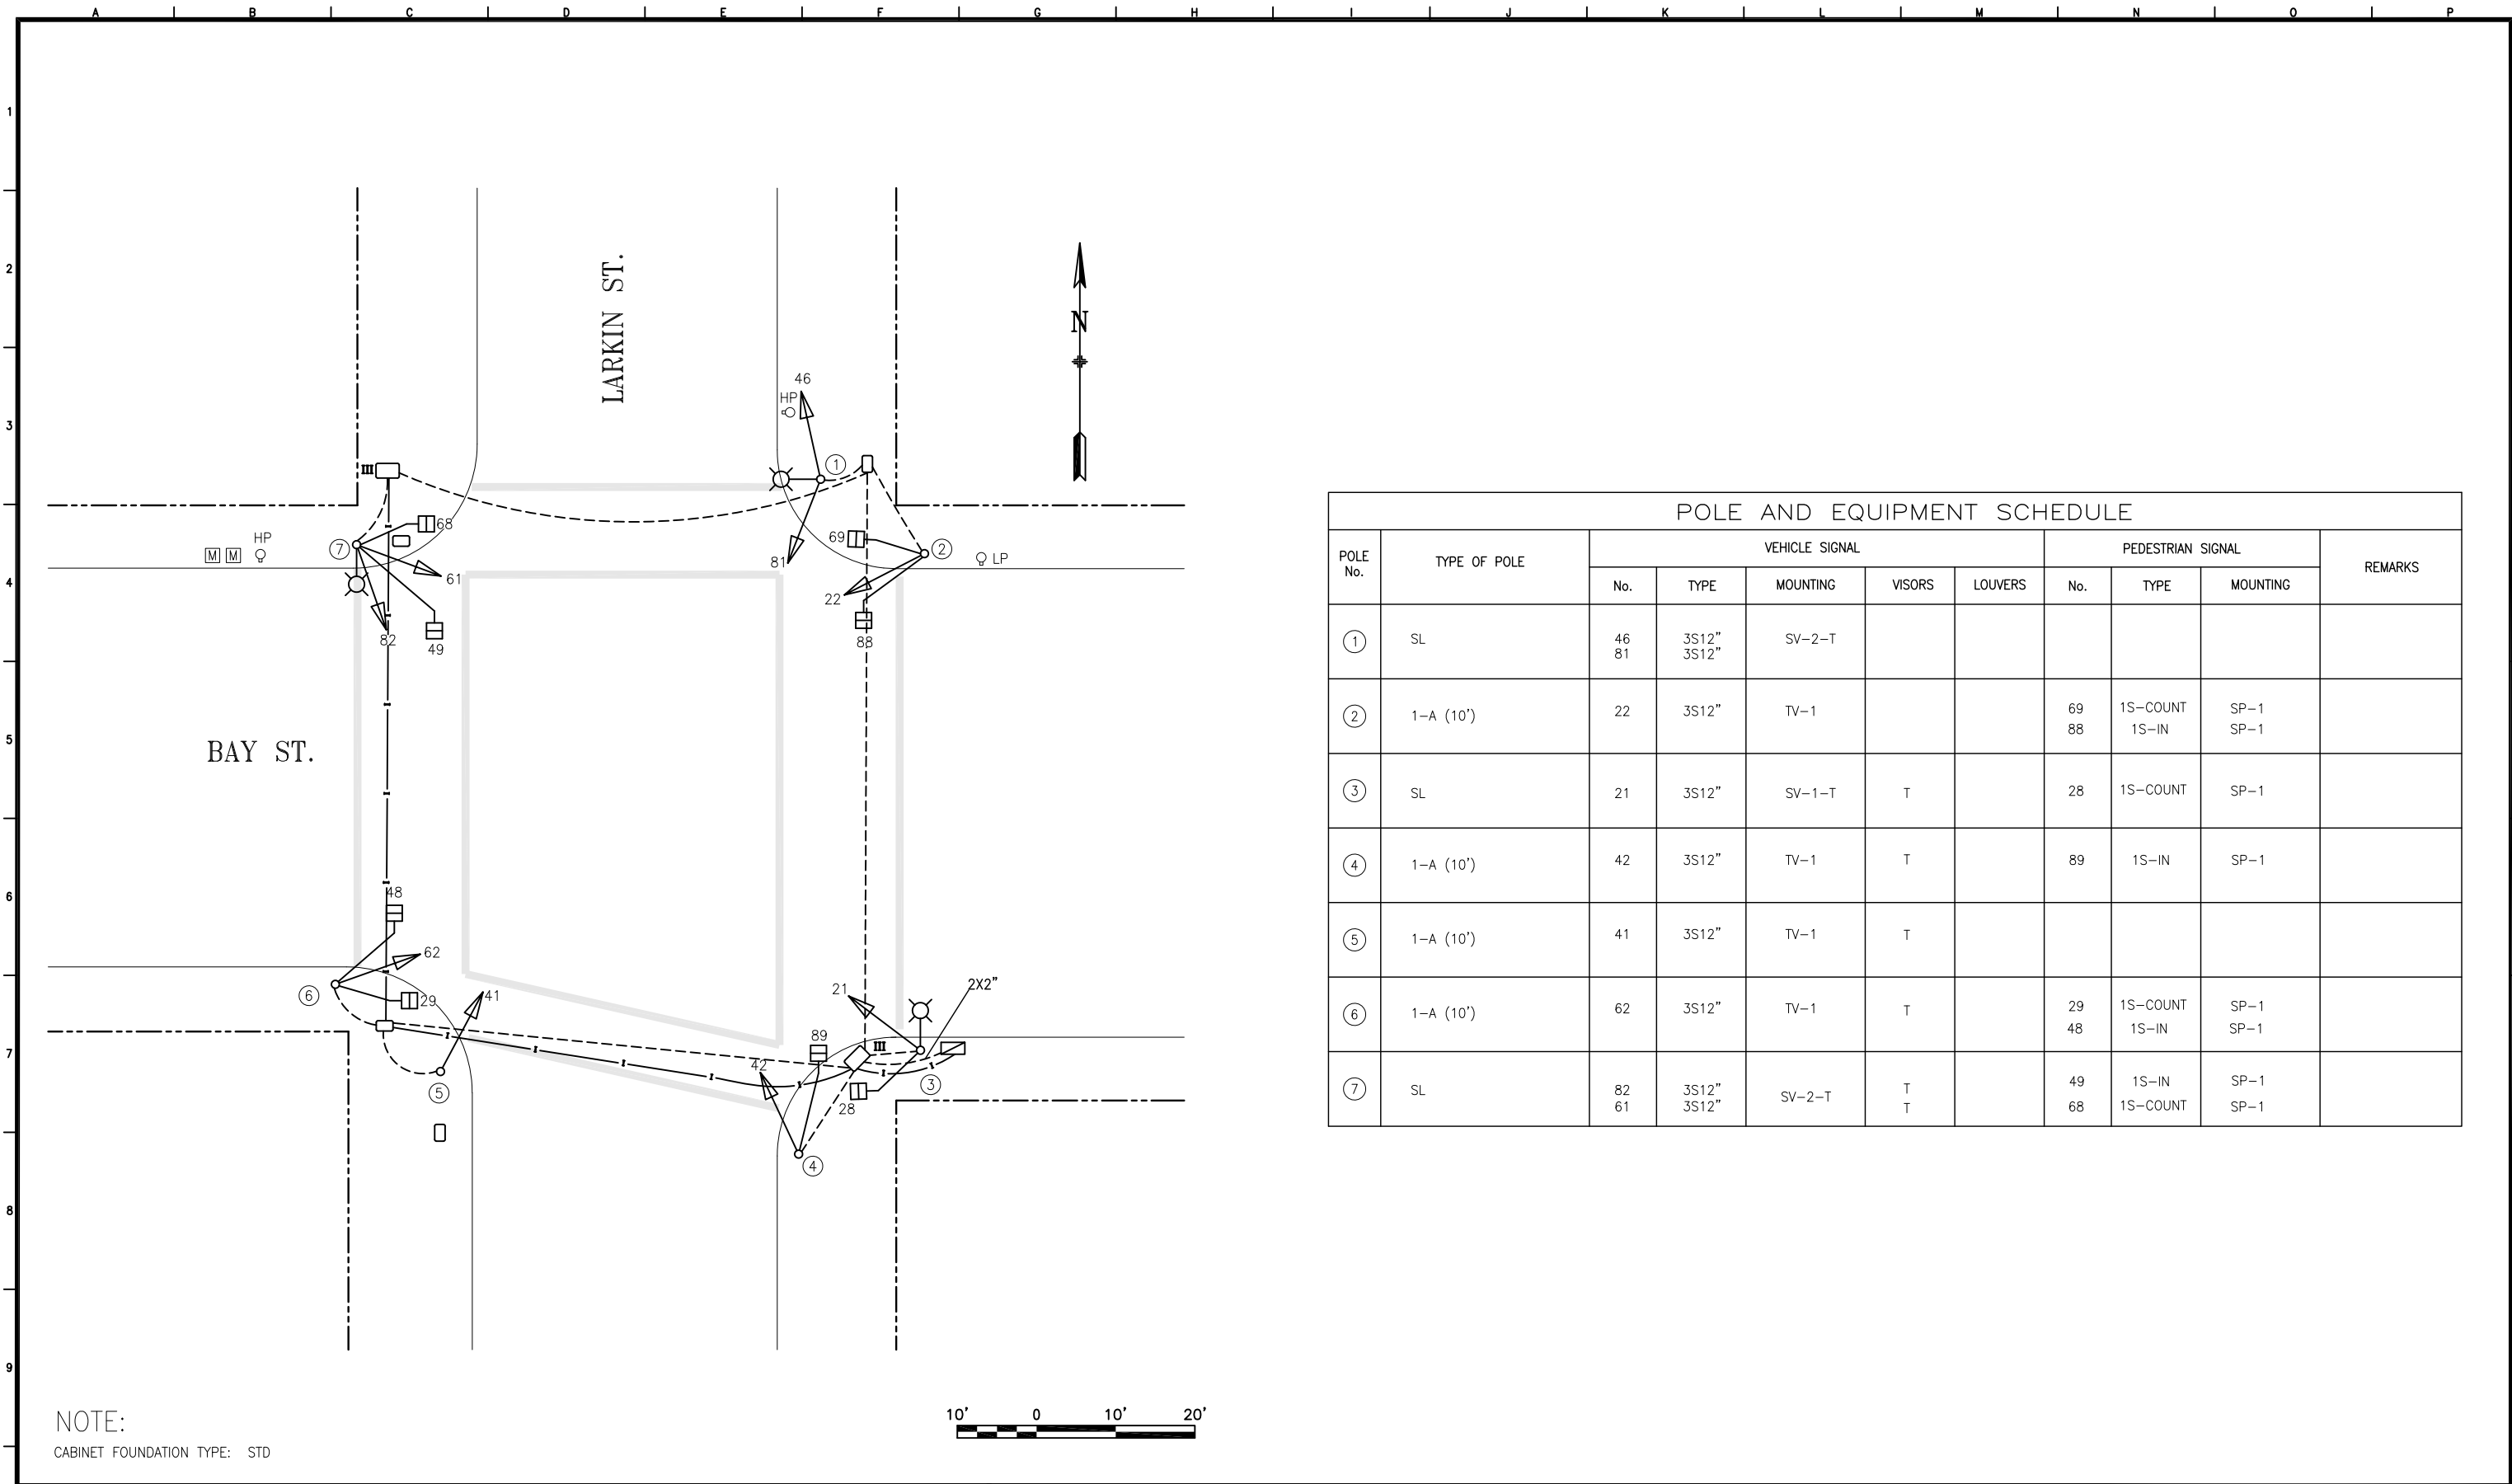

NOTE:
CABINET FOUNDATION TYPE: STD

POLE AND EQUIPMENT SCHEDULE									
POLE No.	TYPE OF POLE	VEHICLE SIGNAL					PEDESTRIAN SIGNAL		
		No.	TYPE	MOUNTING	VISORS	LOUVERS	No.	TYPE	MOUNTING
①	SL	46 81	3S12" 3S12"	SV-2-T					
②	1-A (10')	22	3S12"	TV-1			69 88	1S-COUNT 1S-IN	SP-1 SP-1
③	SL	21	3S12"	SV-1-T	T		28	1S-COUNT	SP-1
④	1-A (10')	42	3S12"	TV-1	T		89	1S-IN	SP-1
⑤	1-A (10')	41	3S12"	TV-1	T				
⑥	1-A (10')	62	3S12"	TV-1	T		29 48	1S-COUNT 1S-IN	SP-1 SP-1
⑦	SL	82 61	3S12" 3S12"	SV-2-T	T T		49 68	1S-IN 1S-COUNT	SP-1 SP-1

2	10/07/22	SRC 2022-101: UPGRADED ALL SIGNALS TO 3S12".	E.TANG	E.TSUI
1	08/11/11	SRC 2010-081: INSTALL PED SIGNALS 28, 29, 68, & 69	E.TSUI	B.DUSSEAUT
0	07/xx/97	BAY AND NORTH POINT PROJECT JOB# 1094 N	DVC	RO
NO.	DATE	DESCRIPTION	BY	APPROVED

TABLE OF REVISIONS
CHECKOUT DRAWING THROUGH THE SID CUSTODIAN FOR THE LATEST REVISION



SFMTA

DRAWN BY: DVC	DATE: 08/29/01
CHECKED BY:	DATE:

SCALE AS SHOWN	TRAFFIC SIGNAL INVENTORY DIAGRAM	CNN NO: 25583000
SHEET OF SHEETS 01 OF 01		BAY ST & LARKIN ST

REV NO: 2
