




| POLE AND EQUIPMENT SCHEDULE |                            |                                                                                     |                |                |            |        |            |                   |                      |                             |                  |
|-----------------------------|----------------------------|-------------------------------------------------------------------------------------|----------------|----------------|------------|--------|------------|-------------------|----------------------|-----------------------------|------------------|
| POLE No.                    | TYPE OF POLE               | LUMINAIRE TYPE                                                                      | VEHICLE SIGNAL |                |            |        |            | PEDESTRIAN SIGNAL |                      |                             | REMARKS          |
|                             |                            |                                                                                     | No.            | TYPE           | MOUNTING   | VISORS | LOUVERS/BP | No.               | TYPE                 | MOUNTING                    |                  |
| ①                           | WOOD POLE                  |                                                                                     | 81             | 3S12"          | SV-1       | T      |            |                   |                      |                             | EXTERNAL CONDUIT |
| ②                           | 1-A (10')                  |                                                                                     | 22<br>65       | 3S12"<br>3S12" | TV-2-T-SFA | T<br>T |            | 69<br>88          | 1S-COUNT<br>1S-COUNT | SP-1<br>SP-1                |                  |
| ③                           | 1-A (10')                  |                                                                                     | 21             | 3S12"          | TV-1-T     | T      |            | 28<br>89          | 1S-COUNT<br>1S-COUNT | SP-1<br>SP-1                |                  |
| ④                           | 1-A (10')                  |                                                                                     | 42             | 3S12"          | TV-1-T     | T      |            |                   |                      |                             |                  |
| ⑤                           | CITY STANDARD STREET LIGHT |  | 41             | 3S12"          | SV-1-T     | T      |            | 48                | 1S-COUNT             | SP-1                        |                  |
| ⑥                           | 1-A (13')                  |                                                                                     | 62             | 3S12"          | TV-1-T     | T      |            | 29                | 1S-COUNT             | SP-1                        |                  |
| ⑦                           | CITY STANDARD STREET LIGHT |  | 61<br>82       | 3S12"<br>3S12" | SV-2-TA    | T<br>T |            | 49<br>68          | 1S-COUNT<br>1S-COUNT | SP-1-SF (12")<br>SP-1 (22") |                  |

SHEET NOTES:  
◇ CABINET FOUNDATION TYPE: STD

|                                                                    |          |                                                           |            |           |  |
|--------------------------------------------------------------------|----------|-----------------------------------------------------------|------------|-----------|--|
|                                                                    |          |                                                           |            |           |  |
| △                                                                  | 05/05/22 | UPGRADED 41, 42, 61, 81, AND 82 TO 3S12" PER SRC 2021-364 | E. TANG    | E. TSUI   |  |
| △                                                                  | 12/12/21 | CONVERTED FROM CT-2731J AS-BUILT AND PER FIELD            | C. SKERRIT | G. DELEON |  |
| NO.                                                                | DATE     | DESCRIPTION                                               | BY         | APPROVED  |  |
| TABLE OF REVISIONS                                                 |          |                                                           |            |           |  |
| CHECKOUT DRAWING THROUGH THE SID CUSTODIAN FOR THE LATEST REVISION |          |                                                           |            |           |  |

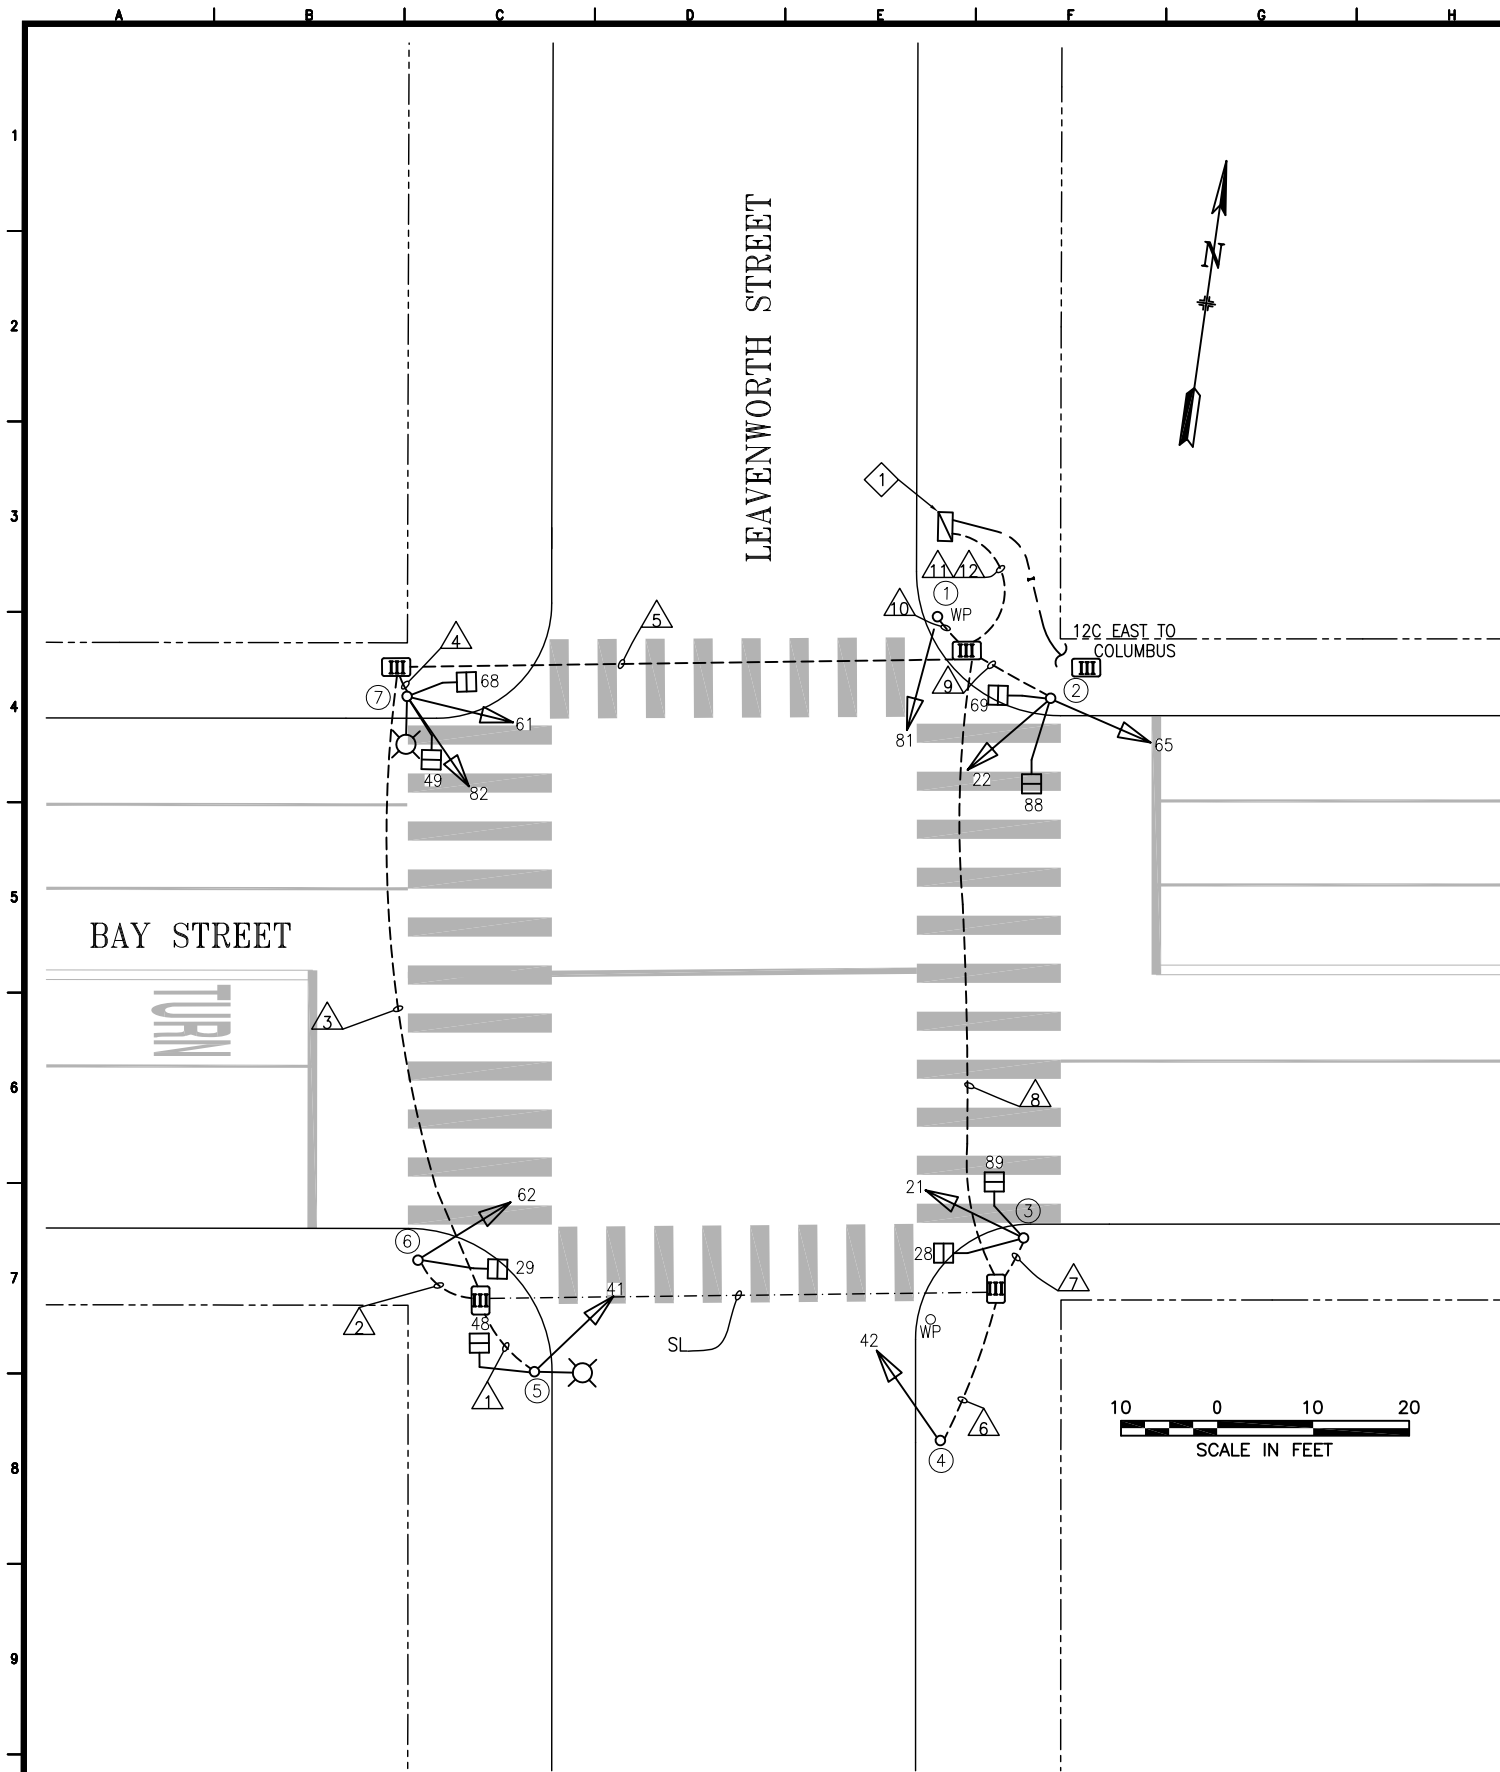

SFMTA

|                          |                  |
|--------------------------|------------------|
| DRAWN BY:<br>C. SKERRIT  | DATE:<br>12/2021 |
| CHECKED BY:<br>G. DELEON | DATE:<br>12/2021 |

|                             |
|-----------------------------|
| SCALE<br>AS SHOWN           |
| SHEET OF SHEETS<br>01 OF 02 |

|                                  |
|----------------------------------|
| TRAFFIC SIGNAL INVENTORY DIAGRAM |
| BAY STREET & LEAVENWORTH STREET  |

|                     |
|---------------------|
| CNN NO:<br>25536000 |
| REV NO:<br>1        |

