


BAY & OCTAVIA

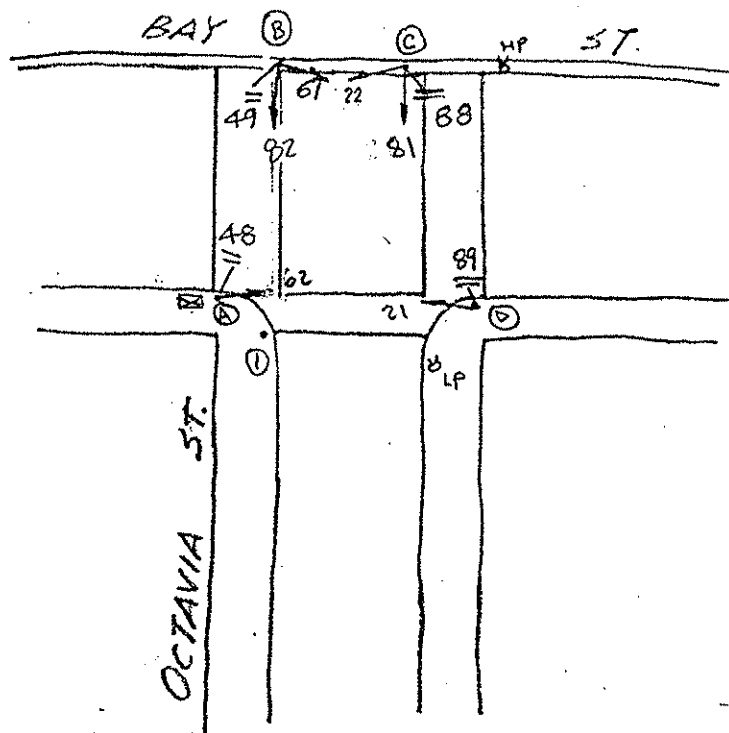

φ2

2-28-92

[illegible]

CONTROLLER CABINET SIZE : ORDINARY BASE CABINET: YES

COMMENTS: installed new ped. signal # 48 & 49