


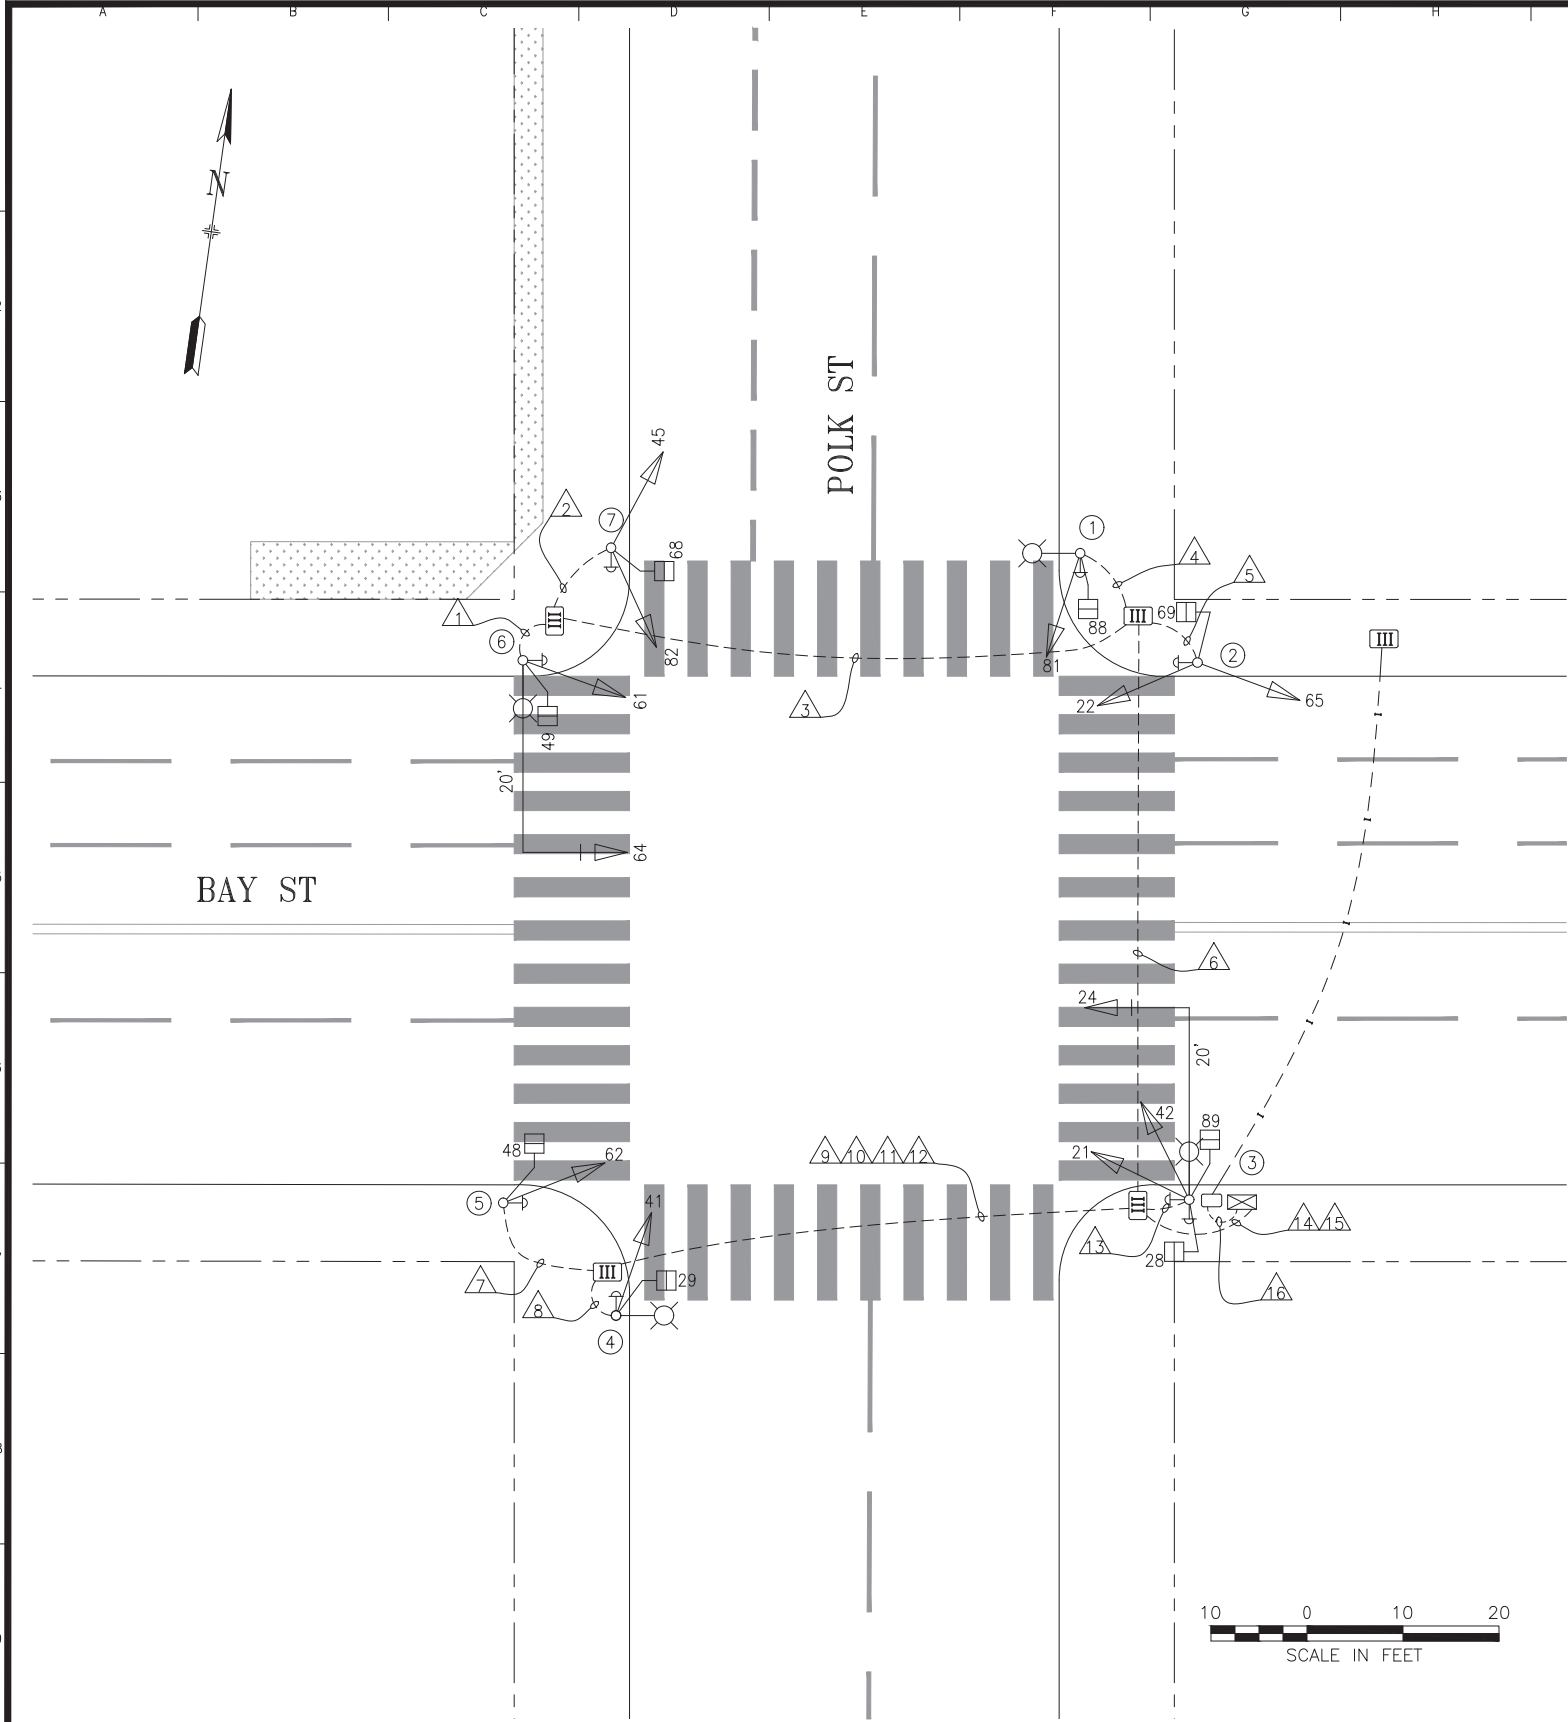

POLE AND EQUIPMENT SCHEDULE											
POLE No.	TYPE OF POLE	LUMINAIRE VOLTAGE/ WATTAGE	VEHICLE SIGNAL					PEDESTRIAN SIGNAL			REMARKS
			No.	TYPE	MOUNTING	VISORS	LOUVERS	No.	TYPE	MOUNTING	
①	CITY STANDARD STREET LIGHT		81	3S12"	SV-1-T	T		88	1S-COUNT	SP-1	APS-4W
②	1-A(10')		22 65	3S12" 3S12"	TV-2-T	T T		69	1S-COUNT	SP-1	APS-4W
③	17-2-100 WITH 20' MA AND 6' LA		21 42 24	3S12" 3S12" 3S12"	SV-2-TC MAS	T T T		28 89	1S-COUNT 1S-COUNT	SP-1(22") SP-1-SF(12")	APS-4W APS-4W BACKPLATE
④	CITY STANDARD STREET LIGHT		41	3S12"	SV-1-T	T		29	1S-COUNT	SP-1	MOUNT 41 @ 13' APS-4W
⑤	1-A(10')		62	3S12"	TV-1-T	T		48	1S-COUNT	SP-1	APS-4W
⑥	17-2-100 WITH 20' MA AND 6' LA		61 64	3S12" 3S12"	SV-1-T MAS	T T	1	48	1S-COUNT	SP-1	APS-4W
⑦	1-A(10')		45 82	3S12" 3S12"	TV-2-T	T T		68	1S-COUNT	SP-1	APS-4W

SHEET NOTES:

① HORIZONTAL LOUVERS ON SIGNAL 64 GREEN SECTION ONLY

NO.	DATE	DESCRIPTION	BY	APPROVED
2	8/7/20	APS INSTALLED PER SRC 2019-187	J.HORNBOSTEL	G.DeLEON
1	5/3/19	LOUVERS ADDED TO 64 GREEN SECTION ONLY BY FIELD CHANGE	J.HORNBOSTEL	G.DeLEON
0	10/11/18	SIGNAL MOD BY 2126J; CONVERTED FROM 2126J & 1094N AS-BUILTS	J.HORNBOSTEL	G.DeLEON
TABLE OF REVISIONS CHECKOUT DRAWING THROUGH THE SID CUSTODIAN FOR THE LATEST REVISION				



SFMTA

DRAWN BY:		DATE:	
J. HORNBOSTEL		9/2021	
CHECKED BY:		DATE:	
G. DeLEON		9/2021	

SCALE
AS SHOWN
SHEET OF SHEETS
01 OF 02

TRAFFIC SIGNAL INVENTORY DIAGRAM	
BAY STREET AND POLK STREET	

CNN NO:
26701000
REV NO:
2

CONDUIT AND WIRING SCHEDULE (FURNISH AND INSTALL CONDUIT AND WIRES)																														
CONDUIT RUN NUMBER		△1	△2	△3	△4	△5	△6	△7	△8	△9	△10	△11	△12	△13	△14	△15	△16													
CONDUIT SIZE (INCH)		2	2	2	2	2	2	2	2	2	2	2	2	2	2	2	2													
		GRS		GRS	GRS	GRS	GRS	GRS	GRS	GRS	SP	SP	GRS	GRS	GRS	GRS	GRS													
NOTES																														
	VEHICLE SIGNAL 61	3		3			3									3														
	VEHICLE SIGNAL 64	3		3			3									3														
	PED SIGNAL 49	2		2			2									2														
	VEHICLE SIGNAL 45		3	3			3									3														
	VEHICLE SIGNAL 82		3	3			3									3														
	PED SIGNAL 68		2	2			2									2														
	VEHICLE SIGNAL 81				3		3									3														
	PED SIGNAL 88				2		2									2														
	VEHICLE SIGNAL 22					3	3									3														
	VEHICLE SIGNAL 65					3	3									3														
	PED SIGNAL 69					2	2									2														
	VEHICLE SIGNAL 62							3		3							3													
	PED SIGNAL 48						2			2							2													
	VEHICLE SIGNAL 41								3	3							3													
	PED SIGNAL 29								2	2							2													
	VEHICLE SIGNAL 21															3		3												
	VEHICLE SIGNAL 24															3		3												
	VEHICLE SIGNAL 42															3		3												
	PED SIGNAL 28															2		2												
	PED SIGNAL 89															2		2												
	#14 NEUTRAL	3	2		2	2		2	2		</																			

2	8/7/20	APS INSTALLED PER SRC 2019-187	J.HORNBOSTEL	G.DeLEON
1	5/3/19	LOUVERS ADDED TO 64 GREEN SECTION ONLY BY FIELD CHANGE	J.HORNBOSTEL	G.DeLEON
0	10/11/18	SIGNAL MOD BY 2126J; CONVERTED FROM 2126J & 1094N AS-BUILTS	J.HORNBOSTEL	G.DeLEON
NO.	DATE	DESCRIPTION	BY	APPROVED
TABLE OF REVISIONS CHECKOUT DRAWING THROUGH THE SID CUSTODIAN FOR THE LATEST REVISION				

**SFMTA**

DRAWN BY: J. HORNBOSTEL DATE: 9/2021

CHECKED BY: G. DeLEON DATE: 9/2021

NONE

02 OF 02

BAY STREET AND POLK STREET CONDUIT AND WIRING SCHEDULE

26701000