


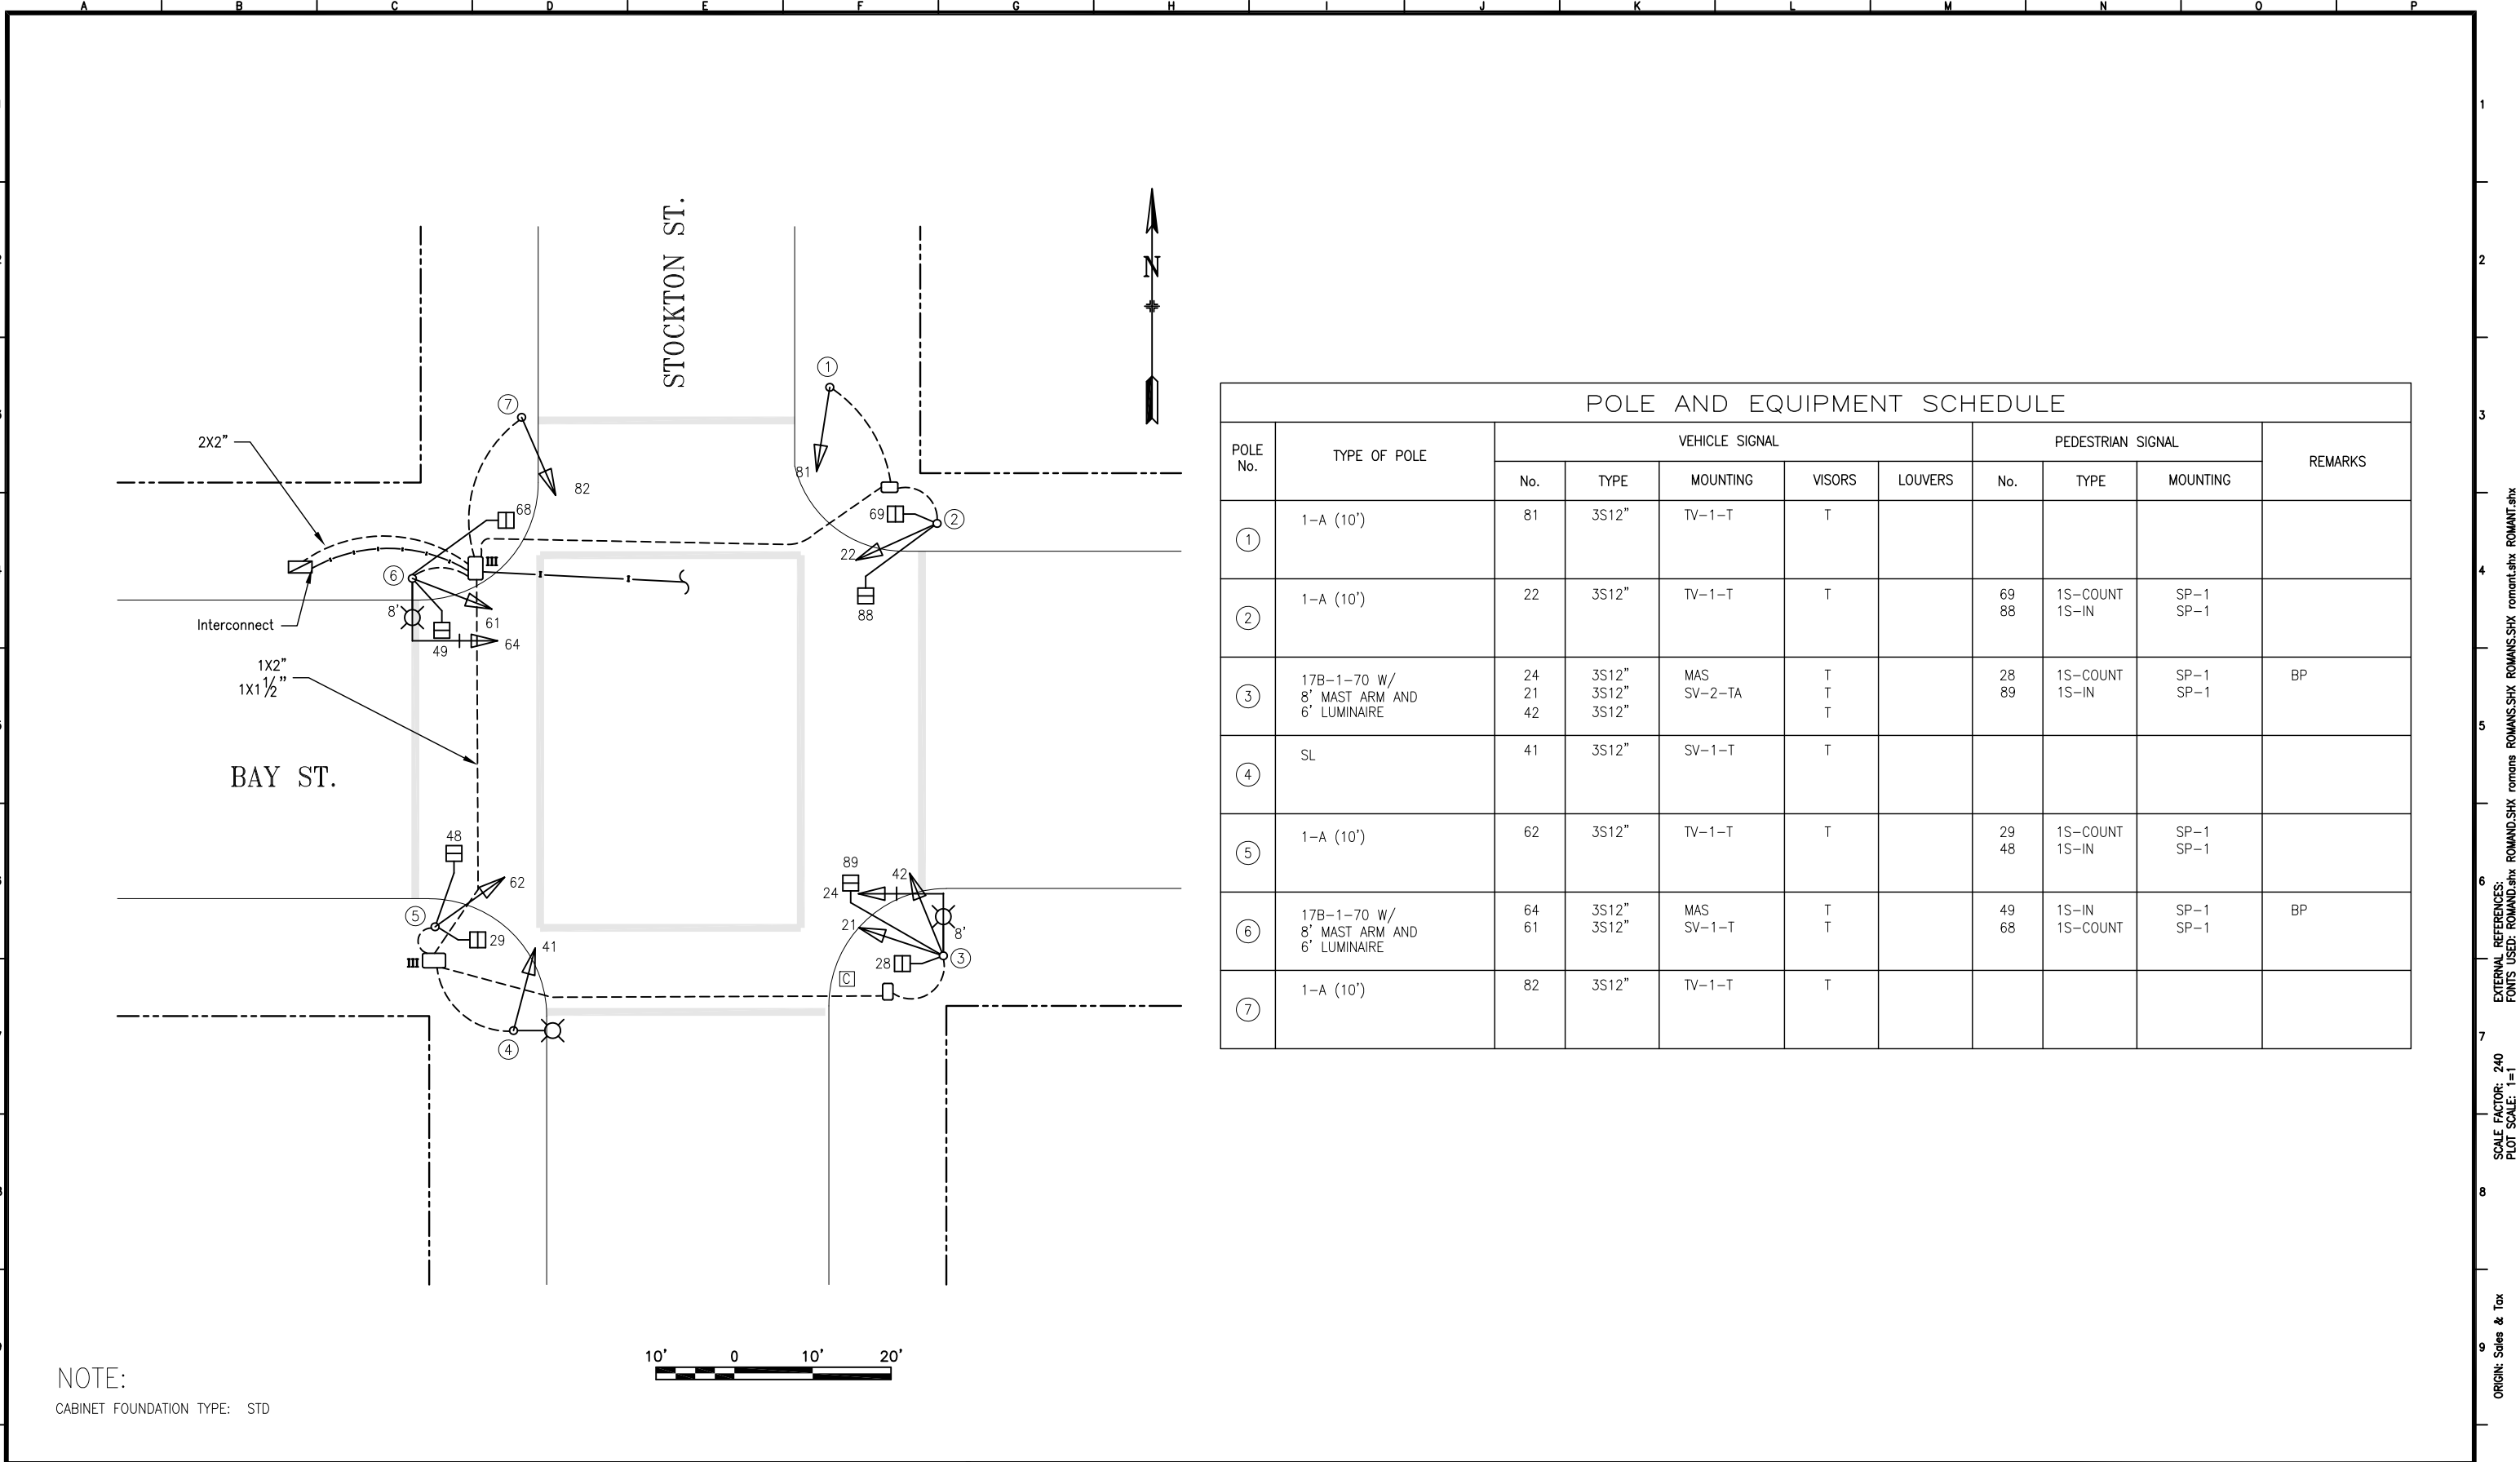

POLE AND EQUIPMENT SCHEDULE										
POLE No.	TYPE OF POLE	VEHICLE SIGNAL					PEDESTRIAN SIGNAL			REMARKS
		No.	TYPE	MOUNTING	VISORS	LOUVERS	No.	TYPE	MOUNTING	
①	1-A (10')	81	3S12"	TV-1-T	T					
②	1-A (10')	22	3S12"	TV-1-T	T		69 88	1S-COUNT 1S-IN	SP-1 SP-1	
③	17B-1-70 W/ 8' MAST ARM AND 6' LUMINAIRE	24 21 42	3S12" 3S12" 3S12"	MAS SV-2-TA	T T T		28 89	1S-COUNT 1S-IN	SP-1 SP-1	BP
④	SL	41	3S12"	SV-1-T	T					
⑤	1-A (10')	62	3S12"	TV-1-T	T		29 48	1S-COUNT 1S-IN	SP-1 SP-1	
⑥	17B-1-70 W/ 8' MAST ARM AND 6' LUMINAIRE	64 61	3S12" 3S12"	MAS SV-1-T	T T		49 68	1S-IN 1S-COUNT	SP-1 SP-1	BP
⑦	1-A (10')	82	3S12"	TV-1-T	T					

3	6/6/2023	PER SRC 2023-005: UPGRADE REMAINING SIGNALS TO 12"	A.LAM	E.TSUI
2	09/01/11	ADD SIGNALS 28,29,68,69 PER SRC 10-080	E.TSUI	H.QUAN
1	07/97	BAY & NORTH PT. PROJECT JOB# 1094 N	DVC	R.OLEA

NO.	DATE	DESCRIPTION	BY	APPROVED
TABLE OF REVISIONS				
CHECKOUT DRAWING THROUGH THE SID CUSTODIAN FOR THE LATEST REVISION				



SFMTA

DRAWN BY: DVC	DATE: 8/29/01
CHECKED BY:	DATE:

SCALE AS SHOWN	TRAFFIC SIGNAL INVENTORY DIAGRAM	CNN NO: 25410000
SHEET OF SHEETS 1 OF 1		REV NO:

BAY ST & STOCKTON ST

3

EXTERNAL REFERENCES: ROMANS.SHX ROMANS.SHX ROMANS.SHX
FONTS USED: ROMAND.SHX ROMAND.SHX
SCALE FACTOR: 240
PLOT SCALE: 1"=1'
ORIGIN: Sales & Tax
FILE NAME: Bay-Stockton.dwg
DATE: Aug 29 2001 17:04