


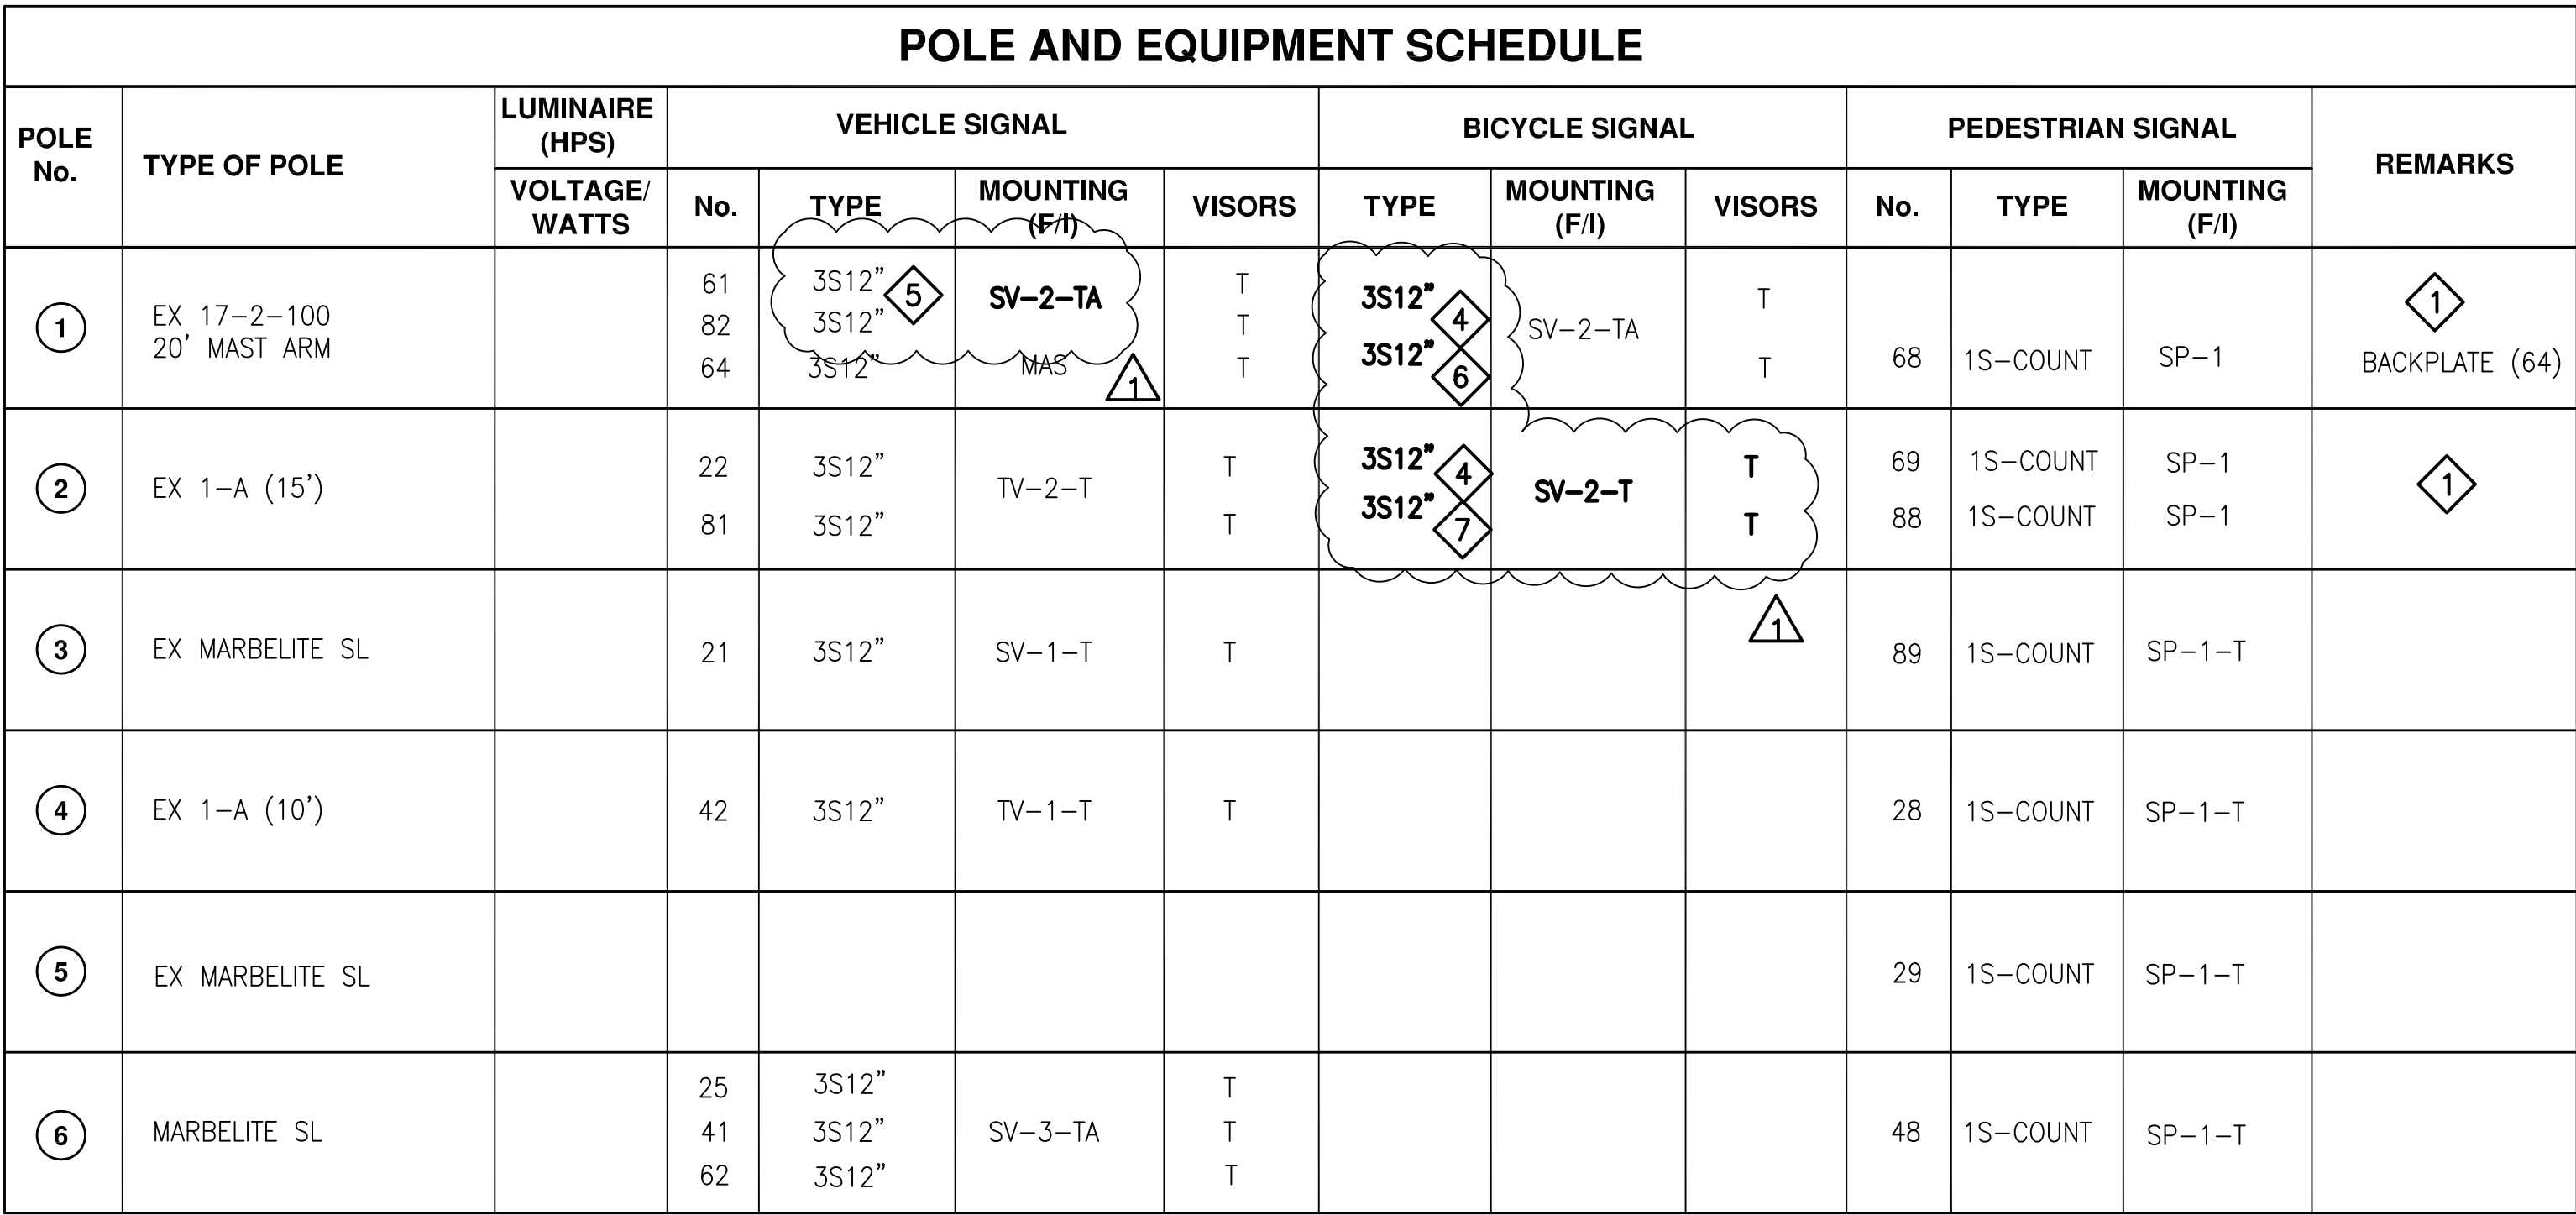

- 1 REPROGRAMMING OF SIGNALS BY SFMTA.
- 2 RELOCATE & INSTALL EXISTING MARBLEJITE POLE PER STRUCTURAL DETAIL ON SHEET S-3 & S-4. NEW LOCATION TO BE VERIFIED IN THE FIELD BY CONTRACTOR WITH THE FINAL APPROVAL BY CITY REPRESENTATIVE. EXTEND CONDUIT AND WIRINGS AND SPLICE NEW WIRES TO EXISTING. CONNECT TO EXISTING SL CIRCUIT.
- 3 F/I 1 1/2" C, CABLES TO MATCH EXISTING AND PROVIDE DISCONNECT FUSE.
- 4 INSTALL (N) BICYCLE SIGNALS TO EXISTING POLES.
- 5 RELOCATE (E) VEH SIG 61 AND 82 TO MOUNT AT 15' AFF. PROVIDE CUSTOM GRS FRAMEWORK PER FIELD MEETING ON 4/2/13.
- 6 MOUNT NEW BICYCLE SIGNAL 49 AND 68 ON (E) FRAMEWORK AT 10' 6" AFF PER FIELD MEETING ON 4/2/13.
- 7 MOUNT NEW BICYCLE SIGNAL 69 AND 88 ON (N) FRAMEWORK AT 10' 6" AFF PER FIELD MEETING ON 4/2/13.

CONTRACT NO.	1073J
DRAWING NO.	E-2.0
FILE NO.	93437
REV. NO.	1

[illegible]