


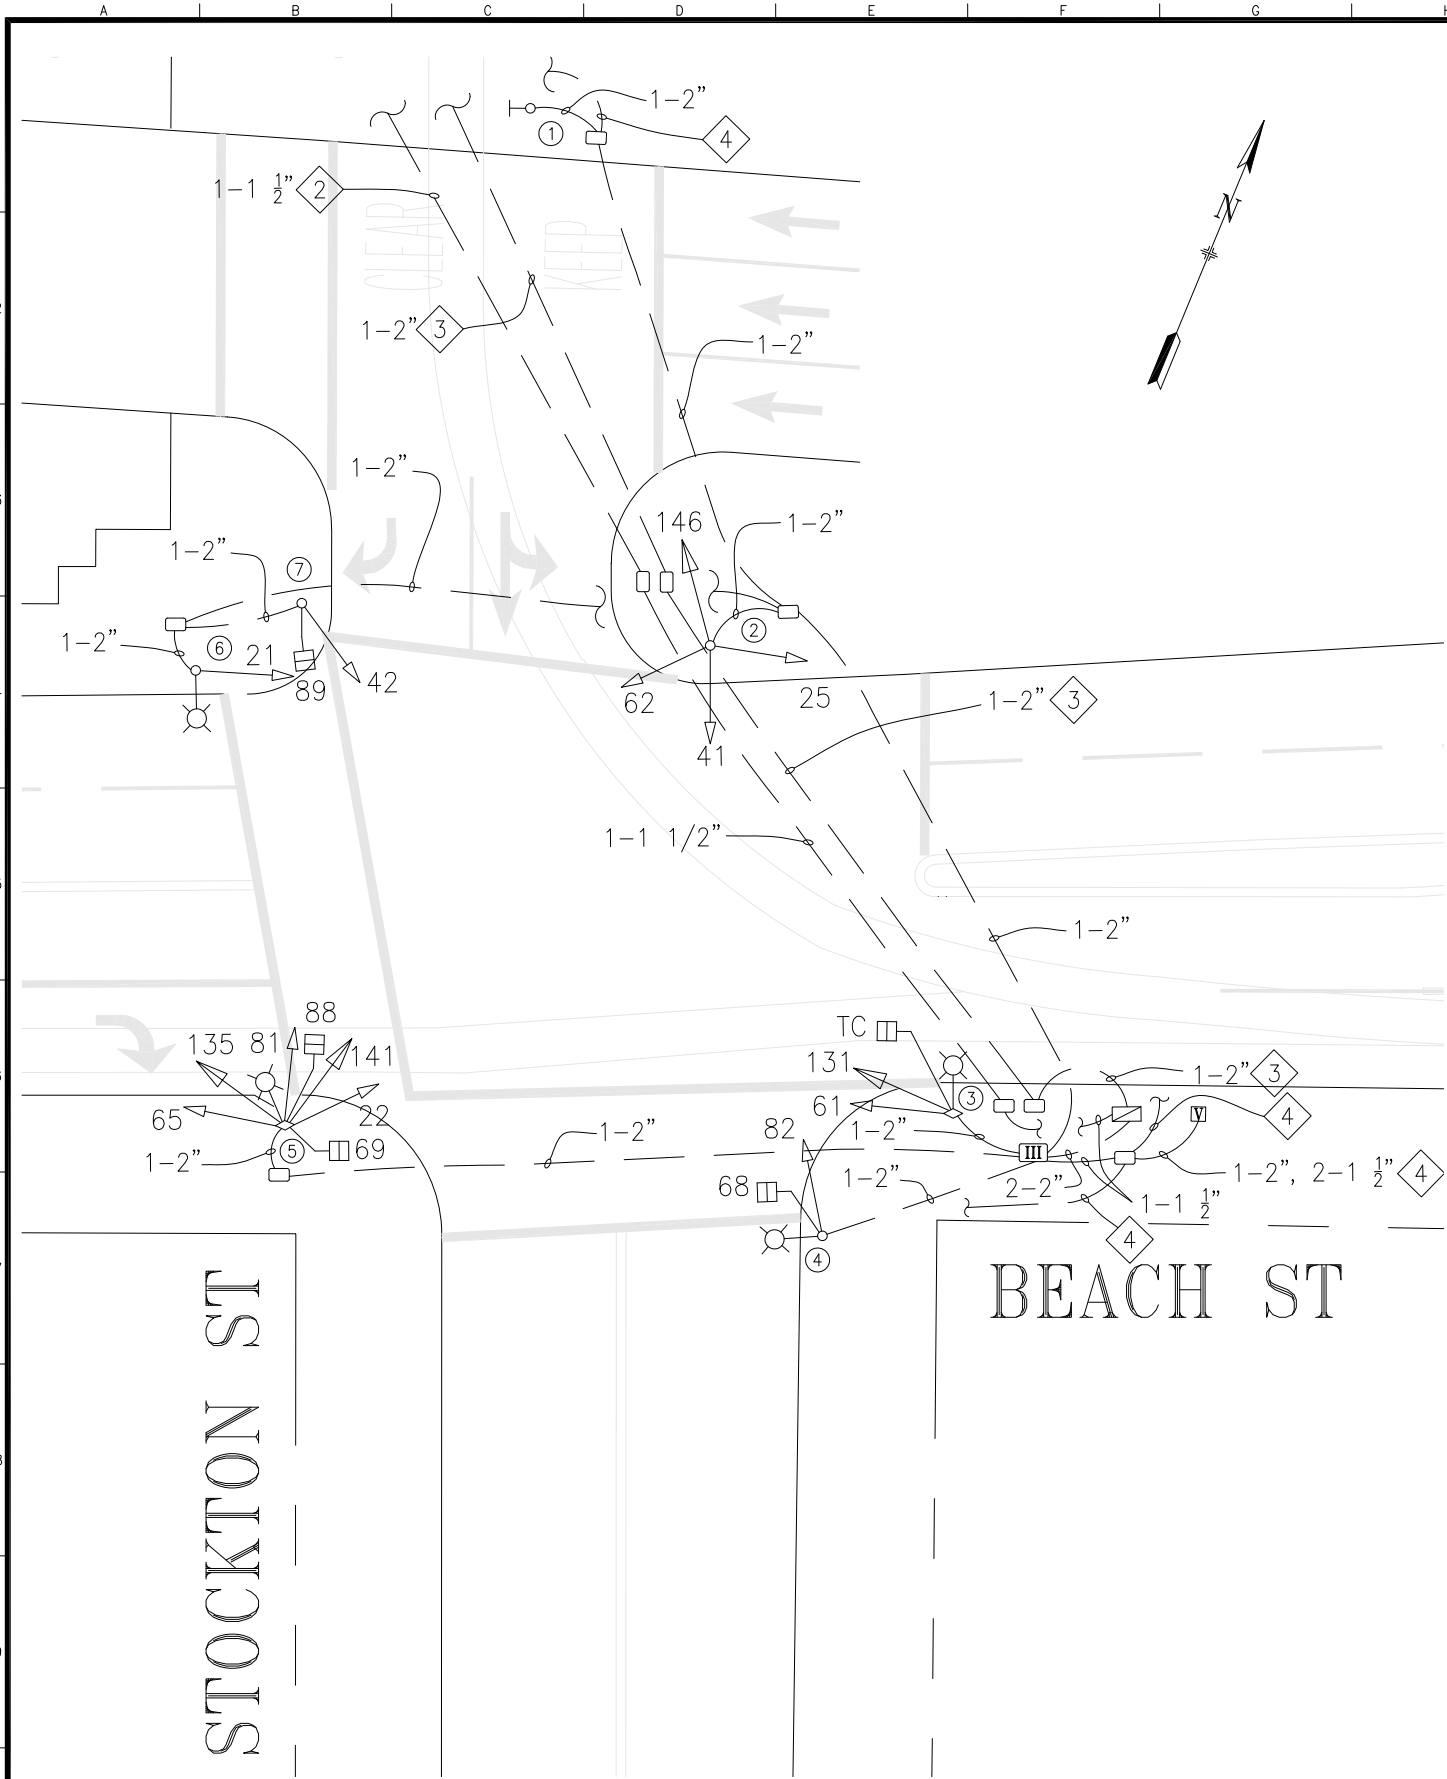

POLE AND EQUIPMENT SCHEDULE										
POLE No.	TYPE OF POLE	VEHICLE SIGNAL					PEDESTRIAN SIGNAL			REMARKS
		No.	TYPE	MOUNTING	VISORS	LOUVERS	No.	TYPE	MOUNTING	
①	WAYSIDE PUSH BUTTON POLE									KEY OPERATED SWITCH FOR MUNI ACTUATION CALLS
②	1-A (10')	25 41 62 146	3S8" 3S8" 3S8" 2S12" LB	TV-3-T-SF SV-1	T T T T					
③	COMBINATION POLE (POLE #228/09)	61 131 TC	3S8" 2S12" LB 1S 24"X24"	SV-1-T SV-1 SV-1	T T					
④	STREETLIGHT POLE (POLE #236)	82	3S8"	SV-1-T	T		68	1S-COUNT	SP-1	
⑤	COMBINATION POLE (POLE #226/11)	22 65 81 135 141	3S8" 3S8" 3S8" 2S12" LB 2S12" LB	SV-3-TA SV-1 SV-1	T T T T T		69 88	1S-COUNT 1S-COUNT	SP-2-T	
⑥	STREETLIGHT POLE (POLE #12)	21	3S8"	SV-1-T	T					
⑦	1-A (10')	42	3S8"	TV-1	T		89	1S-COUNT	SP-1	

- NOTE:
- CABINET FOUNDATION TYPE: M-SF
 - TO PG&E SERVICE POINT. SEE SPECIFICATION NO. 7443E, DRAWINGS P-2 & P-3 FOR FURTHER DETAILS.
 - 12C INTERCONNECT
 - TO VETAG LOOPS & CABINET - SEE CONTRACT MR-1112R, SHEET E-4 FOR FURTHER DETAILS (MAINTAINED BY MOW)

5	4/8/21	SRC 2020-352: INSTALLED FTC SIGN; UPDATED PER FIELD CONDITIONS AND MR-1112R/6094Q AS-BUILTS	TY	BT	REFERENCE INFORMATION & FILE NO. OF SURVEYS SPECIFICATION NO. 7443E DRAWINGS P-2, P-3, P-3.3 & P-3.4 CONTRACT MR-1112R DRAWINGS CL-10615, CL-10635 & CL-10636 CONTRACT 6094Q DRAWING 68164
4	8/12/18	SRC 2018-133: NEW SIGNALS 135 & 141	TY	CL	
3	10/5/14	SRC 2014-202: REPLACE "T" WITH LUNAR BARS	BW	CW	
2	1/24/12	SRC 2011-282: NEW CONTROLLER & CABINET	ET	HQ	
1	2/24/03	SRC 2002-145: INSTALLED PED COUNTDOWN SIGNALS	MG	JM	
NO.	DATE	DESCRIPTION	BY	APP.	
TABLE OF REVISIONS CHECK WITH TRACING TO SEE IF YOU HAVE LATEST REVISION					



SAN FRANCISCO MUNICIPAL TRANSPORTATION AGENCY
CITY AND COUNTY OF SAN FRANCISCO

DRAWN:	DATE:
TY	3/2019
CHECKED:	DATE:
CL	3/2019

SCALE:

1"=10'

SHEET OF SHEETS

1 OF 1

TRAFFIC SIGNAL INVENTORY DIAGRAM

BEACH STREET AND STOCKTON STREET

CNN NO.

25477000

REV NO.

5