


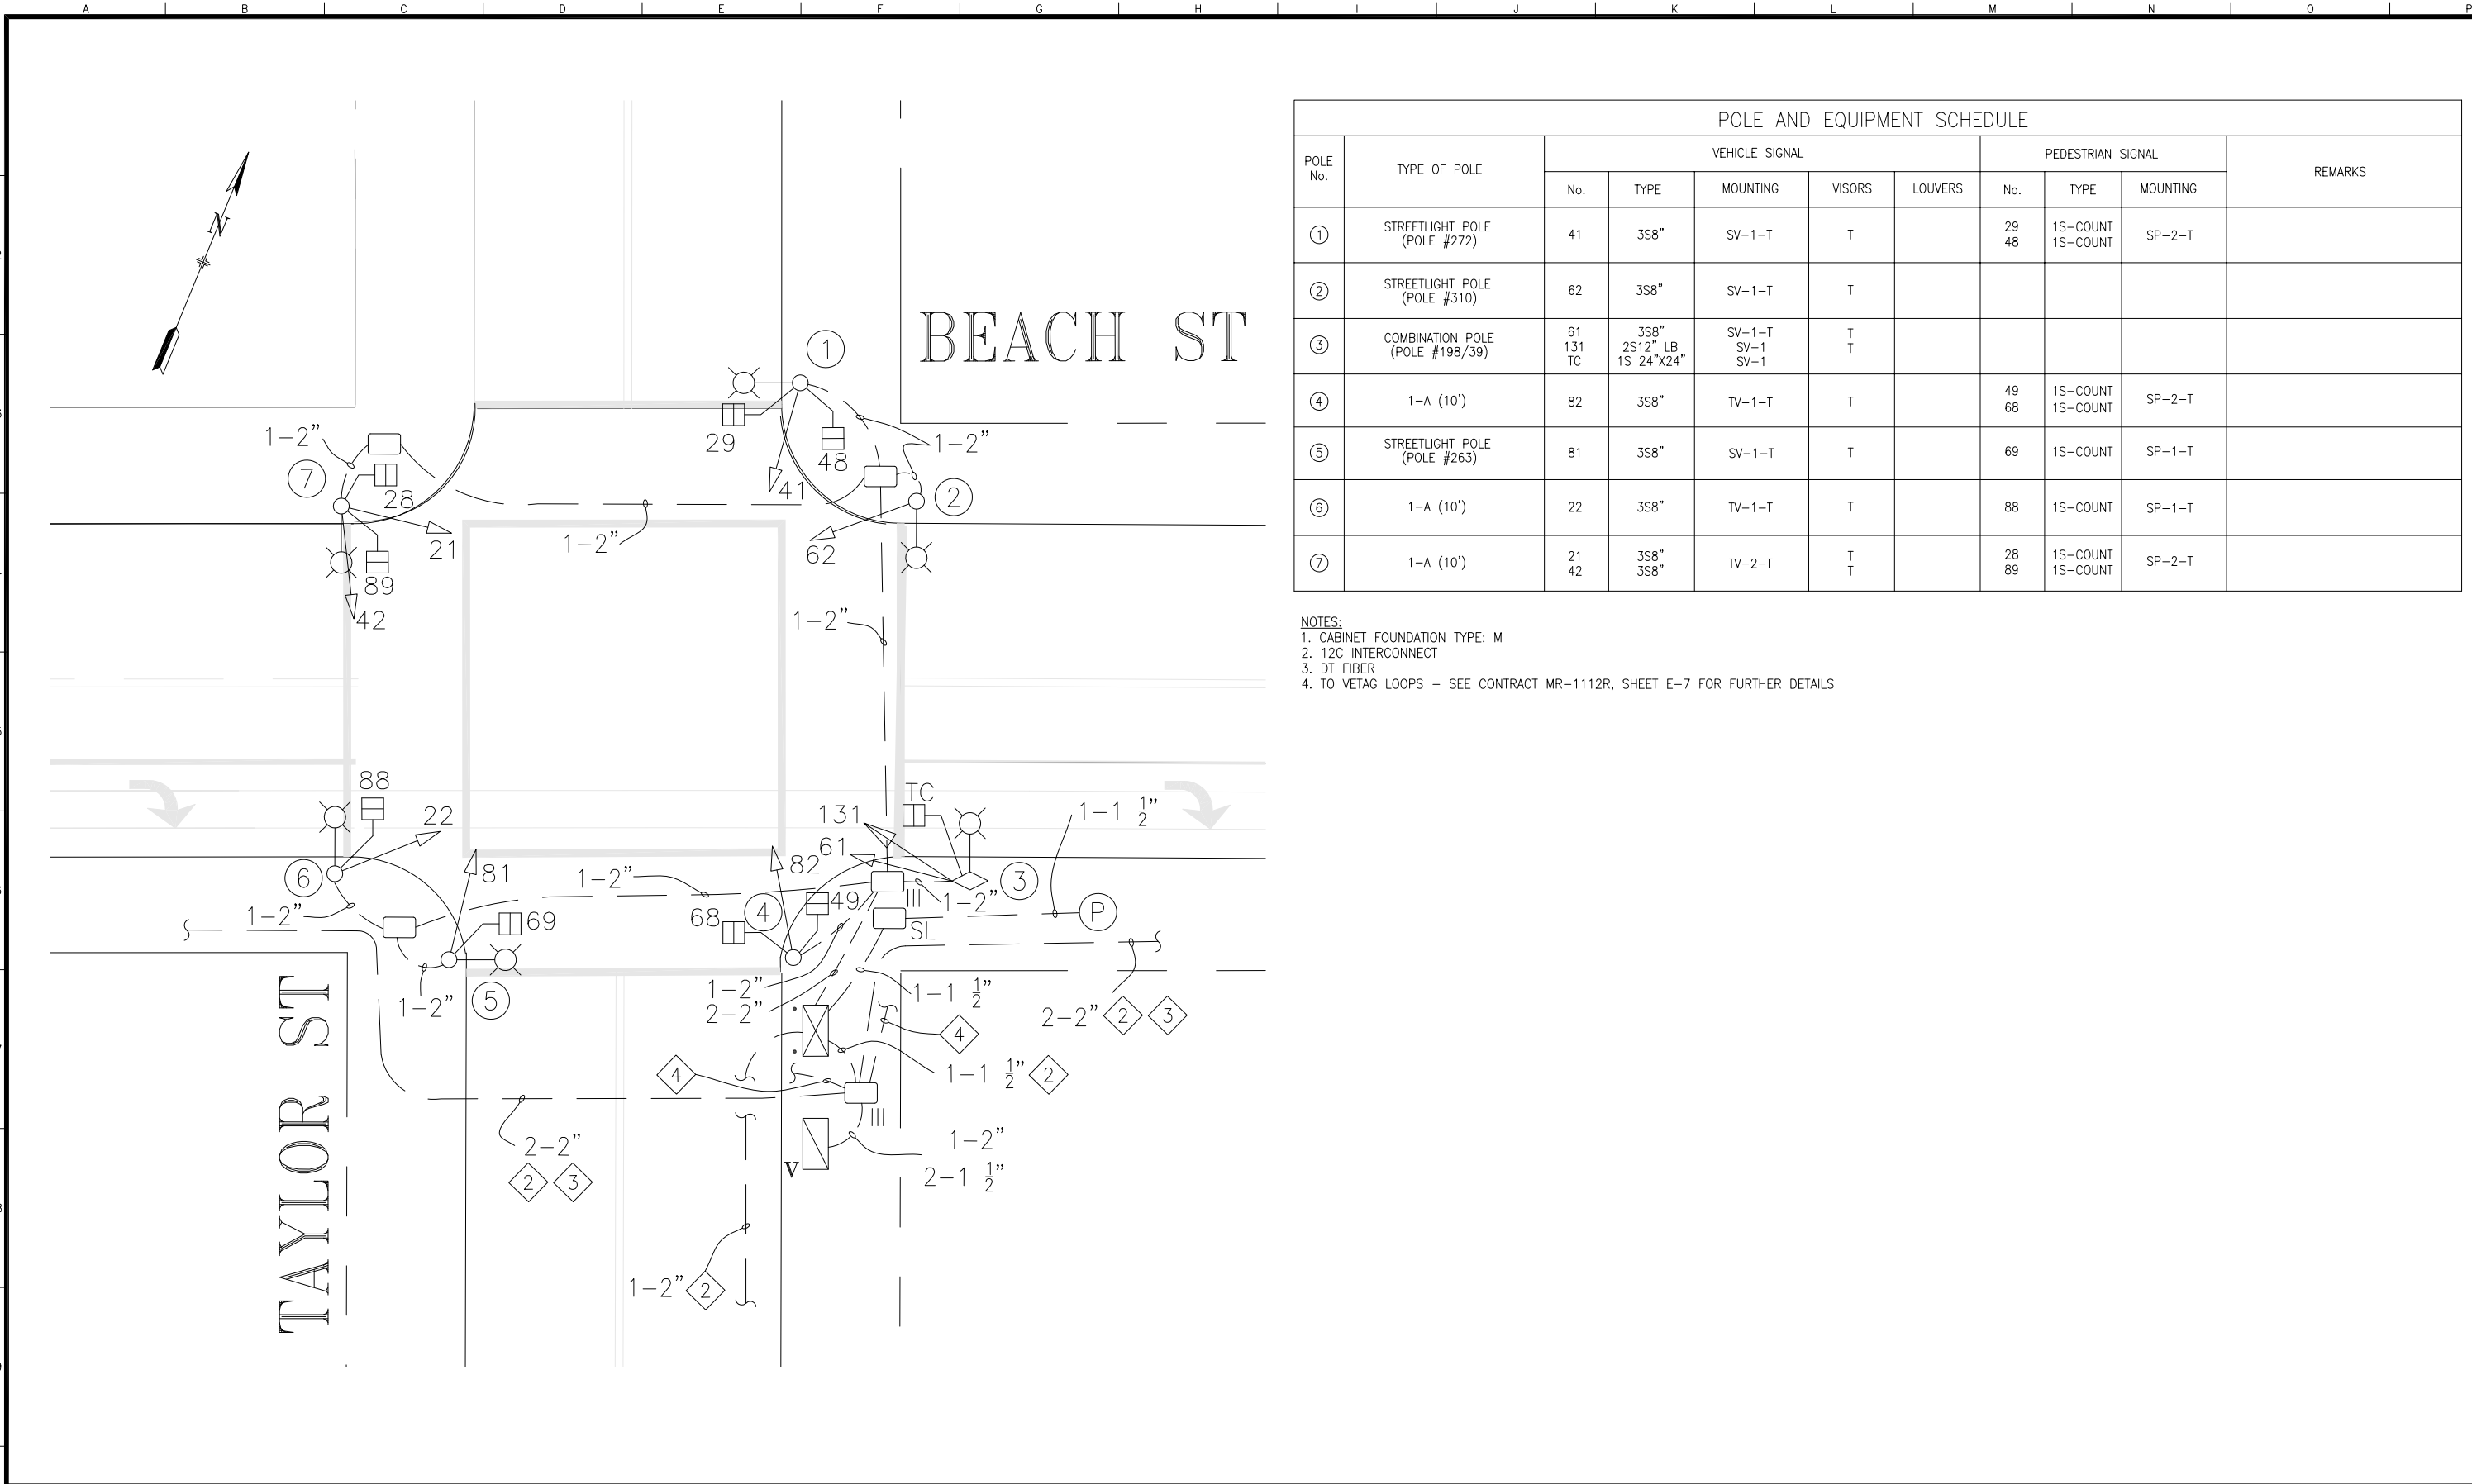

POLE AND EQUIPMENT SCHEDULE										
POLE No.	TYPE OF POLE	VEHICLE SIGNAL					PEDESTRIAN SIGNAL			REMARKS
		No.	TYPE	MOUNTING	VISORS	LOUVERS	No.	TYPE	MOUNTING	
①	STREETLIGHT POLE (POLE #272)	41	3S8"	SV-1-T	T		29 48	1S-COUNT 1S-COUNT	SP-2-T	
②	STREETLIGHT POLE (POLE #310)	62	3S8"	SV-1-T	T					
③	COMBINATION POLE (POLE #198/39)	61 131 TC	3S8" 2S12" LB 1S 24"x24"	SV-1-T SV-1 SV-1	T T					
④	1-A (10')	82	3S8"	TV-1-T	T		49 68	1S-COUNT 1S-COUNT	SP-2-T	
⑤	STREETLIGHT POLE (POLE #263)	81	3S8"	SV-1-T	T		69	1S-COUNT	SP-1-T	
⑥	1-A (10')	22	3S8"	TV-1-T	T		88	1S-COUNT	SP-1-T	
⑦	1-A (10')	21 42	3S8" 3S8"	TV-2-T	T T		28 89	1S-COUNT 1S-COUNT	SP-2-T	

NOTES:
1. CABINET FOUNDATION TYPE: M
2. 12C INTERCONNECT
3. DT FIBER
4. TO VETAG LOOPS - SEE CONTRACT MR-1112R, SHEET E-7 FOR FURTHER DETAILS

0	4/8/21	SRC 2020-352: INSTALLED FTC SIGN; UPDATED PER FIELD CONDITIONS	TY	BT	
		CONVERTED FROM MR-1112R/6094Q AS-BUILTS			
NO.	DATE	DESCRIPTION	BY	APP.	

TABLE OF REVISIONS
CHECK WITH TRACING TO SEE IF YOU HAVE LATEST REVISION

REFERENCE INFORMATION
& FILE NO. OF SURVEYS

CONTRACT MR-1112R
DRAWINGS E-7 & E-15
CONTRACT 6094Q
DRAWING TE-31

SAN FRANCISCO MUNICIPAL TRANSPORTATION AGENCY
CITY AND COUNTY OF SAN FRANCISCO

DRAWN:	DATE:
TY	06/2021
CHECKED:	DATE:
MV	06/2021

SCALE:
1" = 10'

SHEET OF SHEETS
1 OF 1

TRAFFIC SIGNAL INVENTORY DIAGRAM

BEACH STREET AND TAYLOR STREET

CNN NO.
25591000

REV NO.
0