


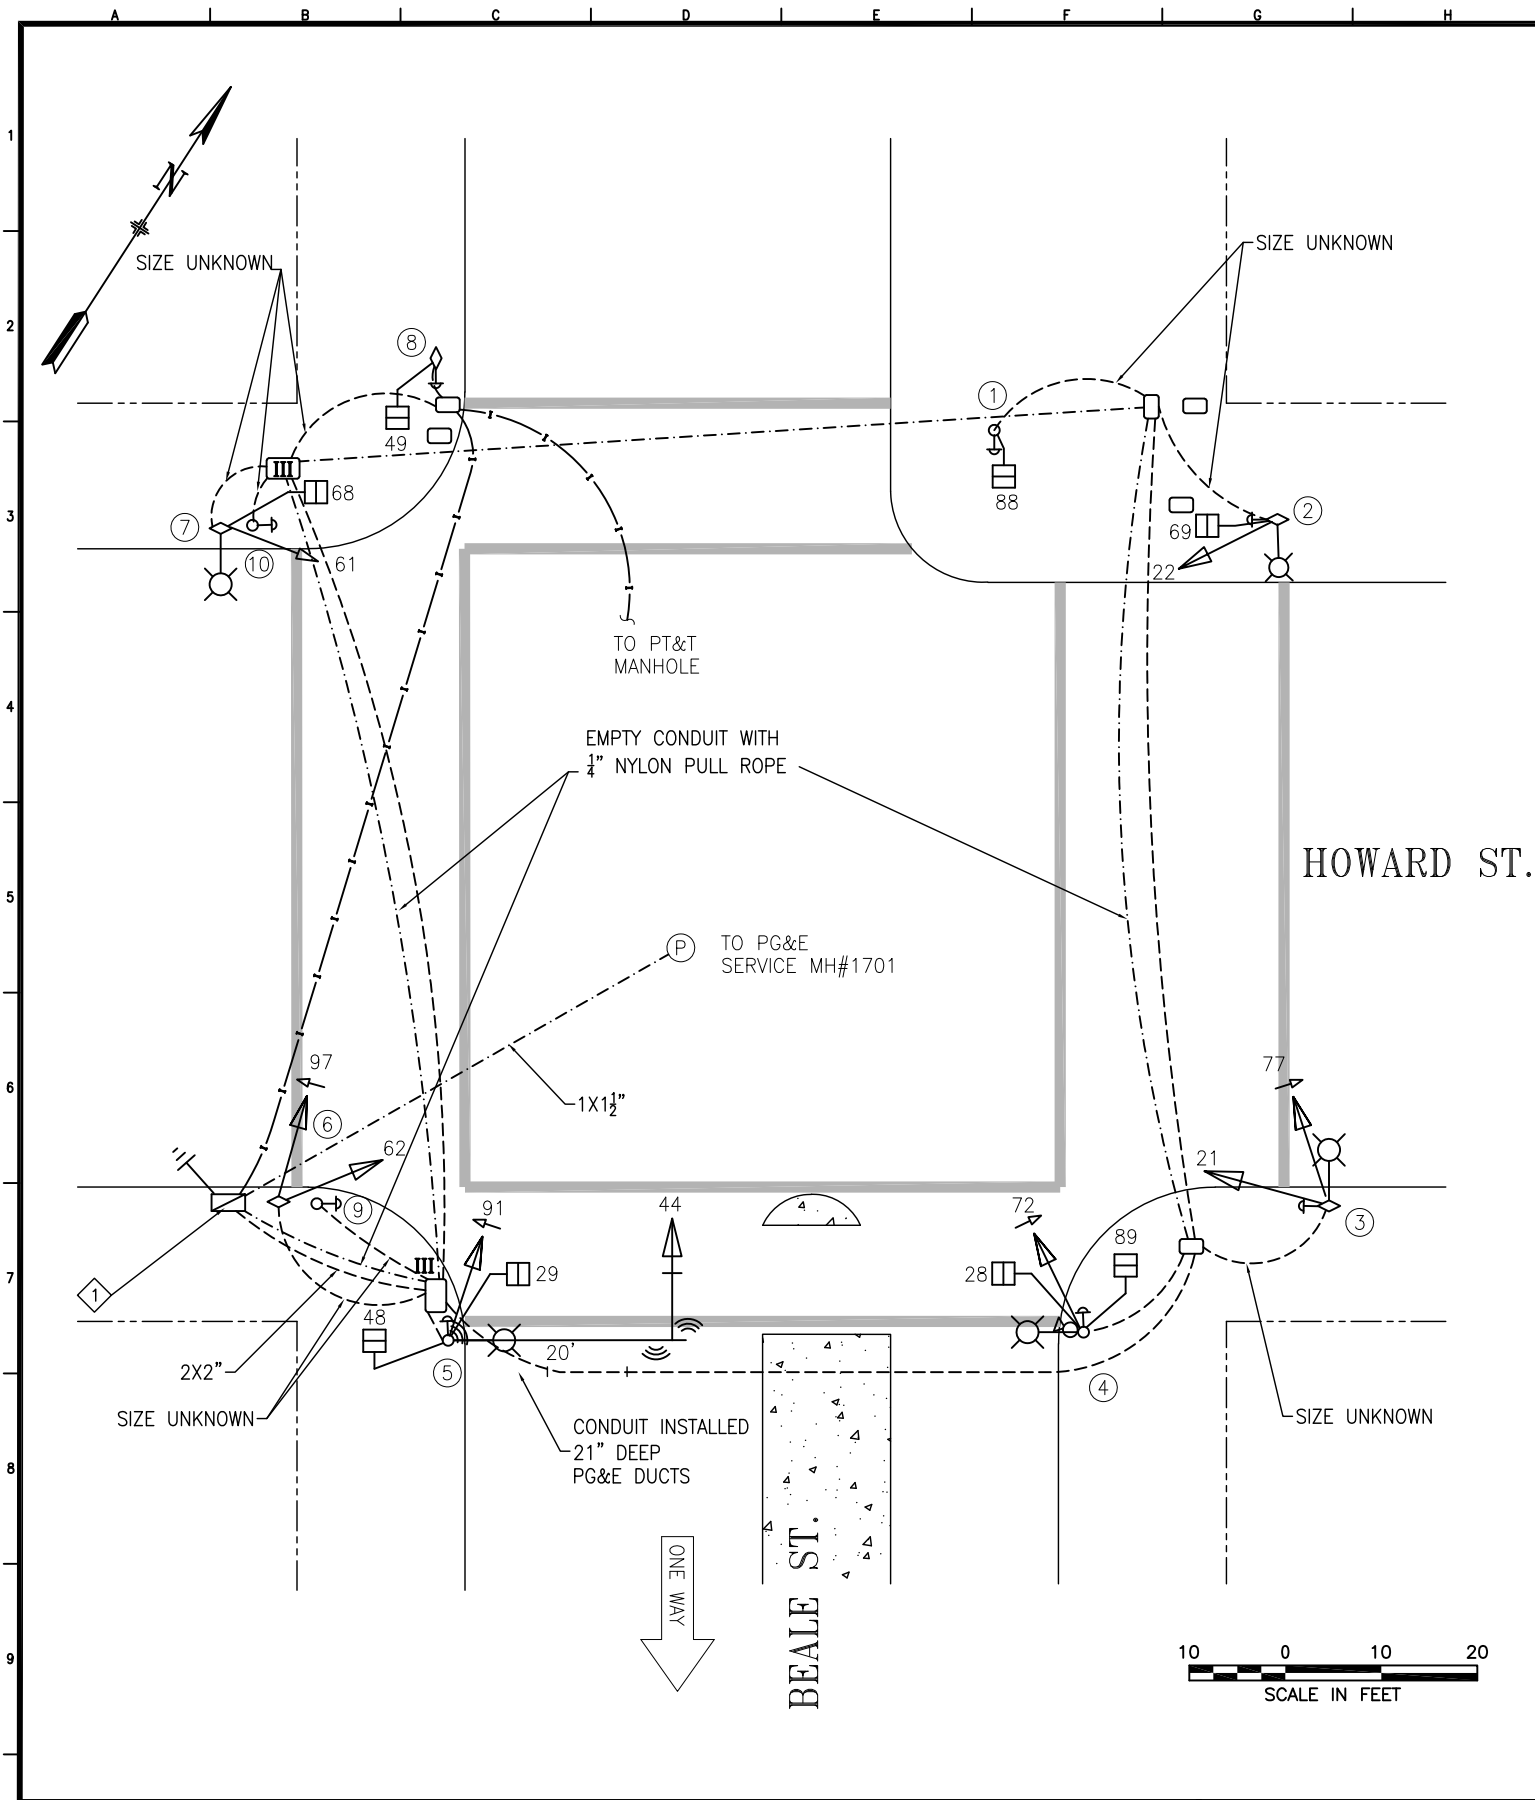

POLE AND EQUIPMENT SCHEDULE										
POLE No.	TYPE OF POLE	VEHICLE SIGNAL					PEDESTRIAN SIGNAL			REMARKS
		No.	TYPE	MOUNTING	VISORS	LOUVERS/BP	No.	TYPE	MOUNTING	
①	1-A (10')						88	1S-COUNT	SP-1	APS
②	MUNI POLE WITH SL	22	3S12"	SV-1-T	T		69	1S-COUNT	SP-1	APS
③	MUNI FEEDER POLE WITH SL	21 77	3S12" 4S12" GLA	SV-2-TA	T T					APS
④	SL	72	4S12" GLA	SV-1-T	T		28 89	1S-COUNT 1S-COUNT	SP-1 S9-1	APS SFGO CAMERA
⑤	17B-1-70 WITH 20' MA AND 6' LA	44 91	3S12" 4S12" GRA	MAS SV-1-T	T T	BP -	29 48	1S-COUNT 1S-COUNT	SP-1 SP-1	APS TSP EQUIPMENT
⑥	MUNI FEEDER POLE	62 97	3S12" 4S12" GRA	SV-2-T	T T					EXTERNAL CONDUIT
⑦	MUNI FEEDER POLE WITH SL	61	3S8"	SV-1-T	T		68	1S-COUNT	SP-1-T	EXTERNAL CONDUIT
⑧	MUNI						49	1S-COUNT	SP-1	APS
⑨	PPB POST									APS
⑩	PPB POST									APS

SHEET NOTES:
① CABINET FOUNDATION TYPE: M-SF

09/23/19	UPDATE VIA TRANSBAY BLOCK 5 PARK TOWER AS-BUILT AND PER FIELD	LYee/SBroady	NWong		
03/99	HOWARD STREET SIGNAL UPGRADE CONTRACT #1430N	CXLeung	ROlea		
NO.	DATE	DESCRIPTION	BY	APPROVED	
TABLE OF REVISIONS CHECKOUT DRAWING THROUGH THE SID CUSTODIAN FOR THE LATEST REVISION					



SFMTA

DRAWN BY: JD/CXL	DATE: 12/28/00
CHECKED BY:	DATE:

SCALE 1" = 20'
SHEET OF SHEETS 1 OF 1

TRAFFIC SIGNAL INVENTORY DIAGRAM
BEALE STREET & HOWARD STREET

CNN NO: 24506000
REV NO: 2