


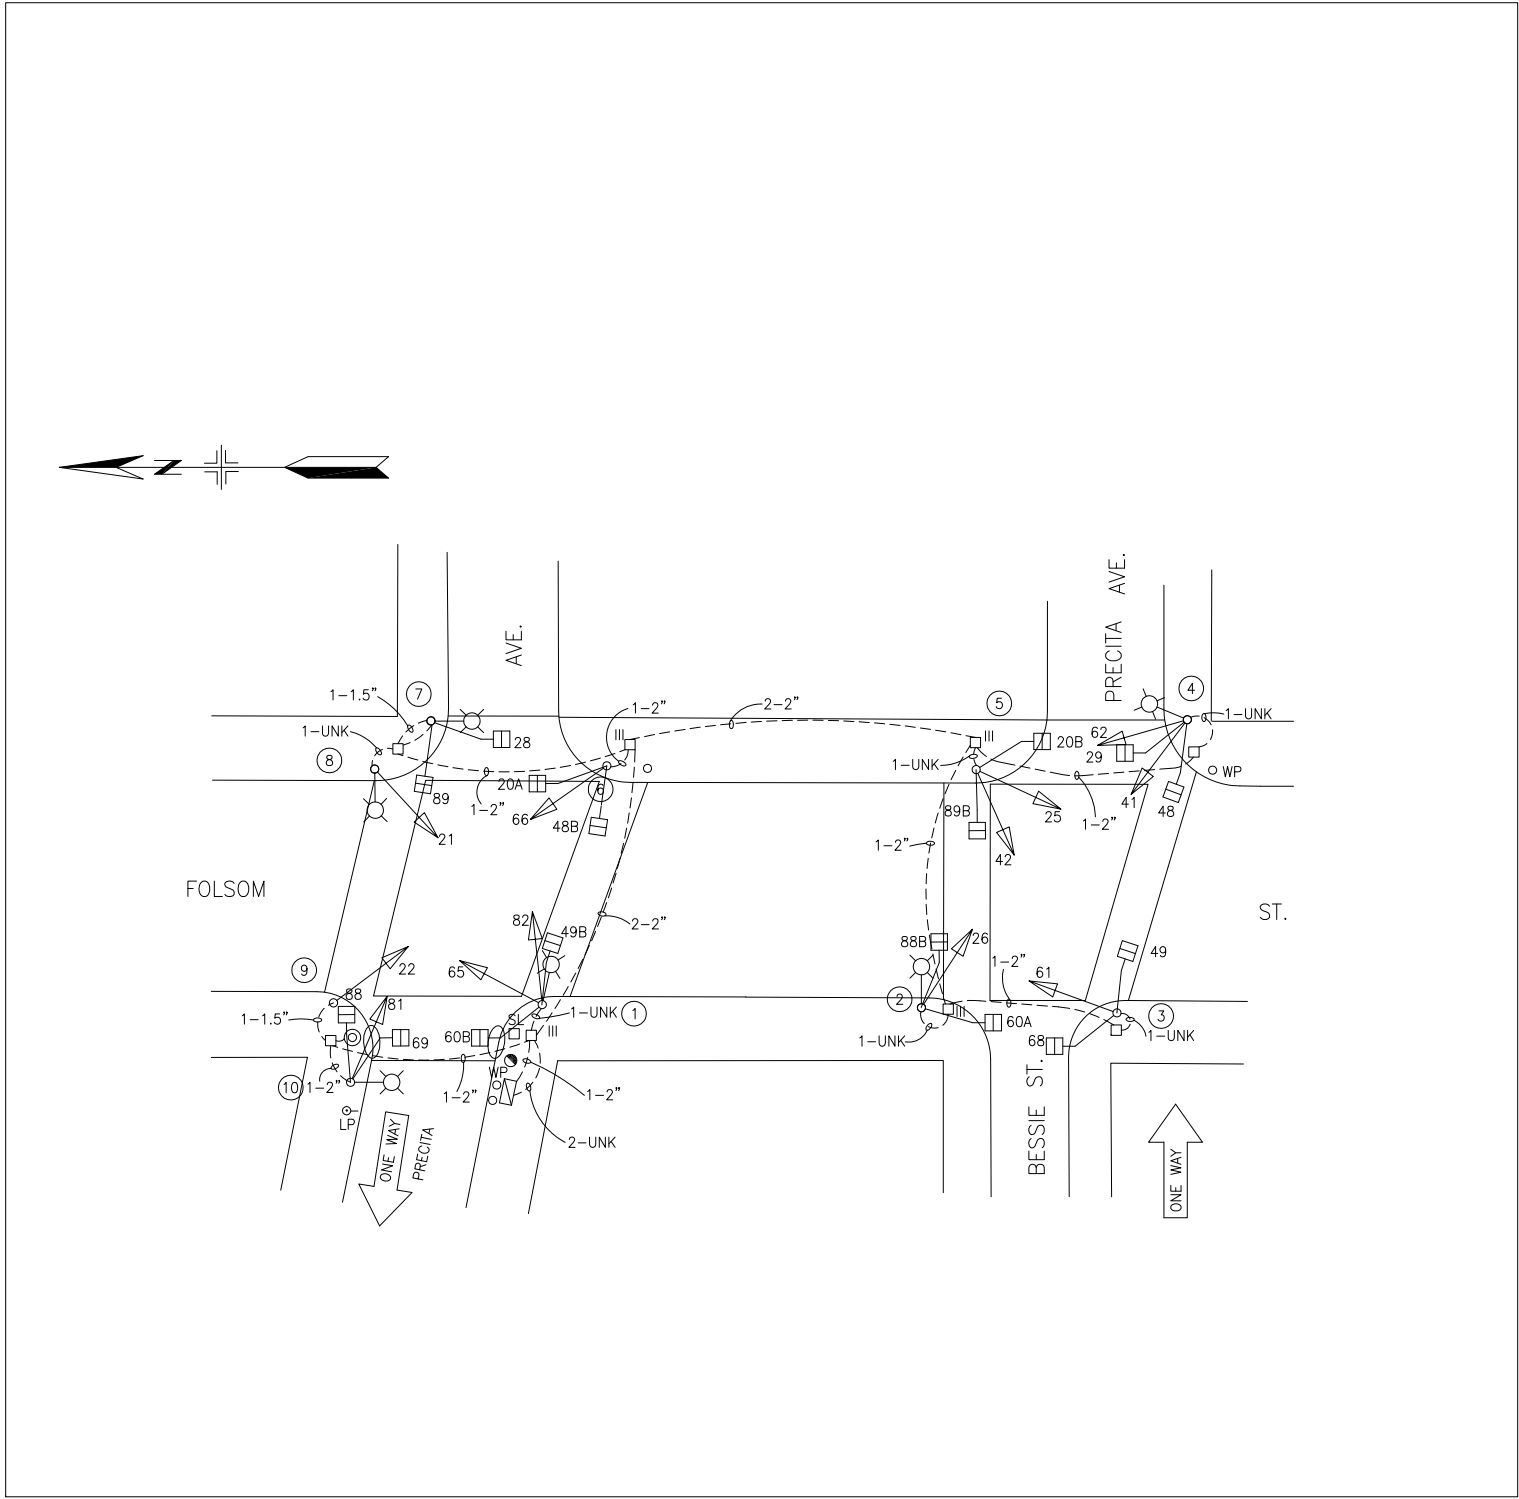

POLE AND EQUIPMENT SCHEDULE								
	TYPE OF POLE	VEHICLE SIGNAL			PEDESTRIAN SIGNAL			REMARKS
		No.	TYPE	MOUNTING (F/I)	No.	TYPE	MOUNTING (F/I)	
1	SL POLE	65	3S12"	SV-2-TA	60B	1S-IN	SP-2-T	
		82	3S12"		49B	1S-IN		
2	SL POLE	26	3S12"	SV-1-T	60A	1S-IN	SP-2-T-SF	
					88B	1S-IN		
3	T/S POLE	61	3S12"	TV-1	49	1S-IN	SP-2-T	
					68	1S-IN		
4	SL POLE	62			29	1S-IN	SP-2-T	
		41			48	1S-IN		
5	T/S POLE	42			20B	1S-IN	SP-1	
		25			89B	1S-IN	SP-1	
6	1-A (10')	66	3S12"	TV-1	20A	1S-IN	SP-1	
					48B	1S-IN	SP-1	
7	SL POLE				28	1S-IN	SP-2-T	
					89	1S-IN		
8	SL POLE	21	3S12"	SV-1-T				
9	1-A (10')	22	3S12"	SV-1-T				
10	STREET LIGHT POLE WITH 6' LUMINAIRE ARM, 120V, 150W HPS LUMINAIRE	81	3S12"	SV-1-T	88	1S-IN	SP-1	
					69	1S-IN	SP-1	

1	01/05/17	UPGRADE SIGNALS TO 12"			E.CHENB.WOO
0	10/29/89	UPGRADED BY 1286N; CONVERTED FROM AS-BUILTS			E.CHENB.WOO
NO.	DATE	DESCRIPTION			BY APP.
TABLE OF REVISIONS					
CHECK WITH TRACING TO SEE IF YOU HAVE LATEST REVISION					

REFERENCE INFORMATION
& FILE NO. OF SURVEYS



SAN FRANCISCO MUNICIPAL TRANSPORTATION AGENCY
CITY AND COUNTY OF SAN FRANCISCO

DRAWN: DATE:
EC 8/2016
CHECKED: DATE:
BW 8/2016

SCALE:

AS SHOWN

SHEET OF SHEETS

1 OF 1

TRAFFIC SIGNAL INVENTORY DIAGRAM

BESSIE ST, FOLSOM ST, AND PRECITA AVE.

CNN NO.

21175000

REV NO.

1

FILE NAME:
DATE:

EXTERNAL REFERENCES:
SCALE FACTOR: 240
PLOT SCALE: 1"=1'

ORIGIN: