




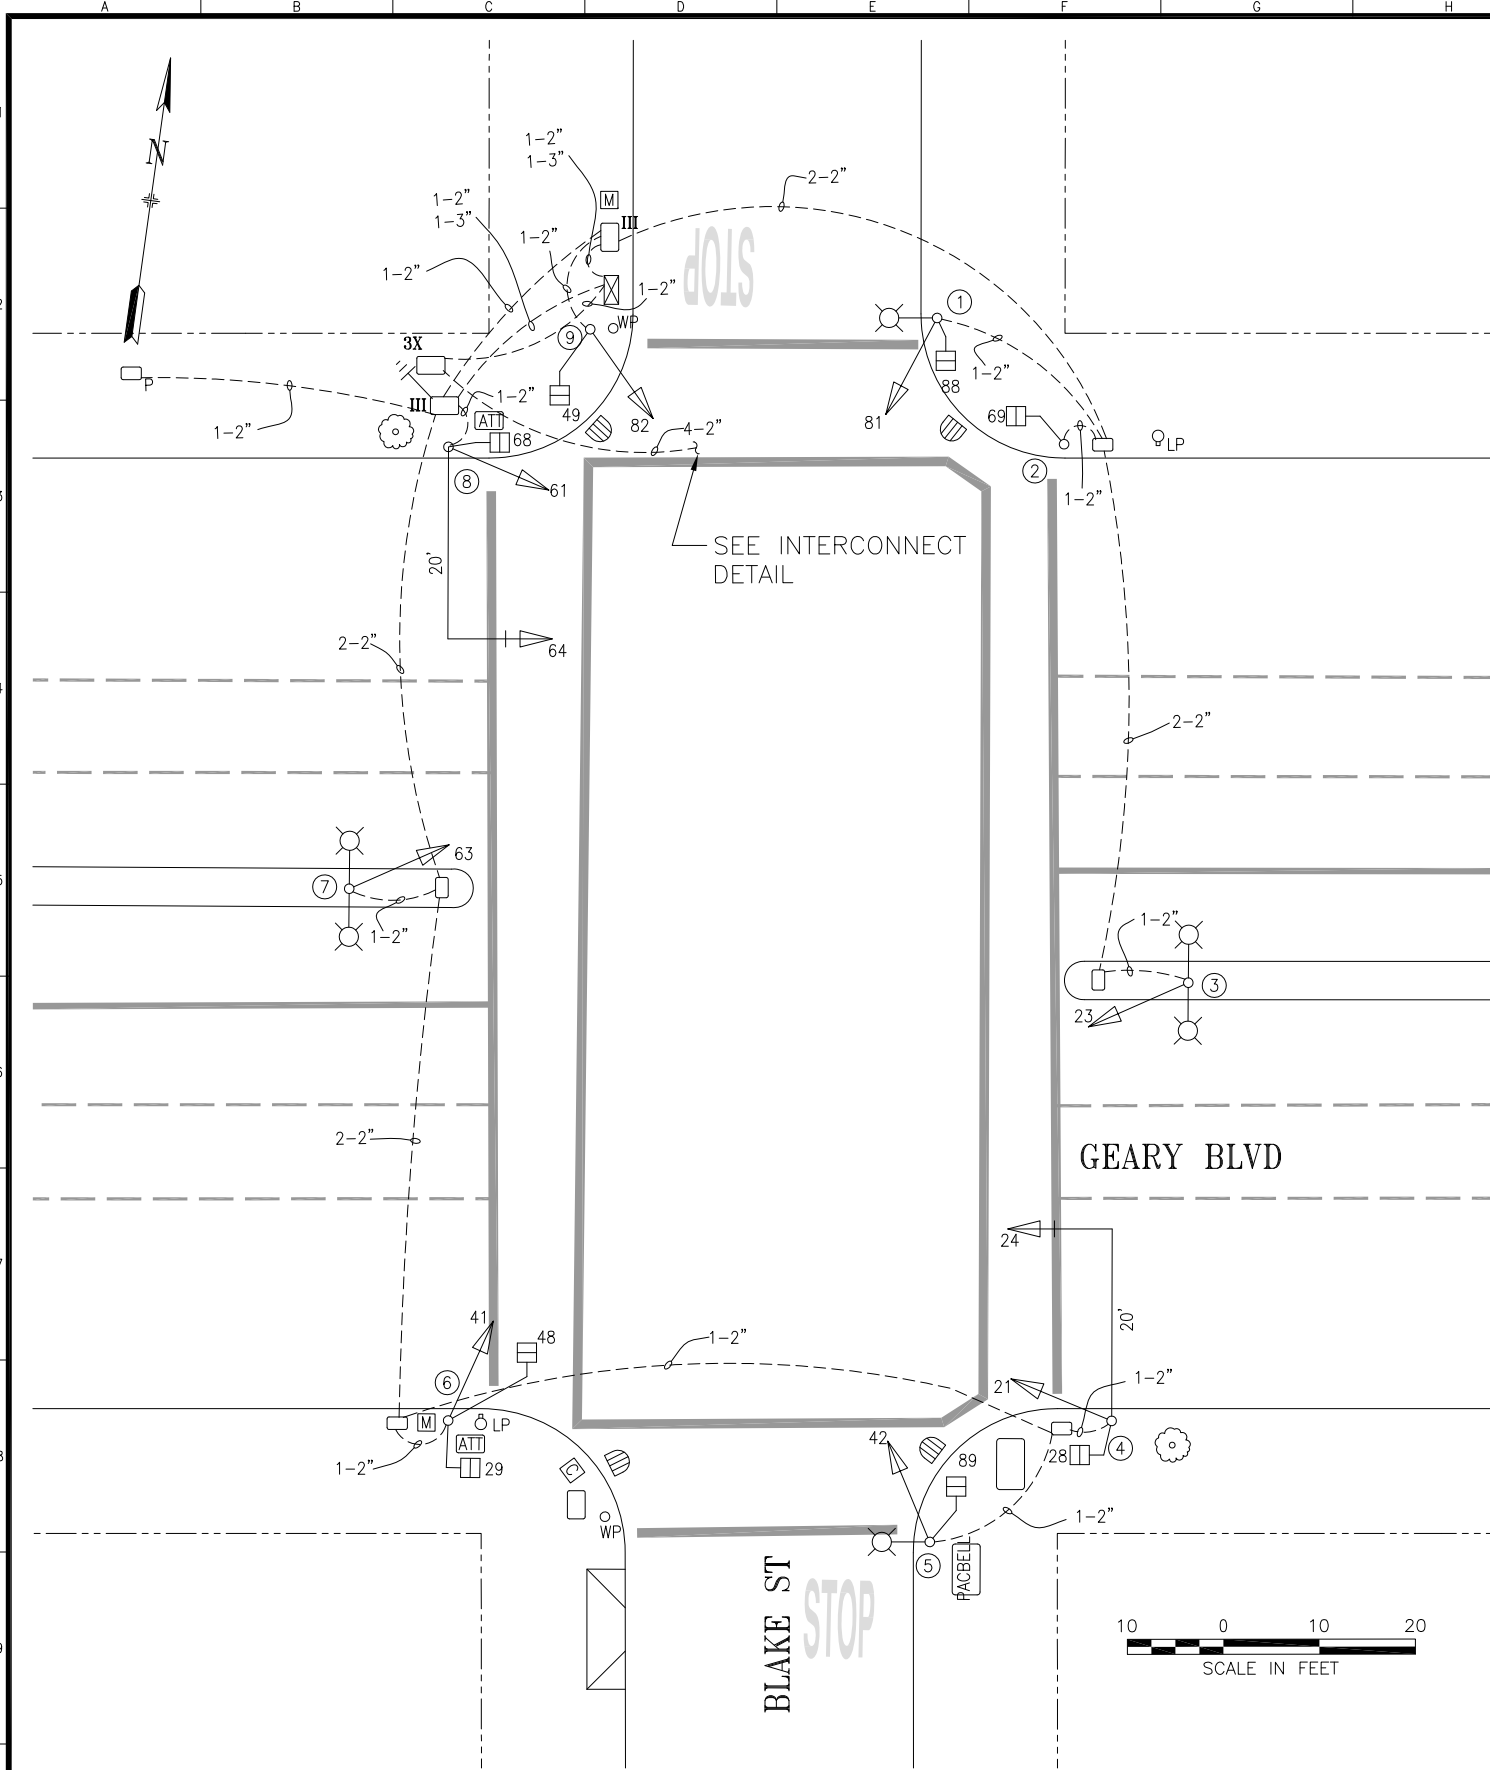

POLE AND EQUIPMENT SCHEDULE											
POLE No.	TYPE OF POLE	LUMINAIRE VOLTAGE/ WATTAGE	VEHICLE SIGNAL					PEDESTRIAN SIGNAL			REMARKS
			No.	TYPE	MOUNTING	VISORS	LOUVERS	No.	TYPE	MOUNTING	
①	CITY STANDARD STREET LIGHT	120-240 V/ 150 W	81	3S12"	SV-1-T	T		88	1S-COUNT	SP-1	
②	1-A (10')		22	3S8"	TV-1	T		69	1S-COUNT	SP-1	
③	EX SL		23	3S8"	SV-1	T					
④	16-1-100 W/ 20' MAST ARM		24 21	3S12" 3S8"	MAS SV-1-T	T T		28	1S-COUNT	SP-1	
⑤	CITY STANDARD STREET LIGHT	120-240 V/ 150 W	42	3S12"	TV-1-T	T		89	1S-COUNT	SP-1	
⑥	1-A (10')		41 62	3S12" 3S18"	SV-2-TA	T		29 48	1S-COUNT 1S-COUNT	SP-2-T-SF	
⑦	EX SL		63	3S8"	SV-1	T					
⑧	16-1-100 W/ 20' MAST ARM		64 61	3S12" 3S8"	MAS SV-1-T	T T		68	1S-COUNT	SP-1	
⑨	1-A (10')		82	3S12"	TV-1-T			49	1S-COUNT	SP-1	

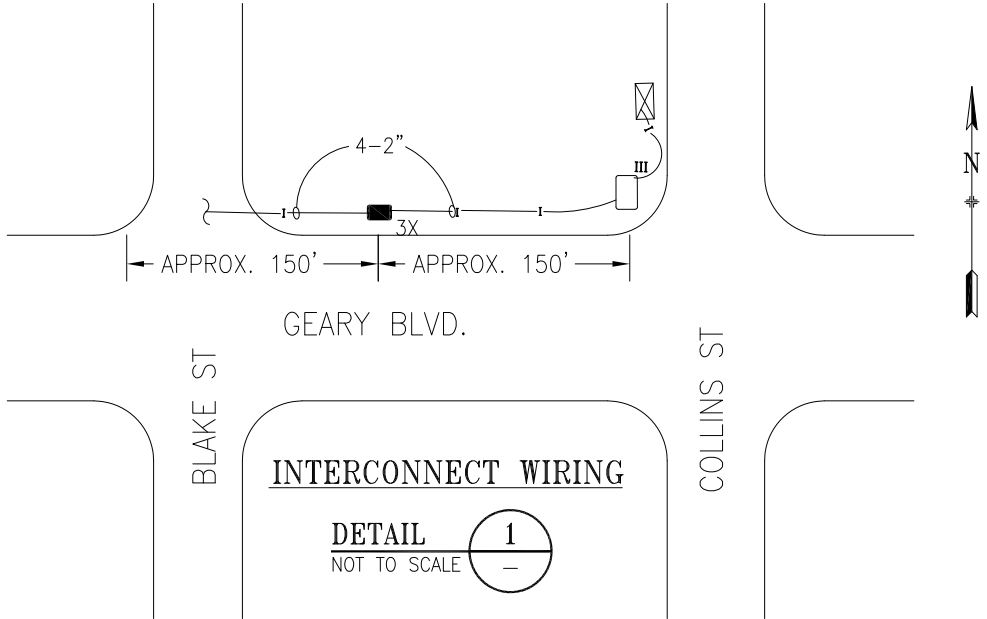

PHASE DIAGRAM

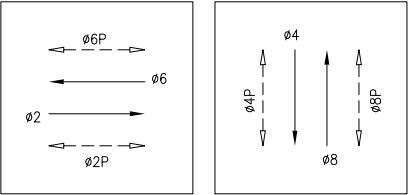

PHASE SEQUENCE

G		Y	R			GEARY BLVD (EB & WB) – Ø2 & Ø6	
R			G		Y	R	BLAKE ST (SB & NB) – Ø4 & Ø8
WM	FRH	RH				PED XING BLAKE ST (SS & NS) – Ø2P & Ø6P	
RH		WM	FRH		RH		PED XING GEARY BLVD (WS & ES) – Ø4P & Ø8P

TABLE OF REVISIONS		CHECK WITH TRACING TO SEE IF YOU HAVE LATEST REVISION	
NO.	DATE	DESCRIPTION	BY APP.
0	7/9/09	ACTIVATED NEW SIGNALS THROUGH CT 59 (1499J); CONVERTED FROM AS-BUILTS.	SS GD

REFERENCE INFORMATION & FILE NO. OF SURVEYS



SAN FRANCISCO MUNICIPAL TRANSPORTATION AGENCY
CITY AND COUNTY OF SAN FRANCISCO

DRAWN:	DATE:
SS	10/14
CHECKED:	DATE:
GD	10/14

SCALE:

AS SHOWN

SHEET OF SHEETS

1 OF 1

TRAFFIC SIGNAL INVENTORY DIAGRAM

BLAKE ST & GEARY BLVD

CNN NO.

26909000

REV NO.