


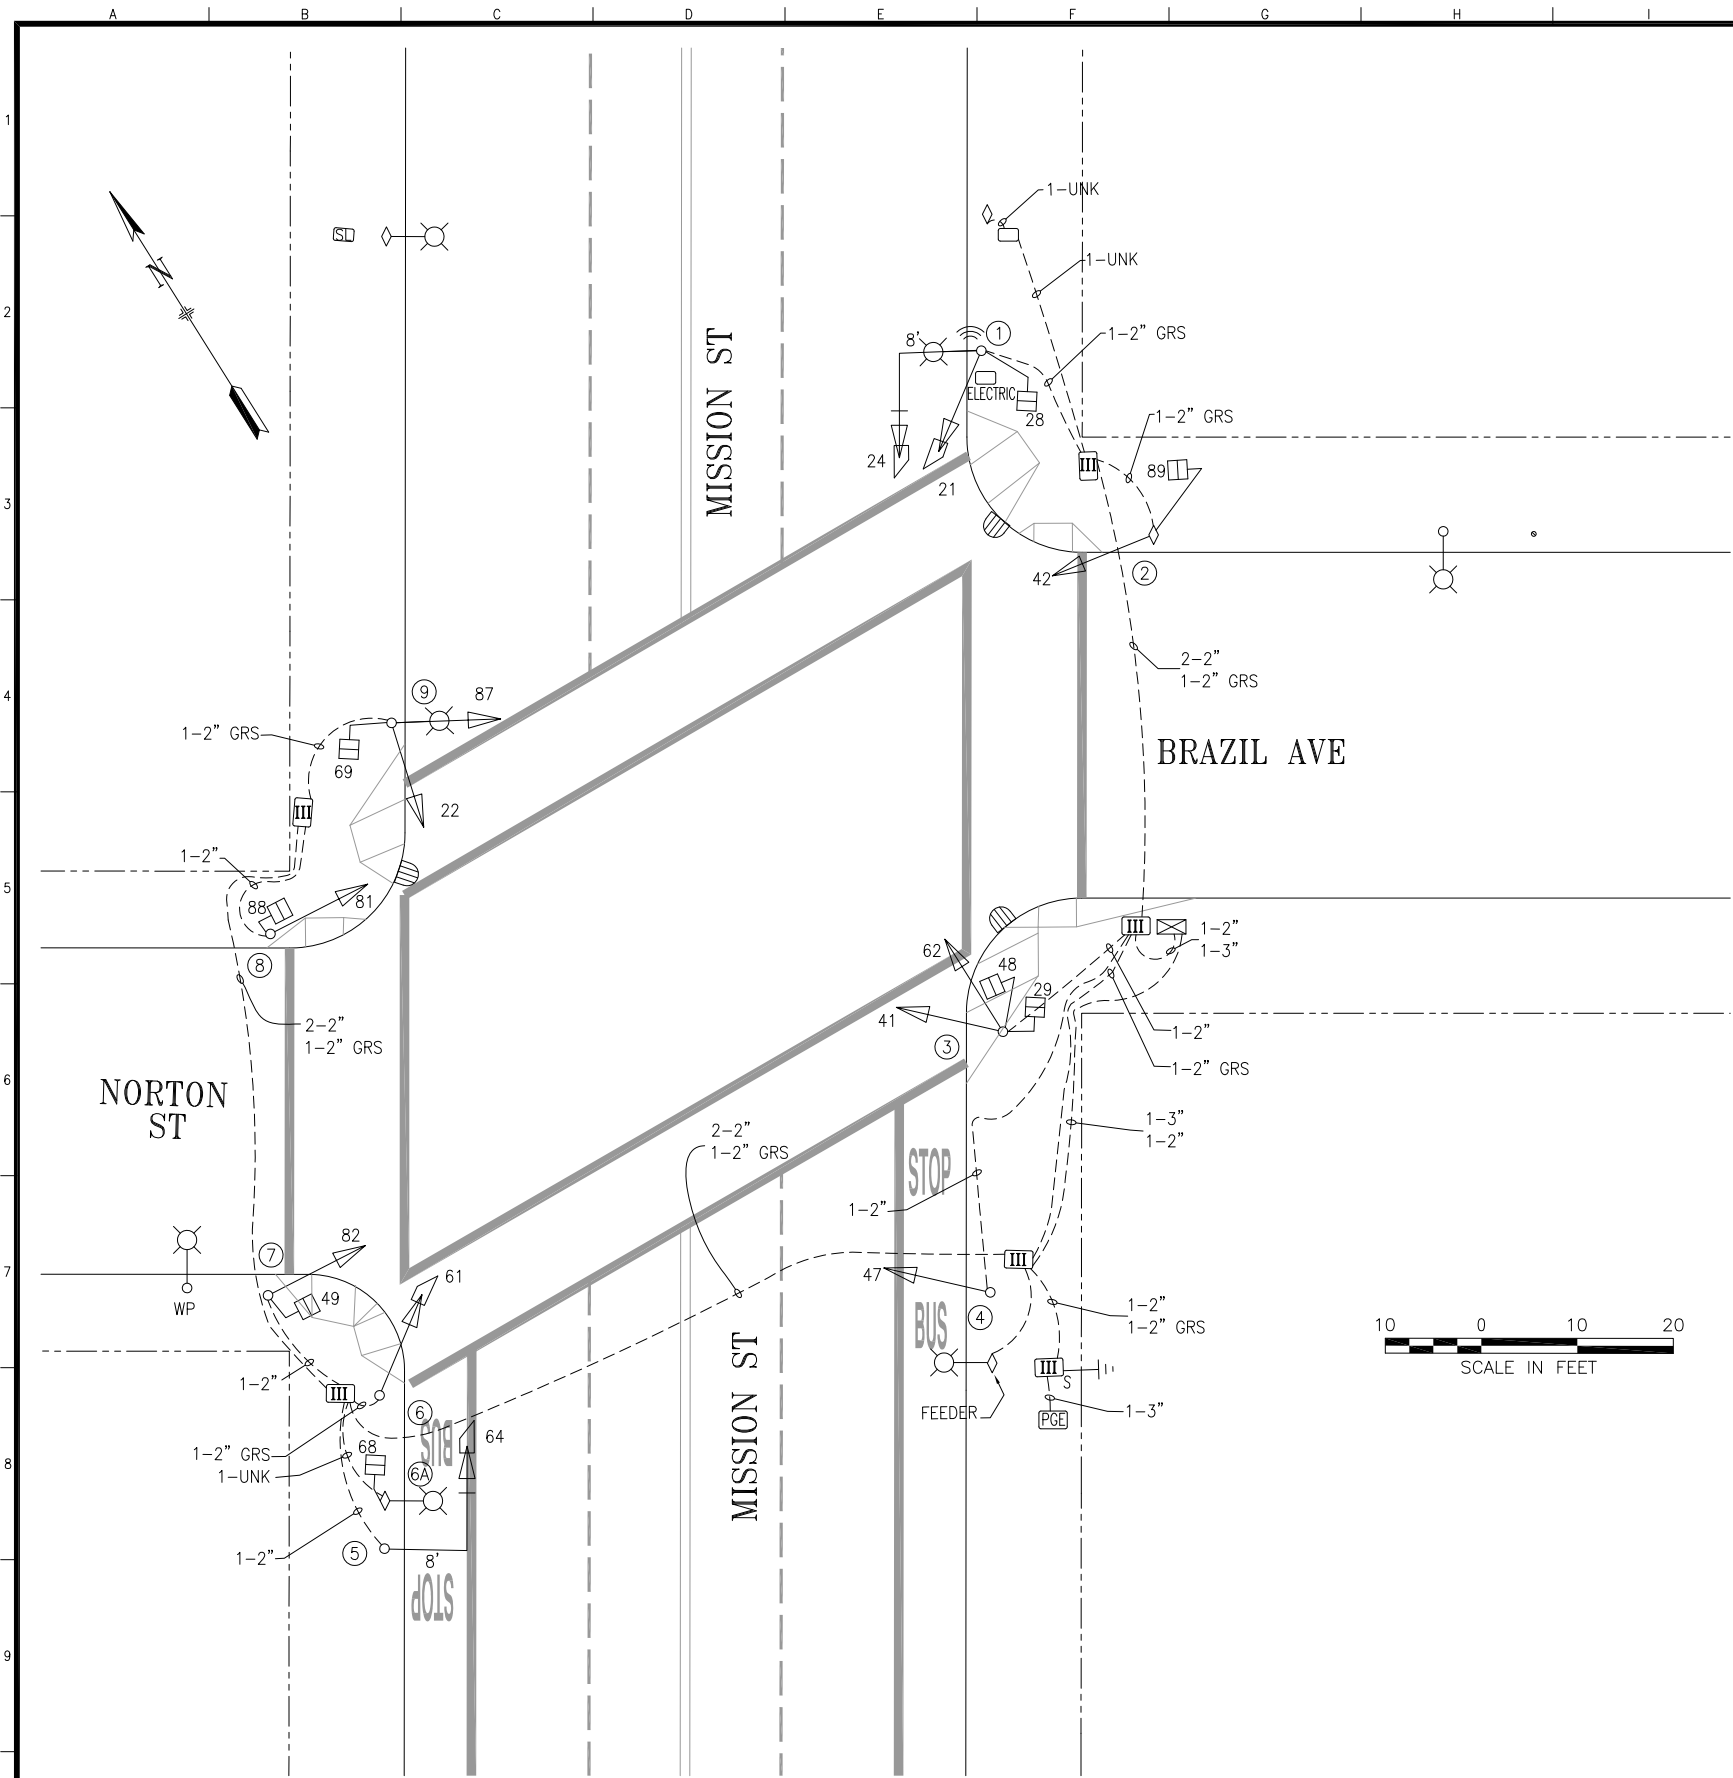

POLE AND EQUIPMENT SCHEDULE											
POLE No.	TYPE OF POLE	LUMINAIRE VOLTAGE/ WATTAGE	VEHICLE SIGNAL					PEDESTRIAN SIGNAL			REMARKS
			No.	TYPE	MOUNTING	VISORS	LOUVERS	No.	TYPE	MOUNTING	
①	17-2-100 W/ 8' MA AND 6' LA	150W HPS	21 24	3S12" 3S12"	SV-1-T MAS	RIGHT ANGLE RIGHT ANGLE		28	1S-COUNT	SP-1	BACKPLATE TSP EQUIPMENT
②	CUT OFF MUNI POLE		42	3S12"	SV-1-T	T		89	1S-COUNT	SP-1-T	EXTERNAL CONDUIT
③	1-A (10')		41 62	3S12" 3S12"	TV-2-T-SFA	T T		29 48	1S-COUNT 1S-COUNT	SP-1 (22") SP-1-SF (12")	
④	1-A (13')		47	3S12"	TV-1-T	T					
⑤	16-2-100 W/ 8' MA		64	3S12"	MAS	RIGHT ANGLE					BACKPLATE
⑥	CUT OFF MUNI POLE		61	3S12"	SV-1-T	RIGHT ANGLE					EXTERNAL CONDUIT
⑥A	MUNI POLE							68	1S-COUNT	SP-1	
⑦	1-A (10')		82	3S12"	TV-1-T	T		49	1S-COUNT	SP-1	
⑧	1-A (10')		81	3S12"	TV-1-T	T		88	1S-COUNT	SP-1	
⑨	CITY STANDARD SL W/ 6' LA	150W HPS	22 87	3S12" 3S12"	SV-1-T SV-1-T	T T		69	1S-COUNT	SP-1	MOUNT 87 14 FEET HIGH ON WEST SIDE OF POLE

TABLE OF REVISIONS			CHECK WITH TRACING TO SEE IF YOU HAVE LATEST REVISION		
NO.	DATE	DESCRIPTION	BY	APP.	
2	05/03/21	UPDATE PER FIELD: TSP EQUIP. ON POLE 1	E.TANG	B.TANNER	
1	03/28/17	SIGNAL UPGRADED THROUGH 2595J	D.YEUNG	G.DELEON	

REFERENCE INFORMATION & FILE NO. OF SURVEYS



SAN FRANCISCO MUNICIPAL TRANSPORTATION AGENCY

CITY AND COUNTY OF SAN FRANCISCO

DRAWN:	DATE:
A.SCALES	5/26/2017
CHECKED:	DATE:
G.DELEON	6/2/2017

SCALE:
AS SHOWN
SHEET OF SHEETS
1 OF 1

TRAFFIC SIGNAL INVENTORY DIAGRAM
BRAZIL AVENUE, MISSION STREET, AND NORTON STREET

CNN NO.
21769000
REV NO.
2