


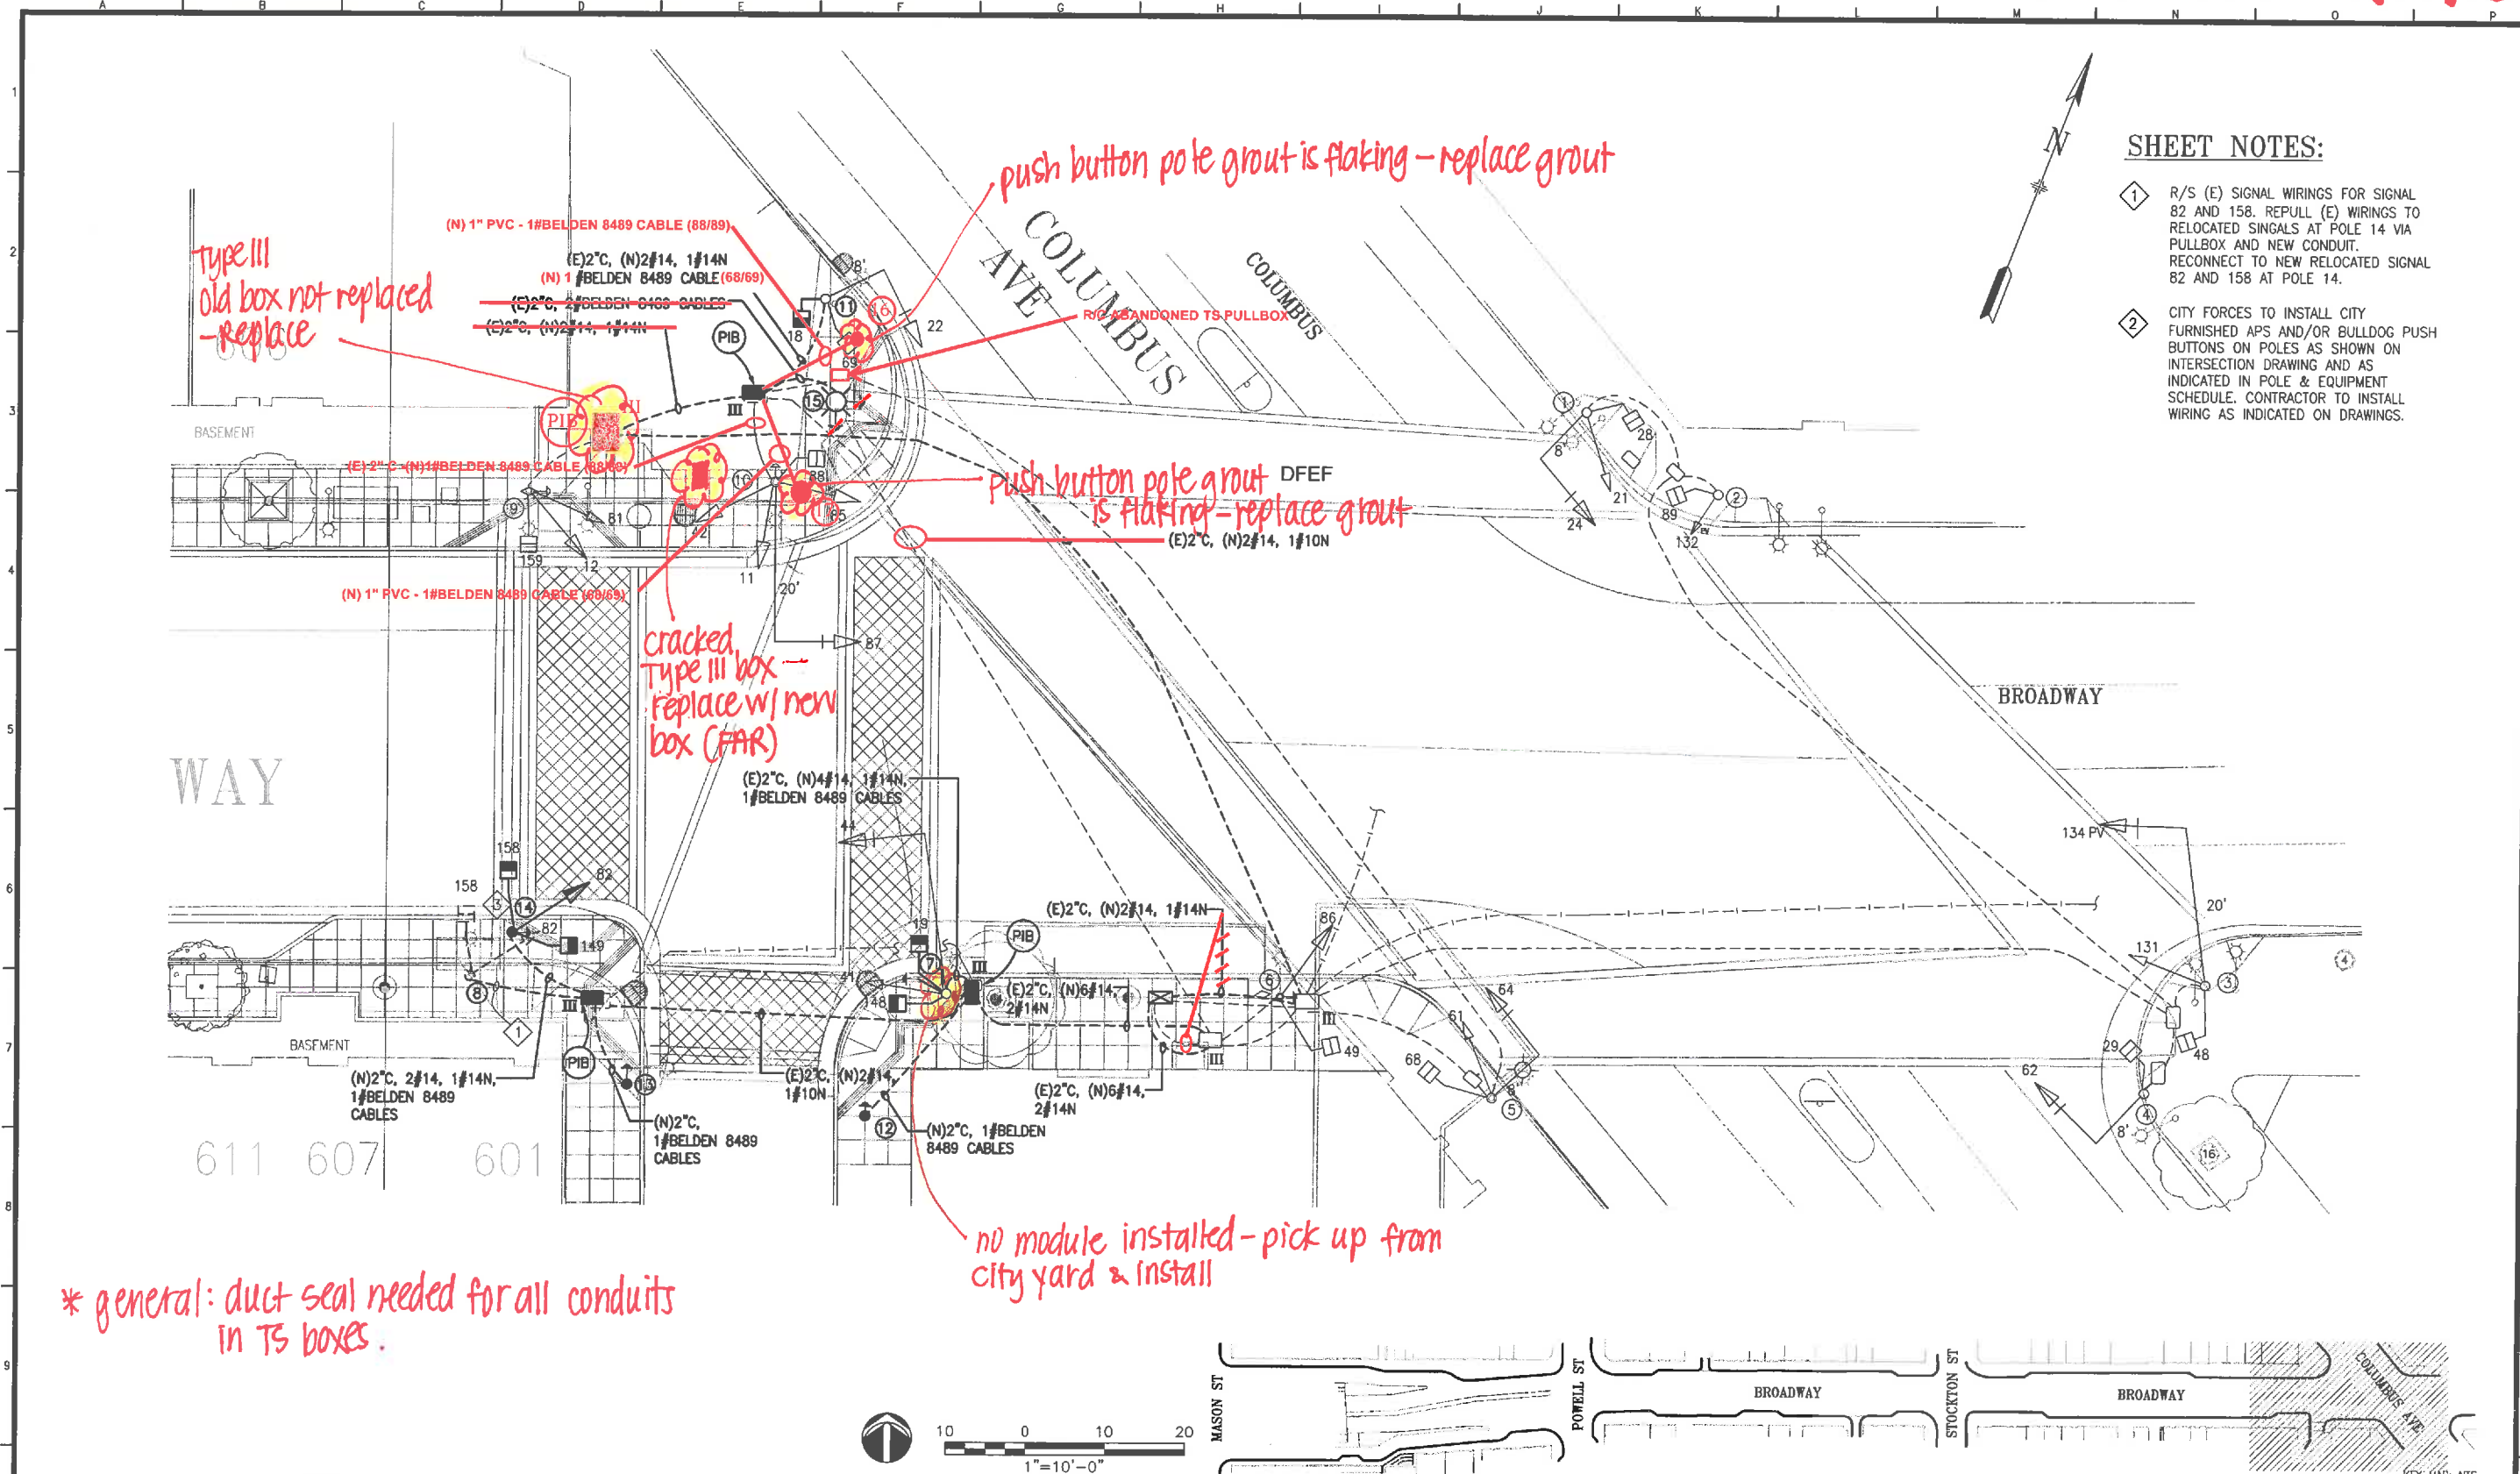

- SHEET NOTES:**
- 1 R/S (E) SIGNAL WIRINGS FOR SIGNAL 82 AND 158. REPULL (E) WIRINGS TO RELOCATED SIGNALS AT POLE 14 VIA PULLBOX AND NEW CONDUIT. RECONNECT TO NEW RELOCATED SIGNAL 82 AND 158 AT POLE 14.
 - 2 CITY FORCES TO INSTALL CITY FURNISHED APS AND/OR BULLDOG PUSH BUTTONS ON POLES AS SHOWN ON INTERSECTION DRAWING AND AS INDICATED IN POLE & EQUIPMENT SCHEDULE. CONTRACTOR TO INSTALL WIRING AS INDICATED ON DRAWINGS.

* general: duct seal needed for all conduits in TS boxes.

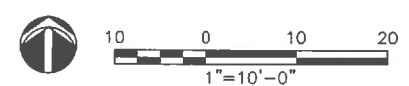


TABLE OF REVISIONS				
NO.	DATE	DESCRIPTION	BY	APP.
CHECK WITH TRACING TO SEE IF YOU HAVE LATEST REVISION				

REFERENCE INFORMATION
& FILE NO. OF SURVEYS



INFRASTRUCTURE DIVISION
DEPARTMENT OF PUBLIC WORKS
CITY AND COUNTY OF SAN FRANCISCO



DESIGNED: DATE: 6/12/2015
DW/WC
DRAWN: DATE: 6/12/2015
CC/WC
CHECKED: DATE: 6/12/2015
P.THWIN

APPROVED
SECTION MANAGER
DEPUTY DIVISION MANAGER
DIVISION MANAGER

SCALE:
1"=10'-0"
SHEET OF SHEETS

**BROADWAY CHINATOWN
STREETSCAPE IMPROVEMENTS**

**TRAFFIC SIGNAL PLAN
BROADWAY, GRANT AND COLUMBUS**

CONTRACT NO. 1075J
DRAWING NO. E-3.0
FILE NO. 102,161
REV. NO. 1

SHEET NOTES:

1 CITY FORCES TO INSTALL CITY FURNISHED APS AND/OR BULLDOG PUSH BUTTONS ON POLES AS SHOWN ON INTERSECTION DRAWING AND AS INDICATED IN POLE & EQUIPMENT SCHEDULE. CONTRACTOR TO INSTALL WIRING AS INDICATED ON DRAWINGS.

POLE AND EQUIPMENT SCHEDULE											
POLE No.	TYPE OF POLE	LUMINAIRE (HPS)	VEHICLE SIGNAL					PEDESTRIAN SIGNAL			REMARKS
		VOLTAGE/ WATTS	No.	TYPE	MOUNTING	VISORS	LOUVERS	No.	TYPE	MOUNTING	
1	16-1-70 W/ 8' MAST ARM		24 21	3S12" 3S8"	MAS SV-1-T	T T		28	1S-COUNT	SP-1	BACKPLATE
2	1-A (10')		132	3S12"PV	TV-1-T	PV		89	1S-COUNT	SP-1	
3	16-1-70 W/ 20' MAST ARM		134 131	3S12"PV 3S8"	MAS SV-1-T	PV T		48	1S-COUNT	SP-1 (22')	BACKPLATE
4	16-1-70 W/ 8' MAST ARM		62	3S12"	MAS	T		29	1S-COUNT	SP-1	BACKPLATE
5	17B-1-70 W/ 8' MAST ARM AND 6' LUMINAIRE	120V/200W	64 61	3S12" 3S8"	MAS SV-1-T	T T		68	1S-COUNT	SP-1	BACKPLATE
6	MUNI		86	3S12"	SV-1-T	T		49	1S-COUNT	SP-1-T	EXTERNAL CONDUIT
7	16-1-70 W/ 20' MAST ARM		44 52 41	3S12" 3S12"-FY 3S8"	MAS SV-2-TC	T T T		19 148	1S-COUNT 1S-COUNT	SP-1 (22') SP-1 (22')	BACKPLATE R/S SIGNALS 82 AP80
8	1-A (10')		51 82	3S12"-FY 3S8"	TV-2-T-SPB	T Y		158	1S-COUNT	SP-1 (22')	R/S POLE AND SIGNALS
9	MUNI		12 81	3S12"-FY 3S8"	SV-2-TC	T T		159	1S-COUNT	SP-1-T	EXTERNAL CONDUIT APS
10	19-2-100 WITH 20' MAST ARM		87 11 42 85	3S12" 3S12"-FY 3S12" 3S12"	MAS SV-3-TA	T T T T		88	1S-COUNT	SP-1	BACKPLATE R/S AP80
11	19-2-100 WITH 6' MAST ARM		22	3S12"	MAS	T		69 18	1S-COUNT 1S-COUNT	SP-1 SP-1	BACKPLATE MOUNT SIGNAL 18 • 9'
12	PPB POLE										AP80 1
13	PPB POLE										AP80 1
14	1-A (10')		82	3S12"	TV-1-T	T		149 138	1S-COUNT 1S-COUNT	SP-2-T	AP80 1
15	POST TOP STREETLIGHT										AP80 1

- 16 PPB POLE APS 1
- 17 PPB POLE APS 1

NO.	DATE	DESCRIPTION	BY	APP.
TABLE OF REVISIONS				
CHECK WITH TRACING TO SEE IF YOU HAVE LATEST REVISION				

REFERENCE INFORMATION
& FILE NO. OF SURVEYS



INFRASTRUCTURE DIVISION
DEPARTMENT OF PUBLIC WORKS
CITY AND COUNTY OF SAN FRANCISCO



DESIGNED: DATE: 6/12/2015
DW/WC
DRAWN: DATE: 6/12/2015
CC/WC
CHECKED: DATE: 6/12/2015
P.THWIN

APPROVED
SECTION MANAGER DATE:
DEPUTY DIVISION MANAGER DATE:
DIVISION MANAGER DATE:

SCALE:
NONE
SHEET OF SHEETS

BROADWAY CHINATOWN
STREETSCAPE IMPROVEMENTS

POLE AND EQUIPMENT SCHEDULE
BROADWAY, GRANT AND COLUMBUS

CONTRACT NO.
1075J
DRAWING NO.
E-3.1
FILE NO.
102,162
REV. NO.
1