


Broadway & Davis St

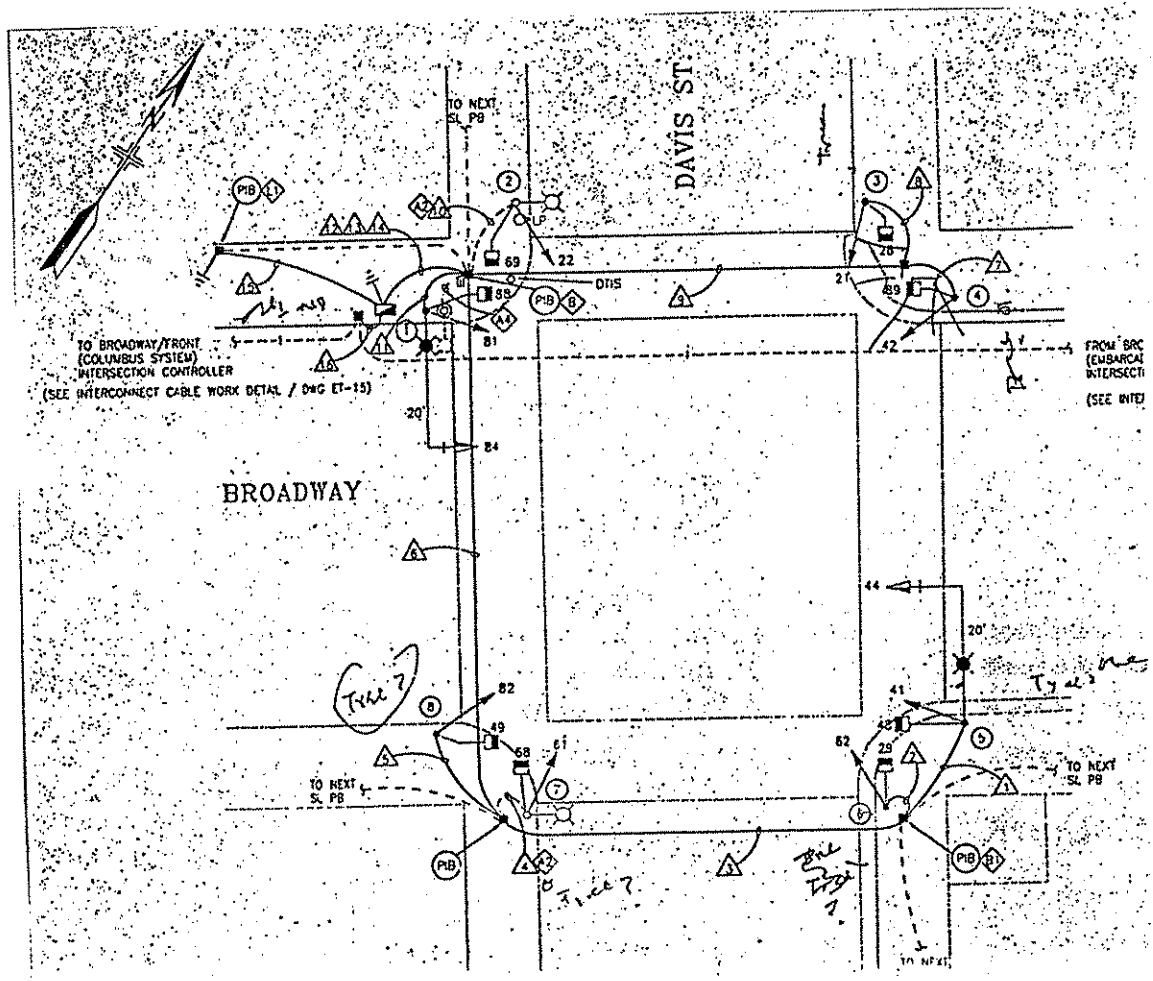

2/15/02
8/21/01

LINE	FUNC.	MATL	SIGNAL NO.	MAKE	NO. OF SECT.	SIZE	VISOR	B.P. OR LOUVERS	MOUN'T	PED SIGNAL NO.	LEGEND	MESSAGE		MAKE	MOUN'T
												ELEMENT	COLOR		
1	L	S	81	TCT	3S	8" RYG	T	—	SV-1	88	T	15-IN	W/GR	ICC	SP-1
2	L	S	84	TCT	3S	12" RYG	T	BP	MAS	61	T	15-IN	W/GR	ICC	SP-1
3	S	S	22	TCT	3S	8" RYG	T	—	SV-1	28	T	15-IN	W/GR	ICC	SP-1
4	S	S	21	TCT	3S	8" RYG	T	—	TV-1	89	T	15-IN	W/GR	ICC	SP-1
5	L	S	42	TCT	3S	8" RYG	T	—	TV-1	48	T	15-IN	W/GR	ICC	SP-1
6	S	S	41	TCT	3S	8" RYG	T	—	SV-1	29	T	15-IN	W/GR	ICC	SP-1
7	L	S	44	TCT	3S	12" RYG	T	BP	MAS	68	T	15-IN	W/GR	ICC	SP-1
8	S	S	62	TCT	3S	8" RYG	T	—	TV-1	49	T	15-IN	W/GR	ICC	SP-1
			61	TCT	3S	8" RYG	T	—	SV-1						
			82	TCT	3S	8" RYG	T	—	TV-1						

CONTROLLER CABINET SIZE : M Cabinet BASE CABINET :

COMMENTS :