


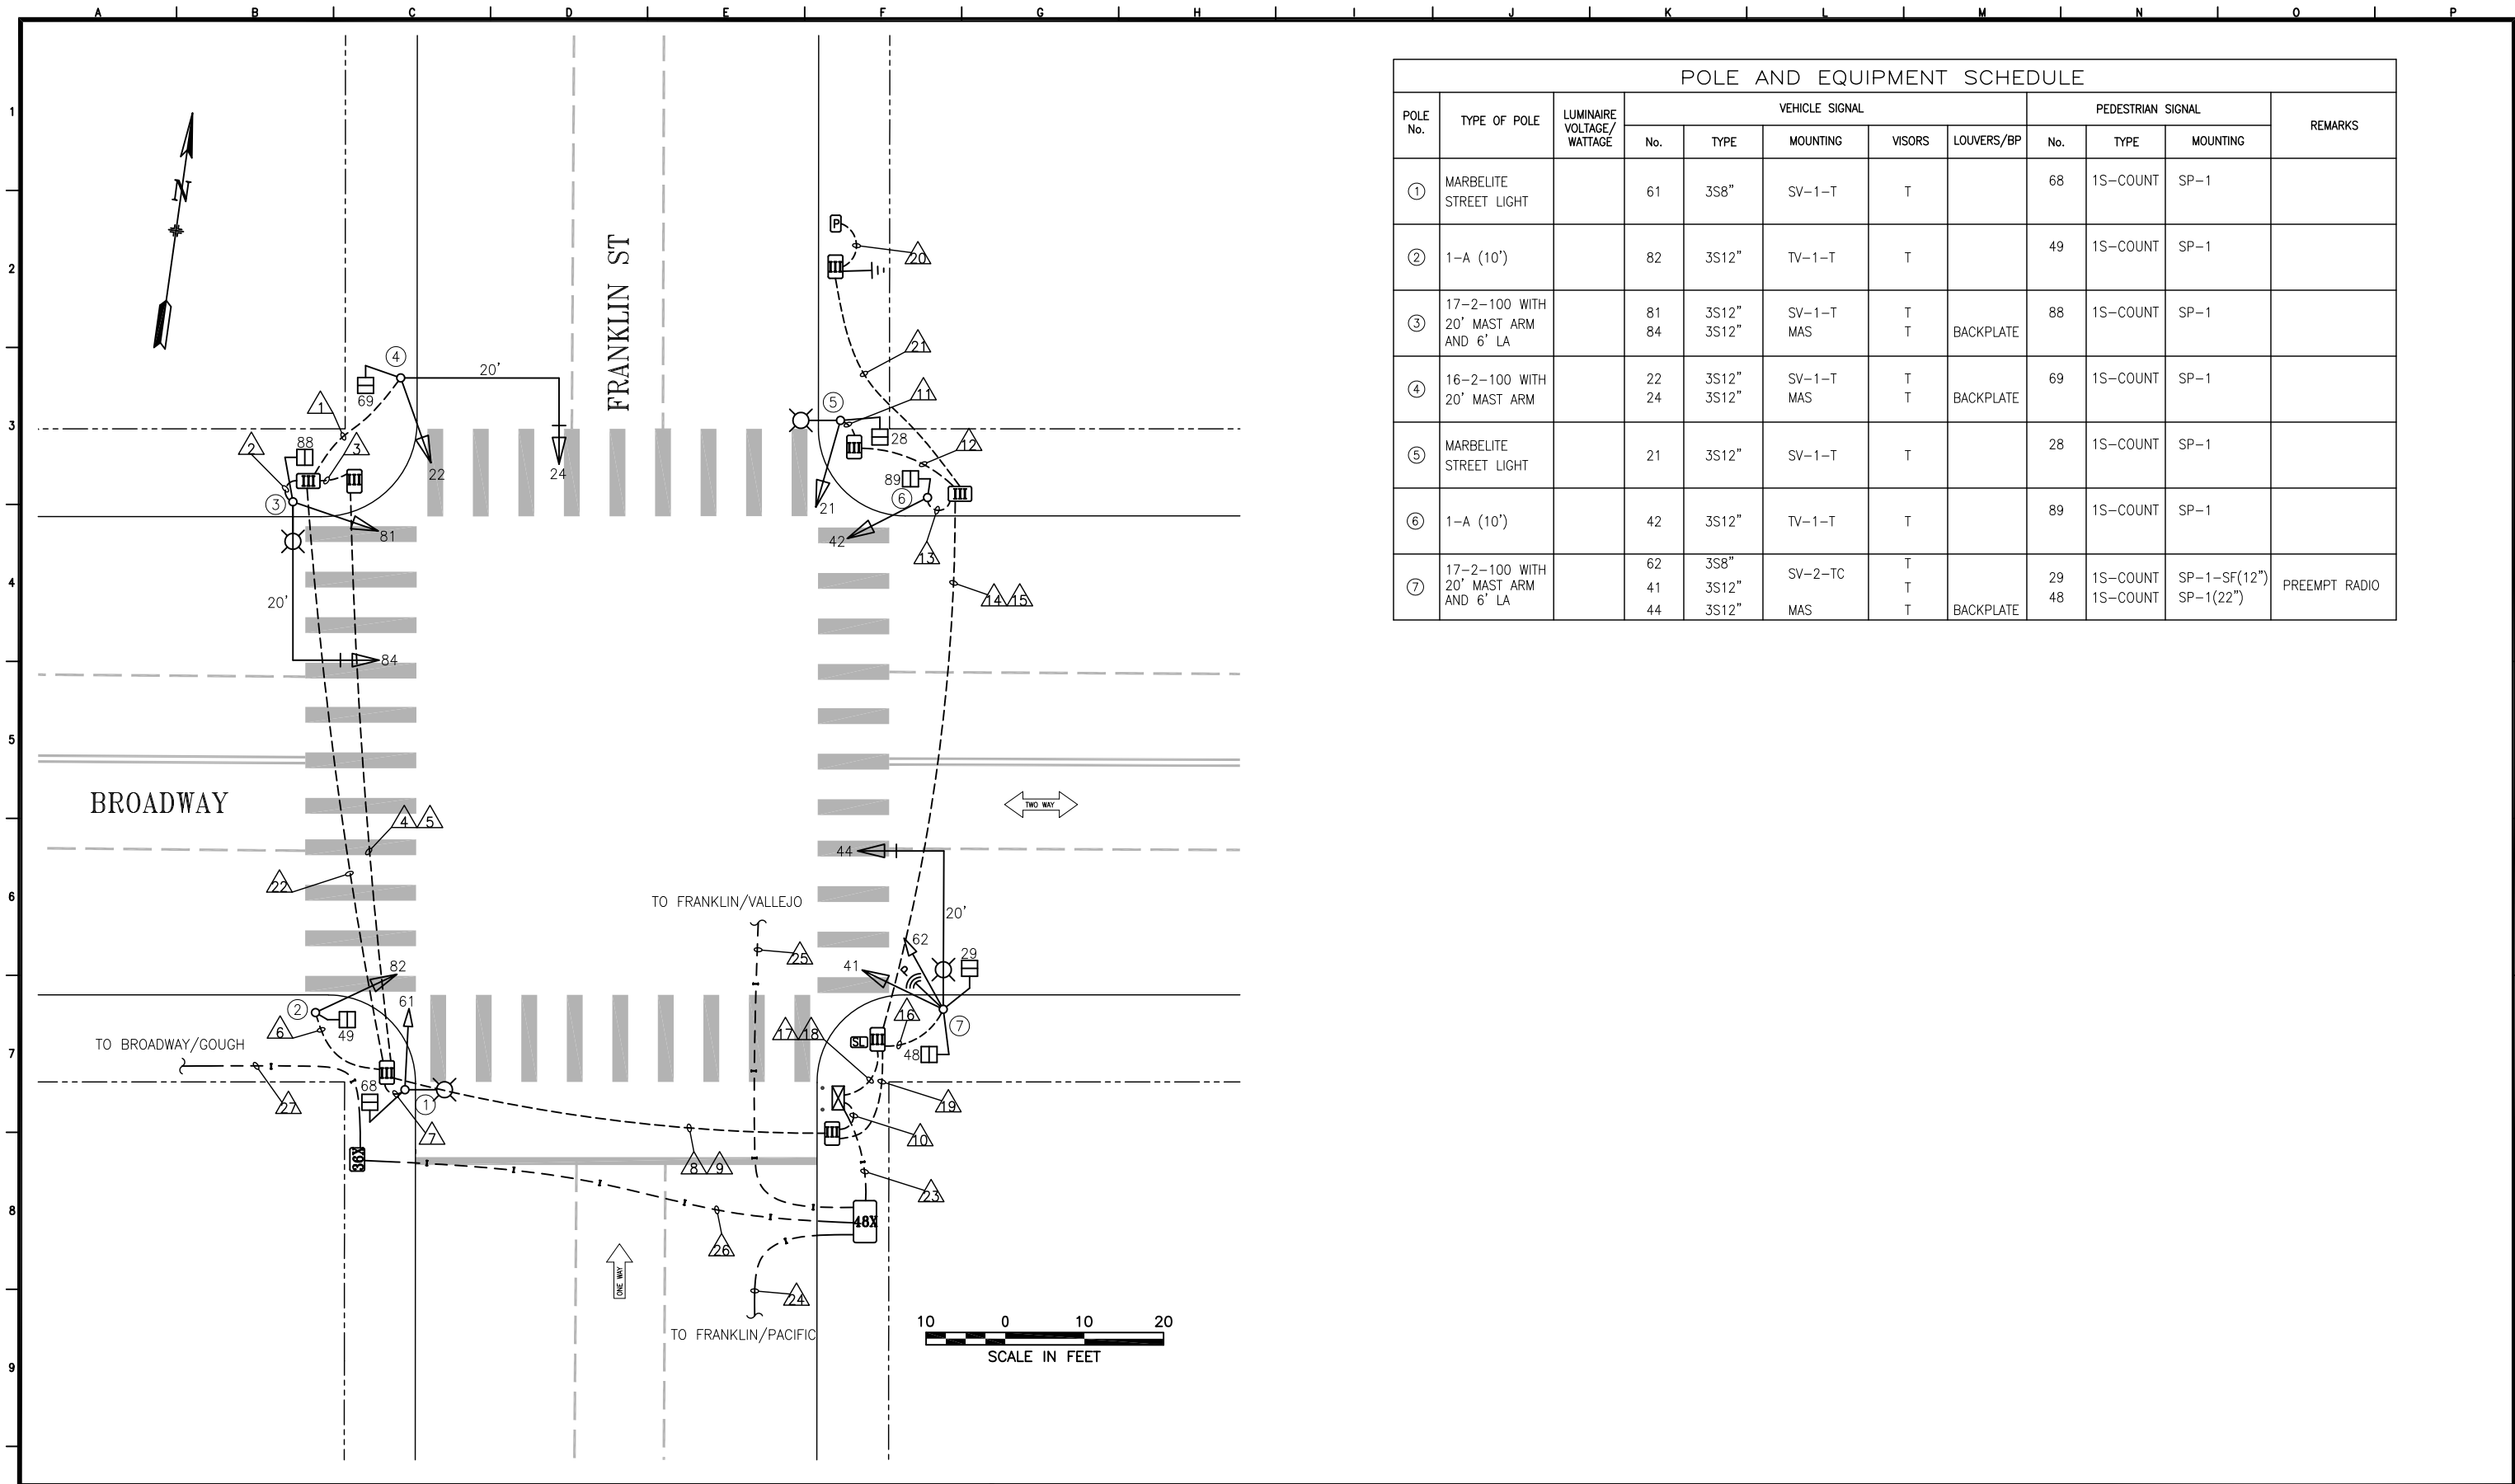

POLE AND EQUIPMENT SCHEDULE											
POLE No.	TYPE OF POLE	LUMINAIRE VOLTAGE/ WATTAGE	VEHICLE SIGNAL					PEDESTRIAN SIGNAL			REMARKS
			No.	TYPE	MOUNTING	VISORS	LOUVERS/BP	No.	TYPE	MOUNTING	
①	MARBELITE STREET LIGHT		61	3S8"	SV-1-T	T		68	1S-COUNT	SP-1	
②	1-A (10')		82	3S12"	TV-1-T	T		49	1S-COUNT	SP-1	
③	17-2-100 WITH 20' MAST ARM AND 6' LA		81 84	3S12" 3S12"	SV-1-T MAS	T T	BACKPLATE	88	1S-COUNT	SP-1	
④	16-2-100 WITH 20' MAST ARM		22 24	3S12" 3S12"	SV-1-T MAS	T T	BACKPLATE	69	1S-COUNT	SP-1	
⑤	MARBELITE STREET LIGHT		21	3S12"	SV-1-T	T		28	1S-COUNT	SP-1	
⑥	1-A (10')		42	3S12"	TV-1-T	T		89	1S-COUNT	SP-1	
⑦	17-2-100 WITH 20' MAST ARM AND 6' LA		62 41 44	3S8" 3S12" 3S12"	SV-2-TC MAS	T T T	 BACKPLATE	29 48	1S-COUNT 1S-COUNT	SP-1-SF(12") SP-1(22")	PREEMPT RADIO

△	12/26/22	INSTALL PREEMPT RADIO ON POLE 7 PER SRC 2022-261	S. ALEXANDER	M. VELASCO	
△	03/29/17	SIGNALS 61 & 62 ACTIVATED PER SRC 2017-059	J. HORNPOSTEL	G. DE LEON	
△	08/17/16	SIGNAL UPGRADE BY 2596J; CONVERTED FROM AS-BUILTS	J. HORNPOSTEL	G. DE LEON	
NO.	DATE	DESCRIPTION	BY	APPROVED	
TABLE OF REVISIONS					
CHECKOUT DRAWING THROUGH THE SID CUSTODIAN FOR THE LATEST REVISION					



SFMTA

DRAWN BY: J. HORNPOSTEL	DATE: 11/10/2022
CHECKED BY: G. DE LEON	DATE: 11/10/2022

SCALE AS SHOWN
SHEET OF SHEETS 01 OF 02

TRAFFIC SIGNAL INVENTORY DIAGRAM
BROADWAY & FRANKLIN ST

CNN NO: 26555000
REV NO: 2

