


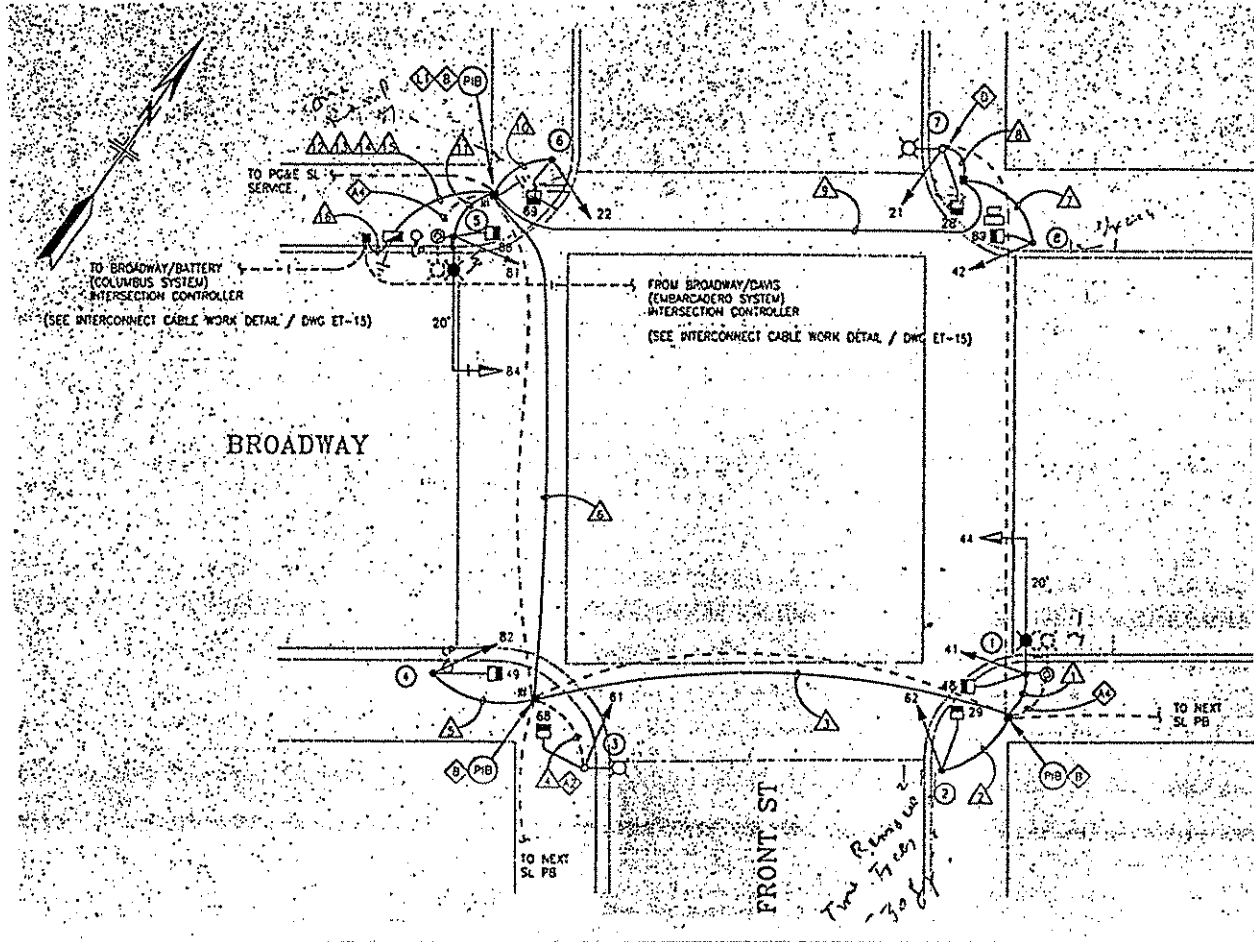

2/15/02
8/20/04

F	FUNC.	MAT'L	SIGNAL NO.	MAKE	NO. OF SECT.	SIZE	VISOR	B.P. OR LOUVERS	MOUN'T	PED SIGNAL NO.	LEGEND	MESSAGE		MAKE	MOUN'T
												ELEMENT	COLOR		
1	E	S	44	TCT	35	12' RYG	T	BP	MAS	48	T	15-IN	N/R	ICC	SP-1
2	S	S	41	TCT	35	8' RYG	T	-	SV-1	29	T	15-IN	N/R	ICC	SP-1
3	L	S	62	TCT	35	8' RYG	T	-	TV-1	68	T	15-IN	N/R	ICC	SP-1
4	S	S	61	TCT	35	8' RYG	T	-	SV-1	49	T	15-IN	N/R	ICC	SP-1
5	L	S	82	TCT	35	8' RYG	T	-	TV-1	88	T	15-IN	N/R	ICC	SP-1
6	S	S	81	TCT	35	8' RYG	T	-	SV-1	69	T	15-IN	N/R	ICC	SP-1
7	L	S	84	TCT	35	12' RYG	T	BP	MAS	28	T	15-IN	N/R	ICC	SP-1
8	S	S	22	RT	35	8' RYG	T	-	TV-1	89	T	15-IN	N/R	ICC	SP-1
			21	TCT	35	8' RYG	T	-	SV-1						
			42	TCT	35	8' RYG	T	-	TV-1						

CONTROLLER CABINET SIZE : M Cabinet BASE CABINET: _____

COMMENTS :