


BROADWAY & LARKIN

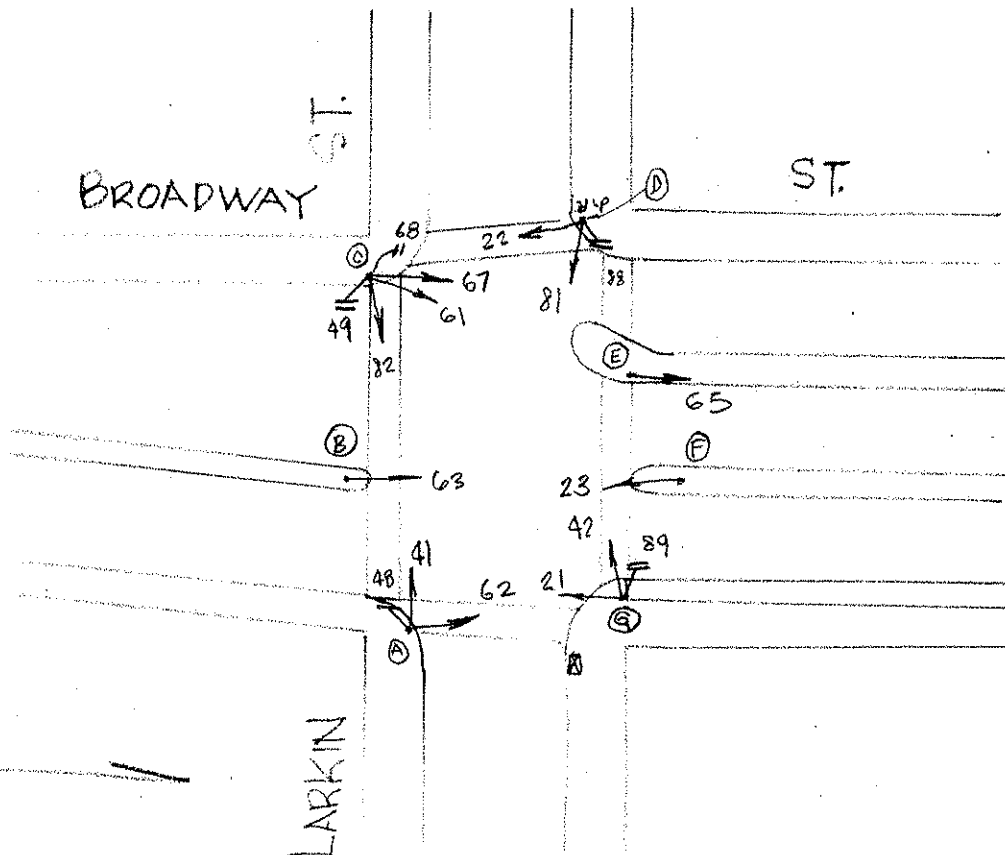

(SRC 2004-008)

2-5-04

POLE	FUNC.	MAT'L	SIGNAL NO.	MAKE	NO. OF SECT.	SIZE	VISOR	B.P. OR LOUVERS	MOUN'T	PED SIGNAL NO.	LEGEND	MESSAGE		MAKE	MOUN'T
												ELEMENT	COLOR		
A	S	S	62	GA	3	8"	FL 8"	NO	T	48	W/DW	GRD	W/OR	ED	S
B	L	S	41	GA	3	8"	FL 8"	NO	T	49	W/DW	GRD	W/OR	ED	S
C	L	S	63	GA	3	12"	T 12"	NO	S	88	W/DW	GRD	W/OR	ED	S
D	L	S	82	GA	3	8"	FL 8"	NO	S	89	W/DW	GRD	W/OR	ED	S
E	S	S	61	GA	3	8"	FL 8"	SEE BELOW	S	68	I	IS-1	W/OR	ICC	S
F	L	S	67	GA	3	8"	FL 12"	SEE BELOW	S						
G	S	S	22	GA	3	8"	FL 8"	NO	S						
			81	GA	3	8"	FL 8"	NO	S						
			65	EC	3	8"	FL 8"	NO	T						
			23	GA	4	8" R.Y.G 12" G →	FL 8" CAP 8"	NO	S						
			42	GA	3	8"	FL 8"	NO	T						
			21	GA	4	8" R.Y.G 12" G →	FL 8" CAP 8"	NO	T						

CONTROLLER CABINET SIZE : LARGE BASE CABINET : —

COMMENTS :

SIG. 61 - LOUVERS ON GREEN SECTION

SIG. 67 - LOUVERS ON RED SECTION