


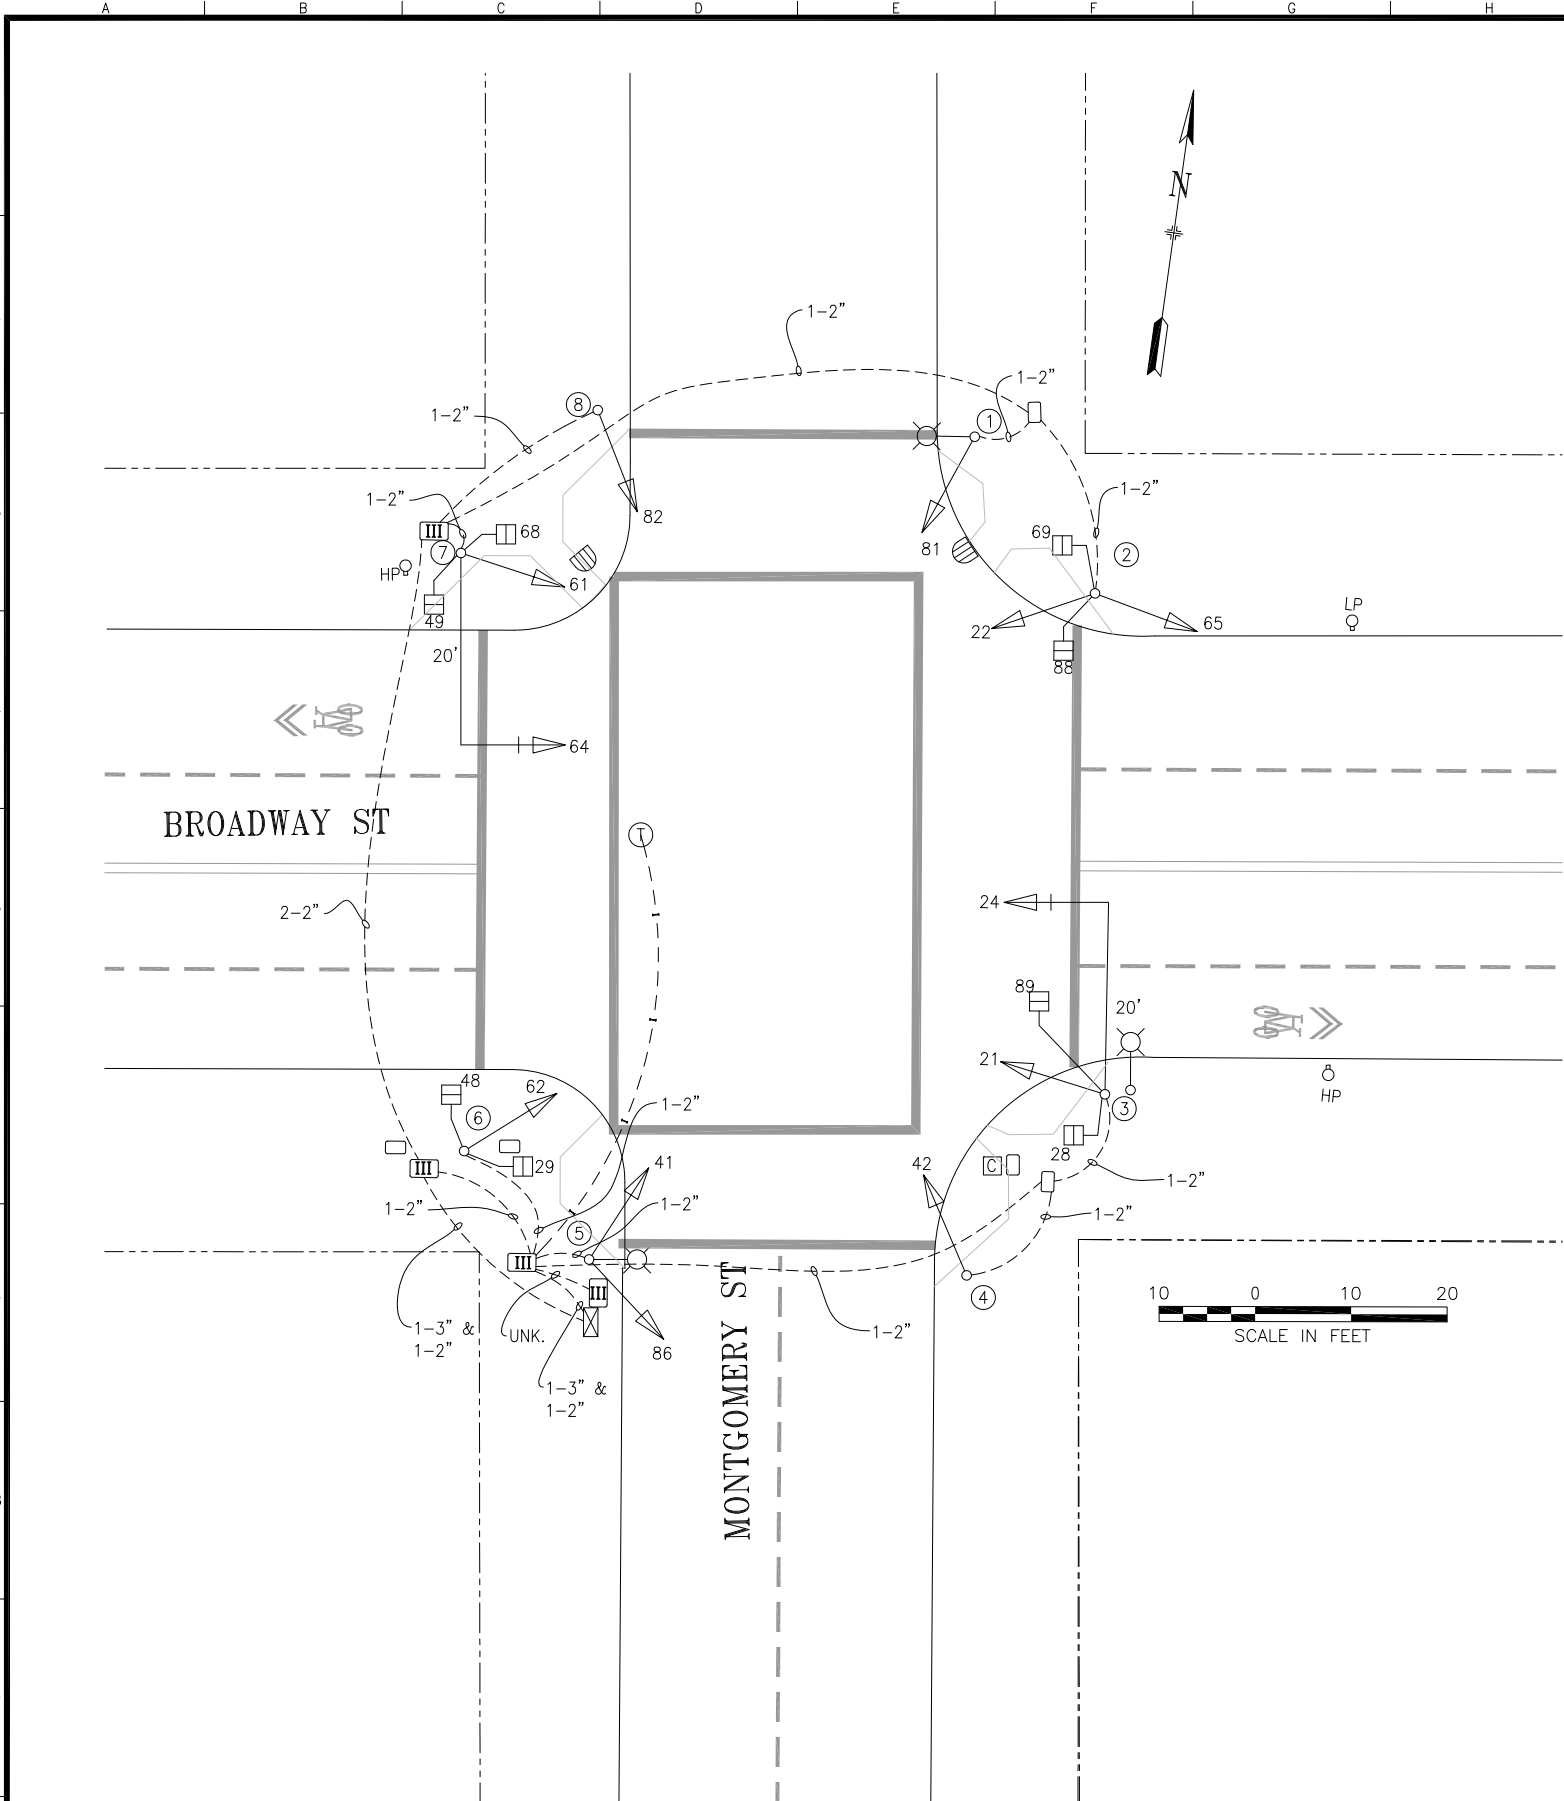

POLE AND EQUIPMENT SCHEDULE											
POLE No.	TYPE OF POLE	LUMINAIRE VOLTAGE/WATTAGE	VEHICLE SIGNAL					PEDESTRIAN SIGNAL			REMARKS
			No.	TYPE	MOUNTING	VISORS	LOUVERS	No.	TYPE	MOUNTING	
①	CITY STANDARD STREET LIGHT		81	3S12"	SV-1-T	T					
②	1-A (10')		22 65	3S12" 3S12"	TV-2-T	T T		69 88	1S-COUNT 1S-COUNT	SP-1 SP-1	
③	16-2-100 WITH 20' MAST ARM		21 24	3S12" 3S12"	SV-1-T MAS	T T		28 89	1S-COUNT 1S-COUNT	SP-1 SP-1	BACKPLATE
④	1-A (10')		42	3S12"	TV-1-T	T					
⑤	CITY STANDARD STREET LIGHT		41 86	3S12" 3S12"	SV-2-TA	T T					
⑥	1-A (10')		62	3S12"	TV-1-T	T		29 48	1S-COUNT 1S-COUNT	SP-1 SP-1	1
⑦	16-2-100 WITH 20' MAST ARM		61 64	3S12" 3S12"	SV-1-T MAS	T T		49 68	1S-COUNT 1S-COUNT	SP-1 SP-1	1
⑧	1-A (10')		82	3S12"	TV-1-T	T					

1	07/16/2014	ACTIVATED THRU 210BJ; CONVERTED FROM AS-BUILTS	JH	MV	
NO.	DATE	DESCRIPTION	BY	APP.	
TABLE OF REVISIONS					
CHECK WITH TRACING TO SEE IF YOU HAVE LATEST REVISION					

REFERENCE INFORMATION & FILE NO. OF SURVEYS



SAN FRANCISCO MUNICIPAL TRANSPORTATION AGENCY
CITY AND COUNTY OF SAN FRANCISCO

DRAWN:	DATE:
JH	09/2015
CHECKED:	DATE:
MV	09/2015

SCALE:
AS SHOWN
SHEET OF SHEETS
1 OF 1

TRAFFIC SIGNAL INVENTORY DIAGRAM
BROADWAY ST AND MONTGOMERY ST

CNN NO.
24768000
REV NO.
0