



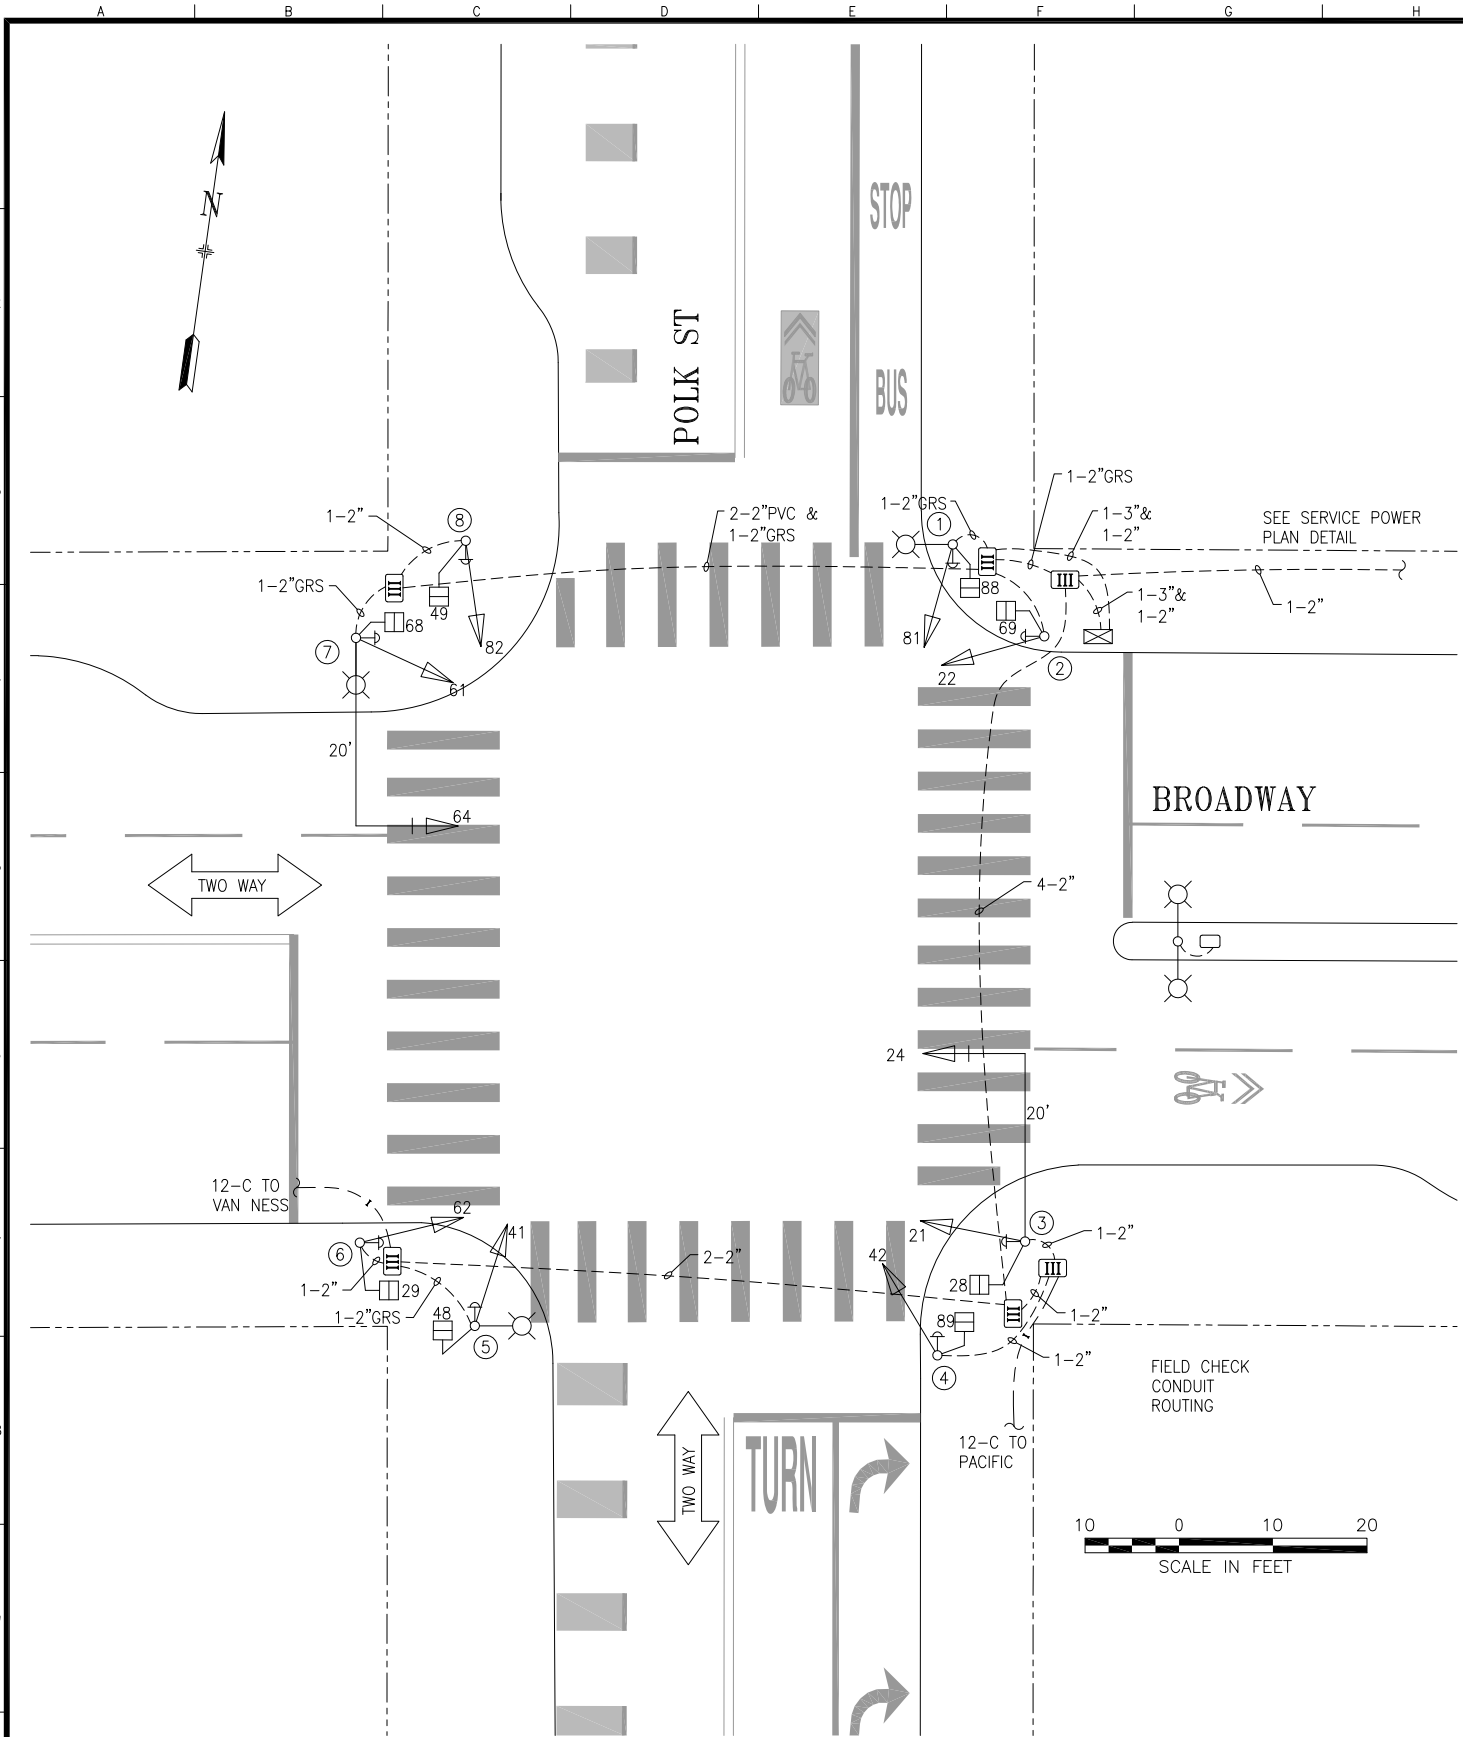

POLE AND EQUIPMENT SCHEDULE											
POLE No.	TYPE OF POLE	LUMINAIRE VOLTAGE/WATTAGE	VEHICLE SIGNAL					PEDESTRIAN SIGNAL			REMARKS
			No.	TYPE	MOUNTING	VISORS	LOUVERS	No.	TYPE	MOUNTING	
①	ORNAMENTAL STREET LIGHT		81	3S12"	SV-1 (16")	T		88	1S-COUNT	SP-1	MOUNT 81 ON E SIDE OF POLE APS-2W
②	1-A (10')		22	3S12"	TV-1-T	T		69	1S-COUNT	SP-1	APS-2W
③	16-2-100 W/ 20' MAST ARM		21	3S12"	SV-1-T	T		28	1S-COUNT	SP-1	APS-2W BACKPLATE
			24	3S12"	MAS	T					
④	1-A (10')		42	3S12"	TV-1-T	T		89	1S-COUNT	SP-1	APS-2W
⑤	ORNAMENTAL STREET LIGHT		41	3S12"	SV-1 (16")	T		48	1S-COUNT	SP-1	MOUNT 41 ON W SIDE OF POLE APS-2W
⑥	1-A (10')		62	3S12"	TV-1-T	T		29	1S-COUNT	SP-1	APS-2W
⑦	17-2-100 W/ 20' MAST ARM AND 6' LUMINAIRE ARM		61	3S12"	SV-1-T	T		68	1S-COUNT	SP-1	APS-2W BACKPLATE
			64	3S12"	MAS	T					
⑧	1-A (10')		82	3S12"	TV-1-T	T		49	1S-COUNT	SP-1	APS-2W

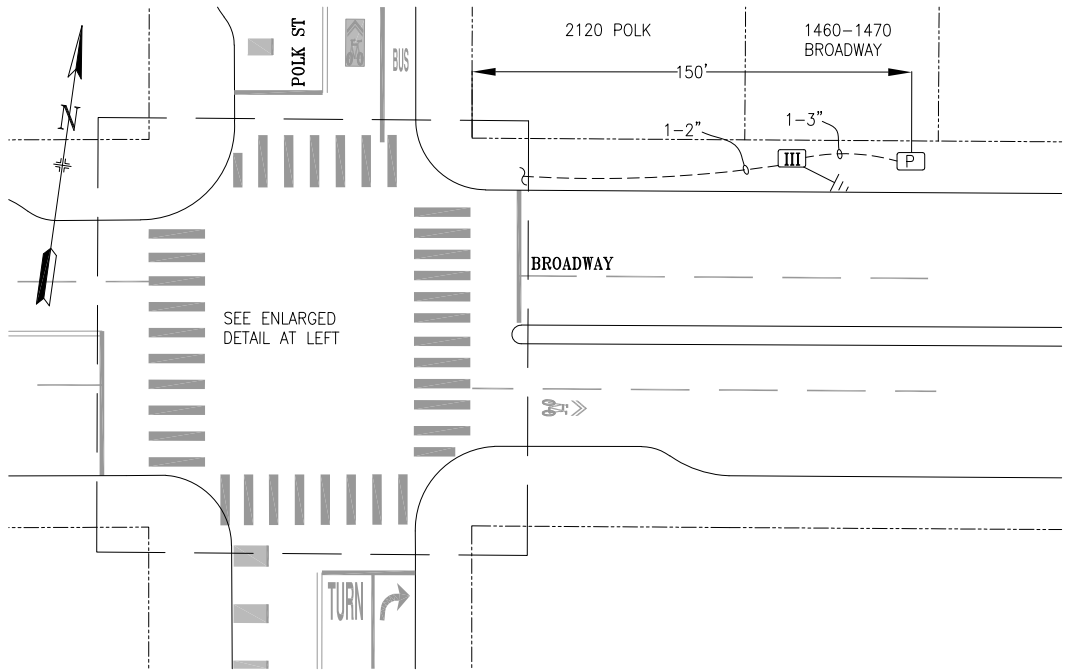

SERVICE CONNECTION PLAN DETAIL
NOT TO SCALE

TABLE OF REVISIONS			
NO.	DATE	DESCRIPTION	BY APP.
2	8/24/20	APS INSTALLED PER SRC 2019-186	JH GD
1	6/4/19	2126J PUNCH LIST INSPECTION-REPLACED POLES 1 & 5	JH GD
0	7/26/17	FULL UPGRADE BY 2586J; CONVERTED FROM AS-BUILTS	JH GD

CHECK WITH TRACING TO SEE IF YOU HAVE LATEST REVISION

REFERENCE INFORMATION & FILE NO. OF SURVEYS



SAN FRANCISCO MUNICIPAL TRANSPORTATION AGENCY
CITY AND COUNTY OF SAN FRANCISCO

DRAWN:	DATE:
JH	4/2018
CHECKED:	DATE:
GD	4/2018

SCALE:
AS SHOWN
SHEET OF SHEETS
01 OF 01

TRAFFIC SIGNAL INVENTORY DIAGRAM
BROADWAY AND POLK STREET

CNN NO.
25315000
REV NO.
2