


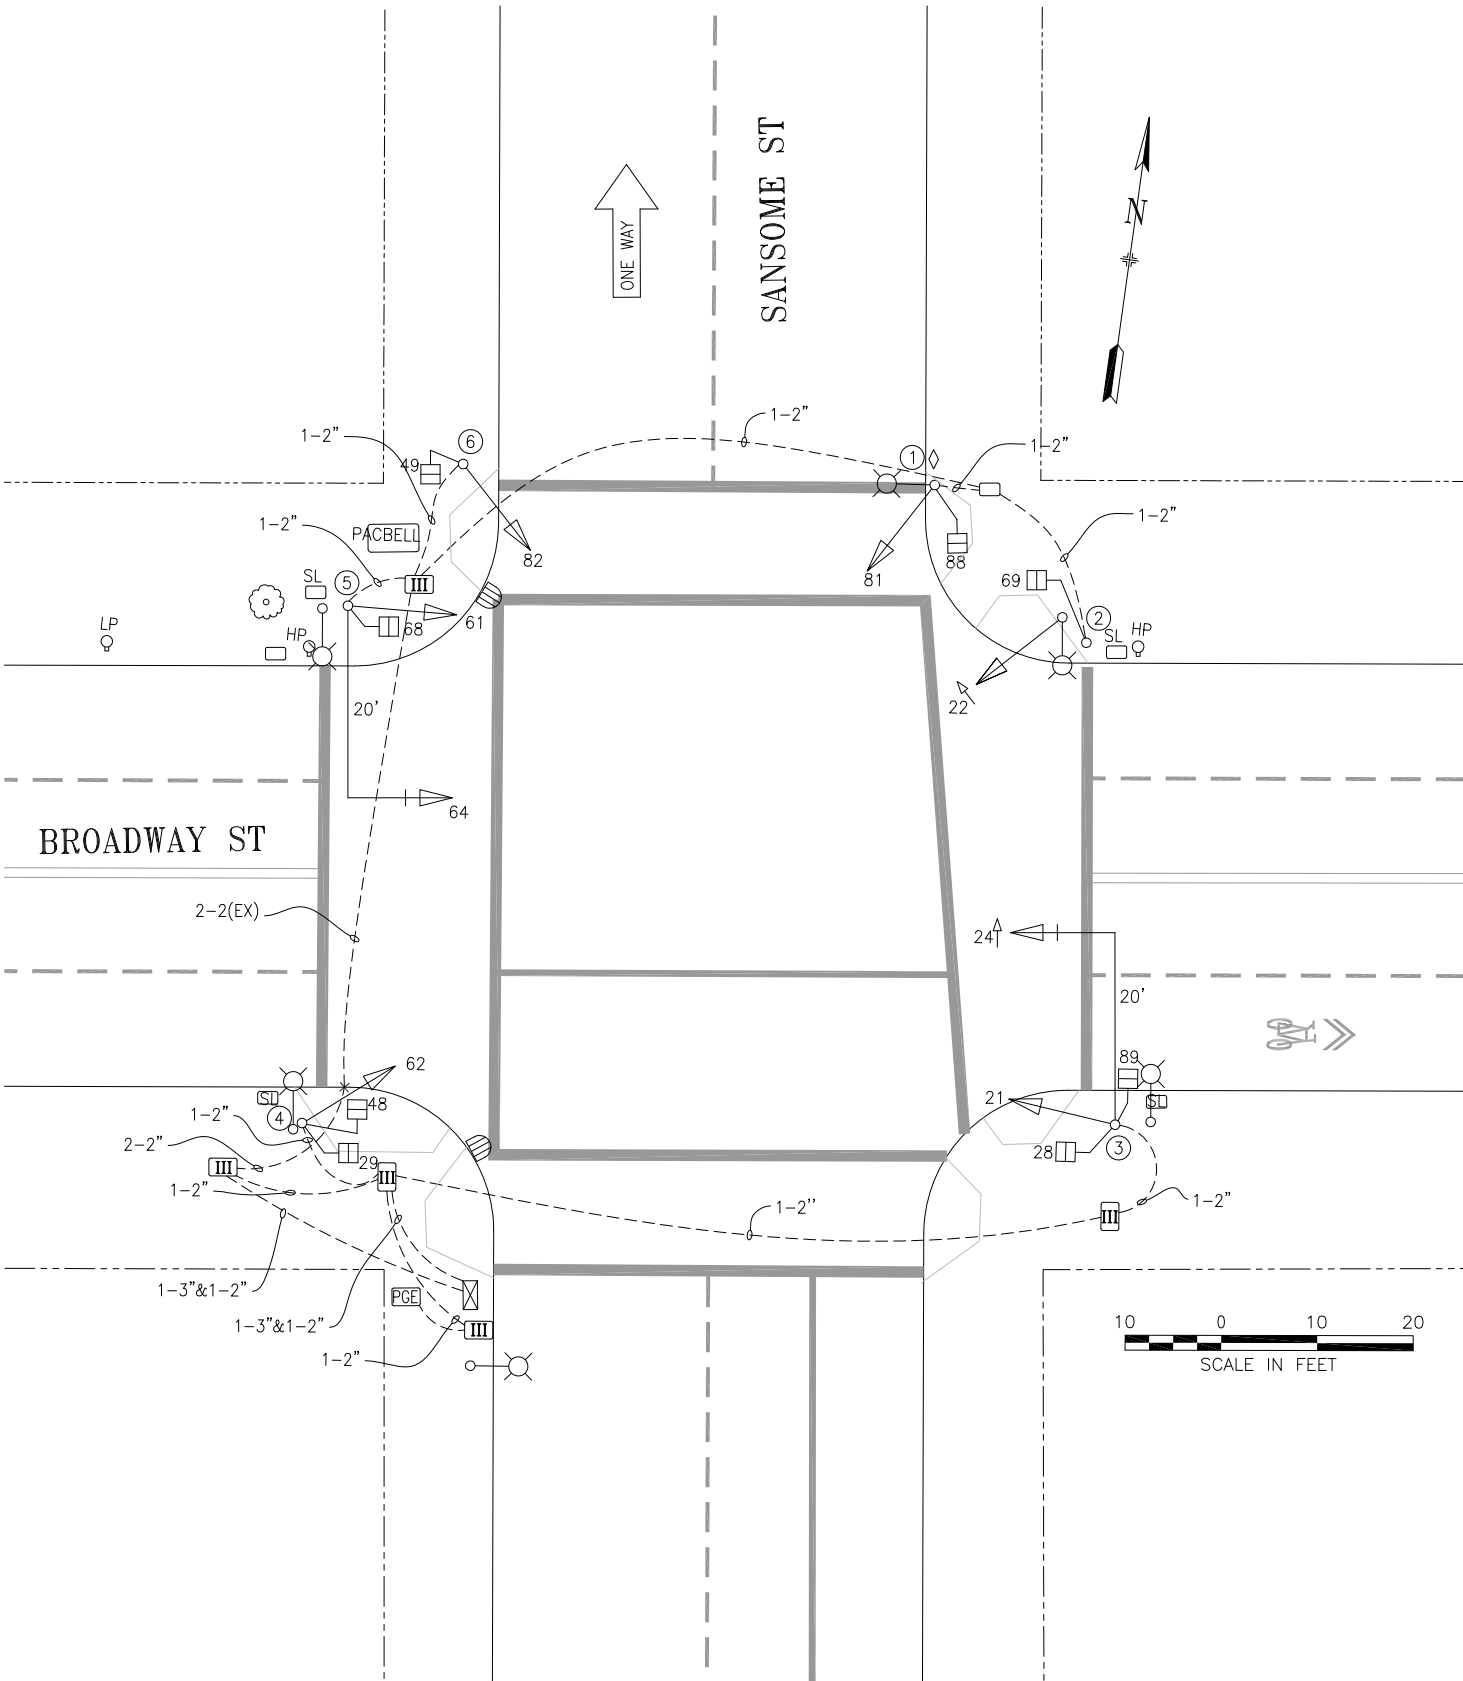

POLE AND EQUIPMENT SCHEDULE											
POLE No.	TYPE OF POLE	LUMINAIRE VOLTAGE/ WATTAGE	VEHICLE SIGNAL					PEDESTRIAN SIGNAL			REMARKS
			No.	TYPE	MOUNTING	VISORS	LOUVERS	No.	TYPE	MOUNTING	
①	EX CITY STANDARD STREET LIGHT		81	3S12"	SV-1-T	T		88	1S-COUNT	SP-1	
②	1-A (10')		22	4S12"G/LA	TV-1-T	T		69	1S-COUNT	SP-1	
③	16-2-100 WITH 20' MAST ARM		21 24	3S12" 4S12"G/LA	SV-1-T MAS	T T		28 89	1S-COUNT 1S-COUNT	SP-1 (22") SP-1-SF (12")	BACKPLATE MOUNT SIGNAL 21 ON NORTH SIDE OF POLE
④	1-A (10')		62	3S12"	SV-1-T	T		29 48	1S-COUNT 1S-COUNT	SP-1 (22") SP-1-SF (12")	
⑤	16-2-100 WITH 20' MAST ARM		61 64	3S12" 3S12"	SV-1-T (24") MAS	T T		68	1S-COUNT	SP-1	MOUNT SIGNAL 61 ON WEST SIDE OF POLE BACKPLATE
⑥	1-A (10')		82	3S12"	TV-1-T	T		49	1S-COUNT	SP-1	MOUNT SIGNAL 82 ON EAST SIDE OF POLE

1	7/18/16	INSTALLED 4-SECTION SIGNALS HEADS @ 22 & 24 FOR LAGGING PROTECTED EBRT PHASE	IRT	MV	
0	8/7/14	UPGRADE ACTIVATED THRU 2108J; CONVERTED FROM CONTRACT PLANS	JH	MV	
NO.	DATE	DESCRIPTION	BY	APP.	
TABLE OF REVISIONS					
CHECK WITH TRACING TO SEE IF YOU HAVE LATEST REVISION					

REFERENCE INFORMATION & FILE NO. OF SURVEYS



SAN FRANCISCO MUNICIPAL TRANSPORTATION AGENCY
CITY AND COUNTY OF SAN FRANCISCO

DRAWN:	DATE:
JH	09/2015
CHECKED:	DATE:
MV	09/2015

SCALE:
AS SHOWN
SHEET OF SHEETS
1 OF 1

TRAFFIC SIGNAL INVENTORY DIAGRAM
BROADWAY ST AND SANSOME ST

CNN NO.
30039000
REV NO.
1