


FULTON & BRODERICK

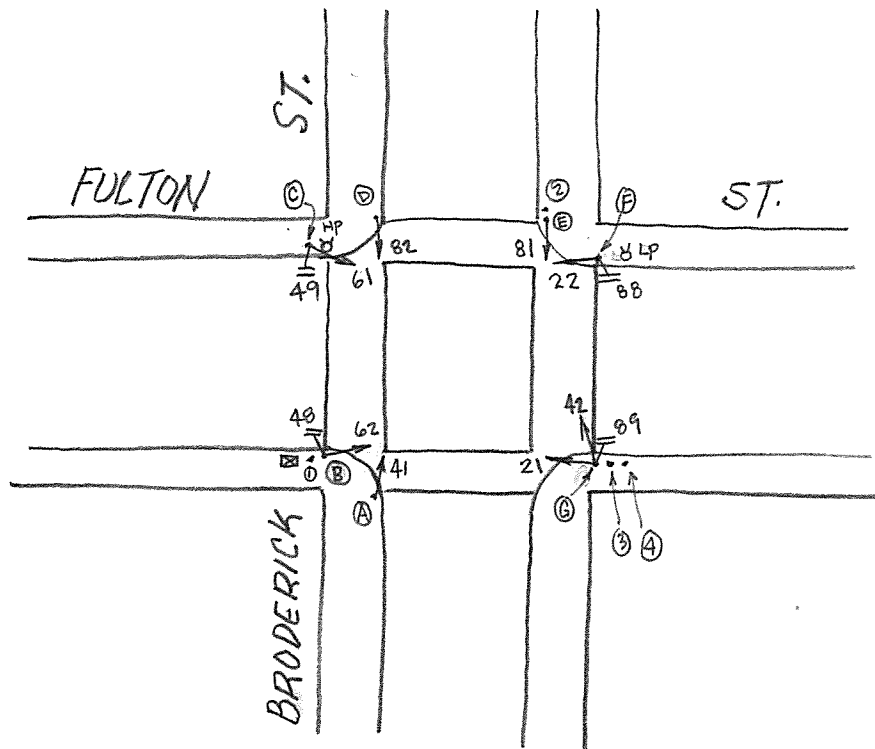

AS OF 5-15-17

ROLE	FUNC.	MAT'L	SIGNAL NO.	MAKE	NO. OF SECT.	SIZE	VISOR	B.P. OR LOUVERS	MOUN'T	PED SIGNAL NO.	LEGEND	MESSAGE		MAKE	MOUN'T
												ELEMENT	COLOR		
A	L	C	41	EC	3	12"	T	No	S	48	I	15-I	W/OR	ICC	S
B	S	C	62	EC	3	12"	T	No	T	49	I	15-I	W/OR	ICC	S
C	L	C	61	EC	3	12"	T	No	S	88	I	15-I	W/OR	ICC	S
D	S	C	82	EC	3	12"	T	No	T	89	I	15-I	W/OR	ICC	S
E	S	C	81	EC	3	12"	T	No	T						
F	S	C	22	EC	3	12"	T	No	T						
G	S	C	42	EC	3	12"	T	No	TV-2-T-SFA						
			21	EC	3	12"	T	No	TV-2-T-SFA						
1	V	W													
2	V	W													
3	V	W													
4	L	C													

CONTROLLER CABINET SIZE : ORDINARY BASE CABINET : YES

COMMENTS : UPGRADED ALL VEHICLE SIGNALS TO 12", per SRC 2016-334 JOK