


DIST	COUNTY	ROUTE	KILOMETER POST TOTAL PROJECT	SHEET No	TOTAL SHEETS
04	SF	101	10.8/12.9	47	61

REGISTERED ELECTRICAL ENGINEER _____

8-9-04

PLANS APPROVAL DATE _____






The State of California or its officers or agents shall not be responsible for the accuracy or completeness of electronic copies of this plan sheet.

Caltrans now has a web site! To get to the web site, go to: <http://www.dot.ca.gov>

Resident Engineer Responsible
for ***Construction Changes***

CONTRACT No. 04-171204
DATE ACCEPTED 12/20/06
AS BUILT
RESIDENT ENGINEER F Duan
12/12/07
SIGNATURE DATE
CHECKED BY R.L. DATE 04/08

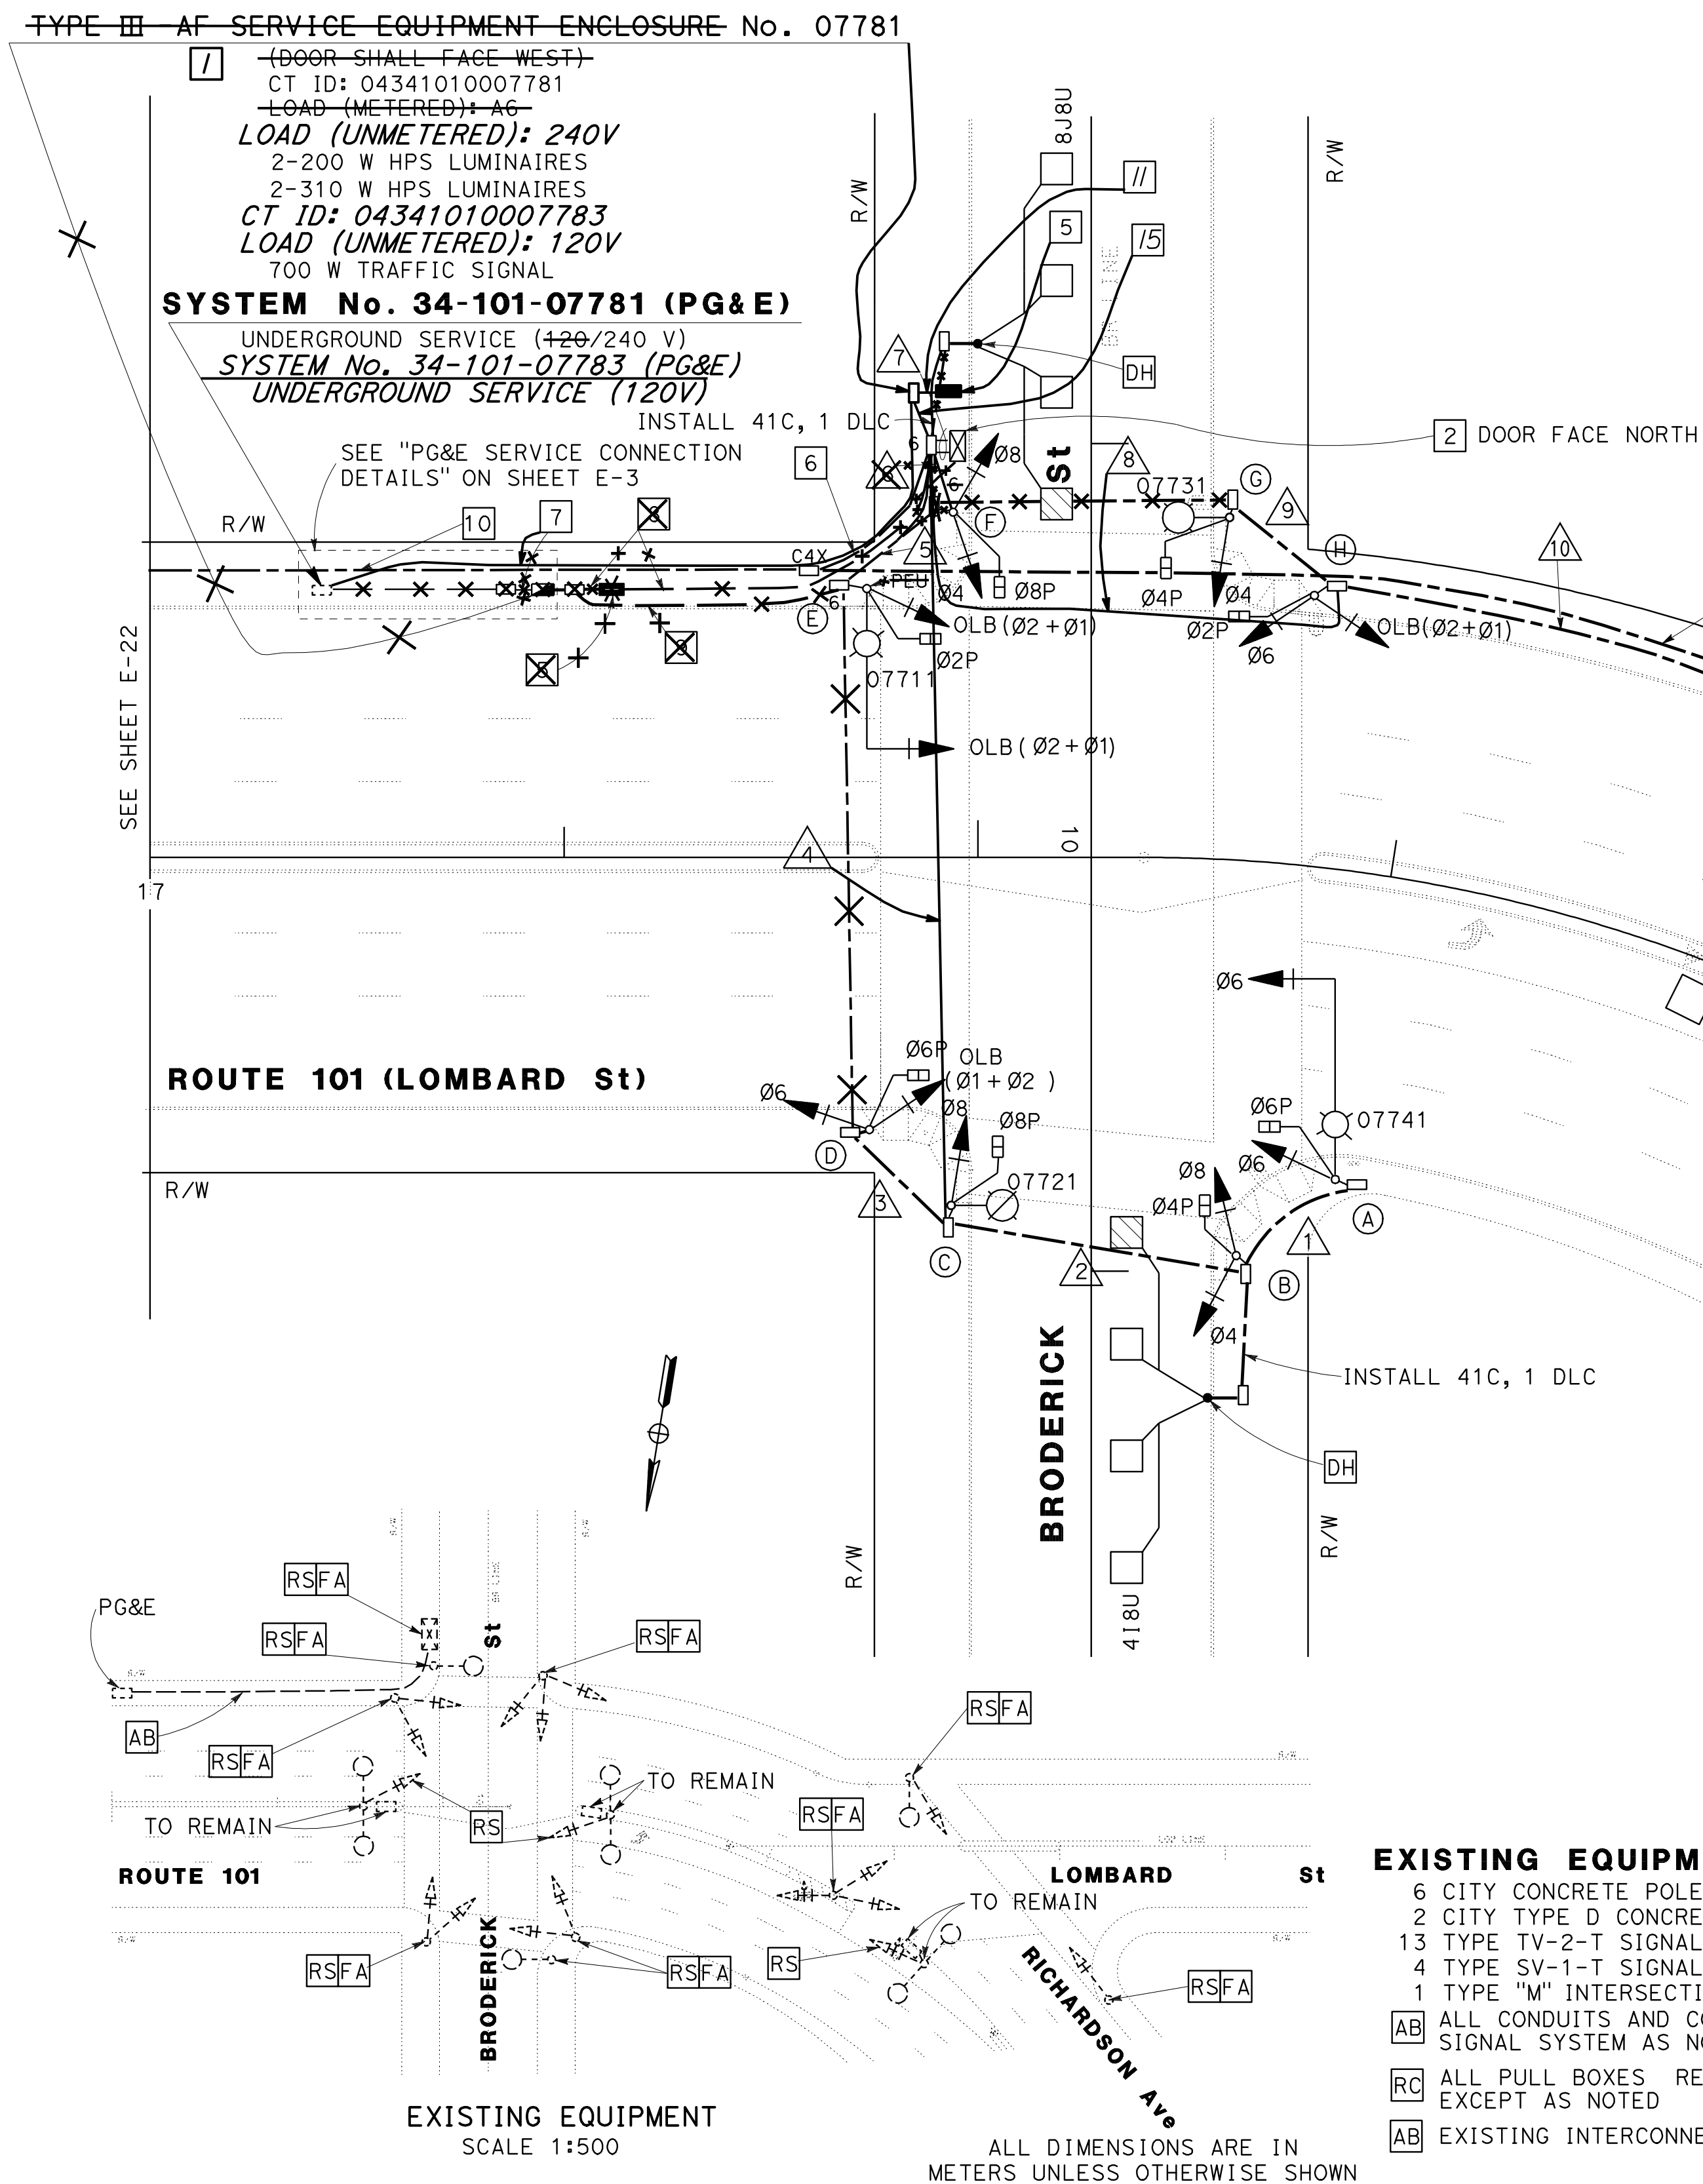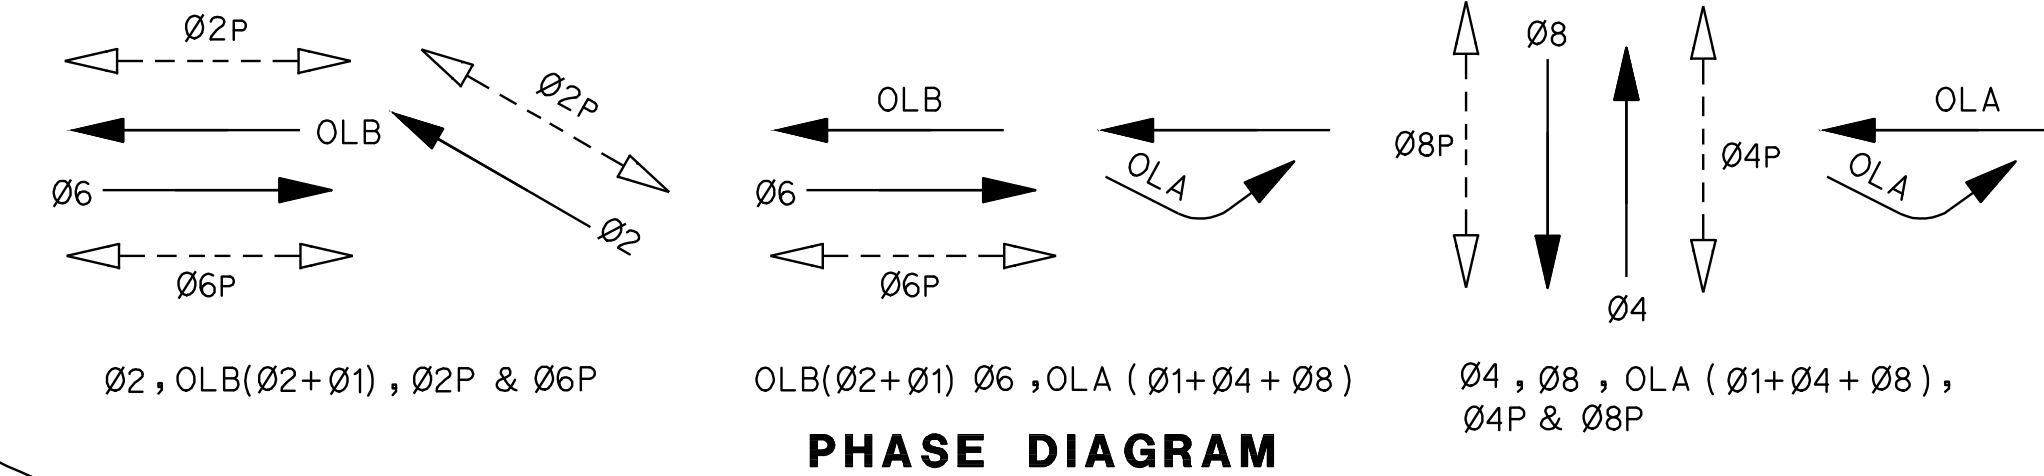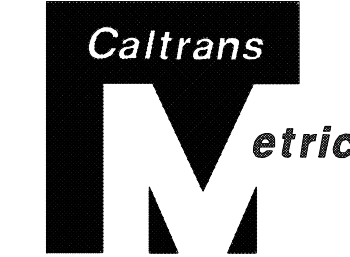

EXISTING EQUIPMENT TO BE REMOVED AND SALVAGED

- 6 CITY CONCRETE POLE (SIMILAR TYPE 1-A)
2 CITY TYPE D CONCRETE STREET LIGHT STANDARD AND LUMINAIRE
13 TYPE TV-2 T SIGNAL HEAD MOUNTING
4 TYPE SV-1-T SIGNAL HEAD MOUNTING
1 TYPE "M" INTERSECTION CONTROLLER ASSEMBLY
- AB** ALL CONDUITS AND CONDUCTORS RELATED TO EXISTING EXCEPT TRAFFIC
SIGNAL SYSTEM AS NOTED
- RC** ALL PULL BOXES RELATED TO EXISTING TRAFFIC SIGNAL SYSTEM
EXCEPT AS NOTED
- AB** EXISTING INTERCONNECTION CABLE (sic)

MODIFY SIGNAL AND LIGHTING LOCATION 12 ROUTE 101 (LOMBARD St)/BRODERICK St SCALE 1:200

- 2-78

FOR REDUCED PLANS ORIGINAL
SCALE IS IN MILLIMETERS




EA 171201

E - 25

DATE PLOTTED => 03-FEB-2009	LAST REVISION
TIME PLOTTED => 10:51	03-18-04

DATE PLOTTED => 03-FE-2011
TIME PLOTTED => 10:51

04/08

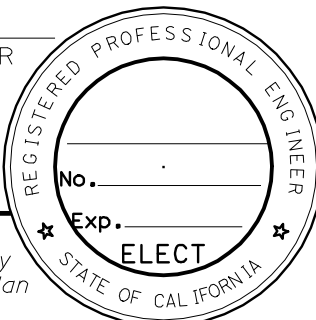


DIST	COUNTY	ROUTE	KILOMETER POST TOTAL PROJECT	SHEET No	TOTAL SHEETS
04	SF	101	10.8/12.9	48	61

REGISTERED ELECTRICAL ENGINEER _____

8-9-04

PLANS APPROVAL DATE _____



The State of California or its officers or agents shall not be responsible for the accuracy or completeness of electronic copies of this plan sheet.

Caltrans now has a web site! To get to the web site, go to: <http://www.dot.ca.gov>

[illegible]

* OTHER REQUIREMENTS ARE COVERED BY NOTES, LEGEND, SPECIAL PROVISIONS, AND STANDARD SPECIFICATIONS.
FOR TYPE OF STANDARD, VEHICLE AND PEDESTRIAN SIGNAL MOUNTING, SEE STANDARD PLANS.