


37

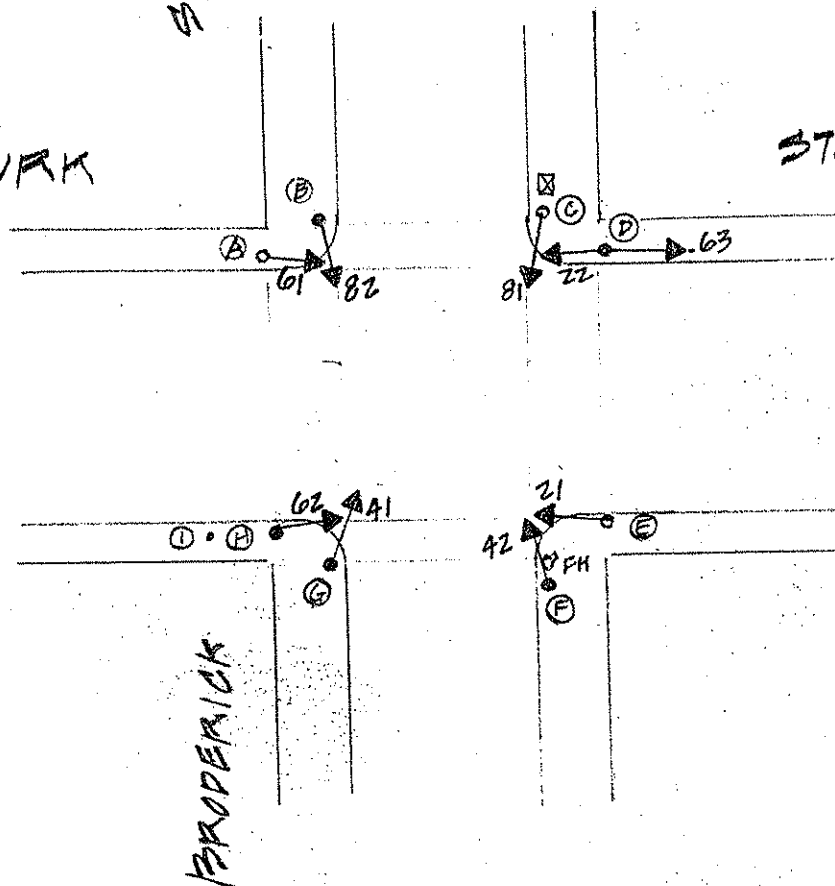

6-94

[illegible]

CONTROLLER CABINET SIZE : Ordinary BASE CABINET : yes

COMMENTS: Signals 61.62 at 13 ft. Height

NEW MUNI POLES A, C AND NEW SIGNALS 61, 81, 21 WERE INSTALLED
UNDER CONTRACT MR 881 #31 BALBOA LINE