


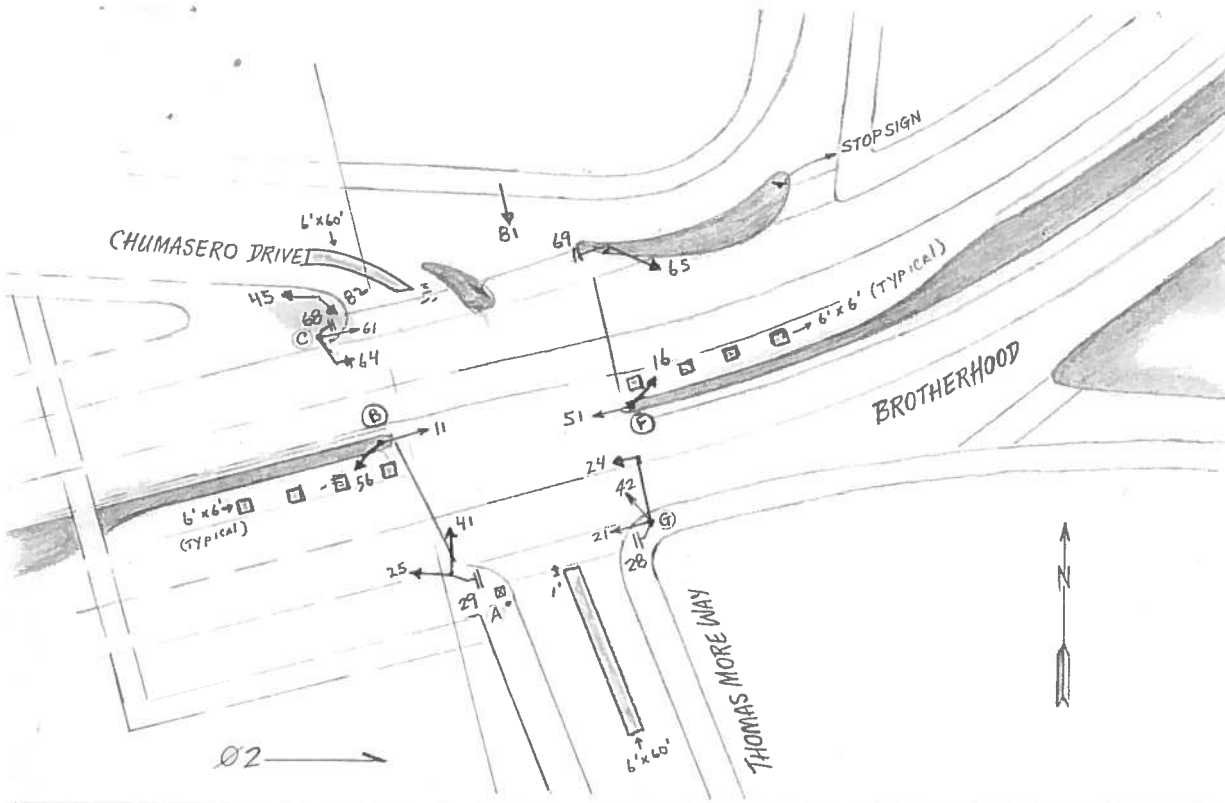

4-10-14

POLE	FUNC.	MAT'L	SIGNAL NO.	MAKE	NO. OF SECT.	SIZE	VISOR	B.P. OR LOUVERS	MOUNT	PED SIGNAL NO.	LEGEND	MESSAGE ELEMENT	COLOR	MAKE	MOUNT
A	L	S	62	EC	3	8"	FC 8"	LOUVERS	T	28	I	15-Count			SP-1
B	S	S	41	EC	3	12"	FC 8"	NO	T	29	I	15-Count			SP-1
C	L	S	25	EC	3	12"	FC 12"	NO	T	68	I	15-Count			SP-1
D	S	S	56	EC	3	12"	FC 12"	NO	S	69	I	15-Count			SP-1
E	S	S	11	EC	3	12"	FC 12"	NO	T						
F	L	S	64	EC	3	12"	FC 12"	BP	A						
G	S	S	61	EC	3	12"	FC 12"	NO	S						
H	S	S	82	EC	3	8"	FC 8"	NO	T						
J	S	S	45	EC	3	8"	FC 8"	NO	T						
			81	EC	3	12"	FC 12"	NO	T						
			65	EC	3	12"	FC 12"	NO	T						
			16	EC	3	12"	FC 12"	NO	S						
			51	EC	3	12"	FC 12"	NO	S						
			24	EC	3	12"	FC 12"	BP	A						
			42	EC	3	8"	FC 8"	NO	S						
			21	EC	3	12"	FC 12"	NO	S						

CONTROLLER CABINET SIZE : LARGE BASE CABINET: _____

COMMENTS: REMOVED 22 AND 62
CHANGED 41 TO 12"