


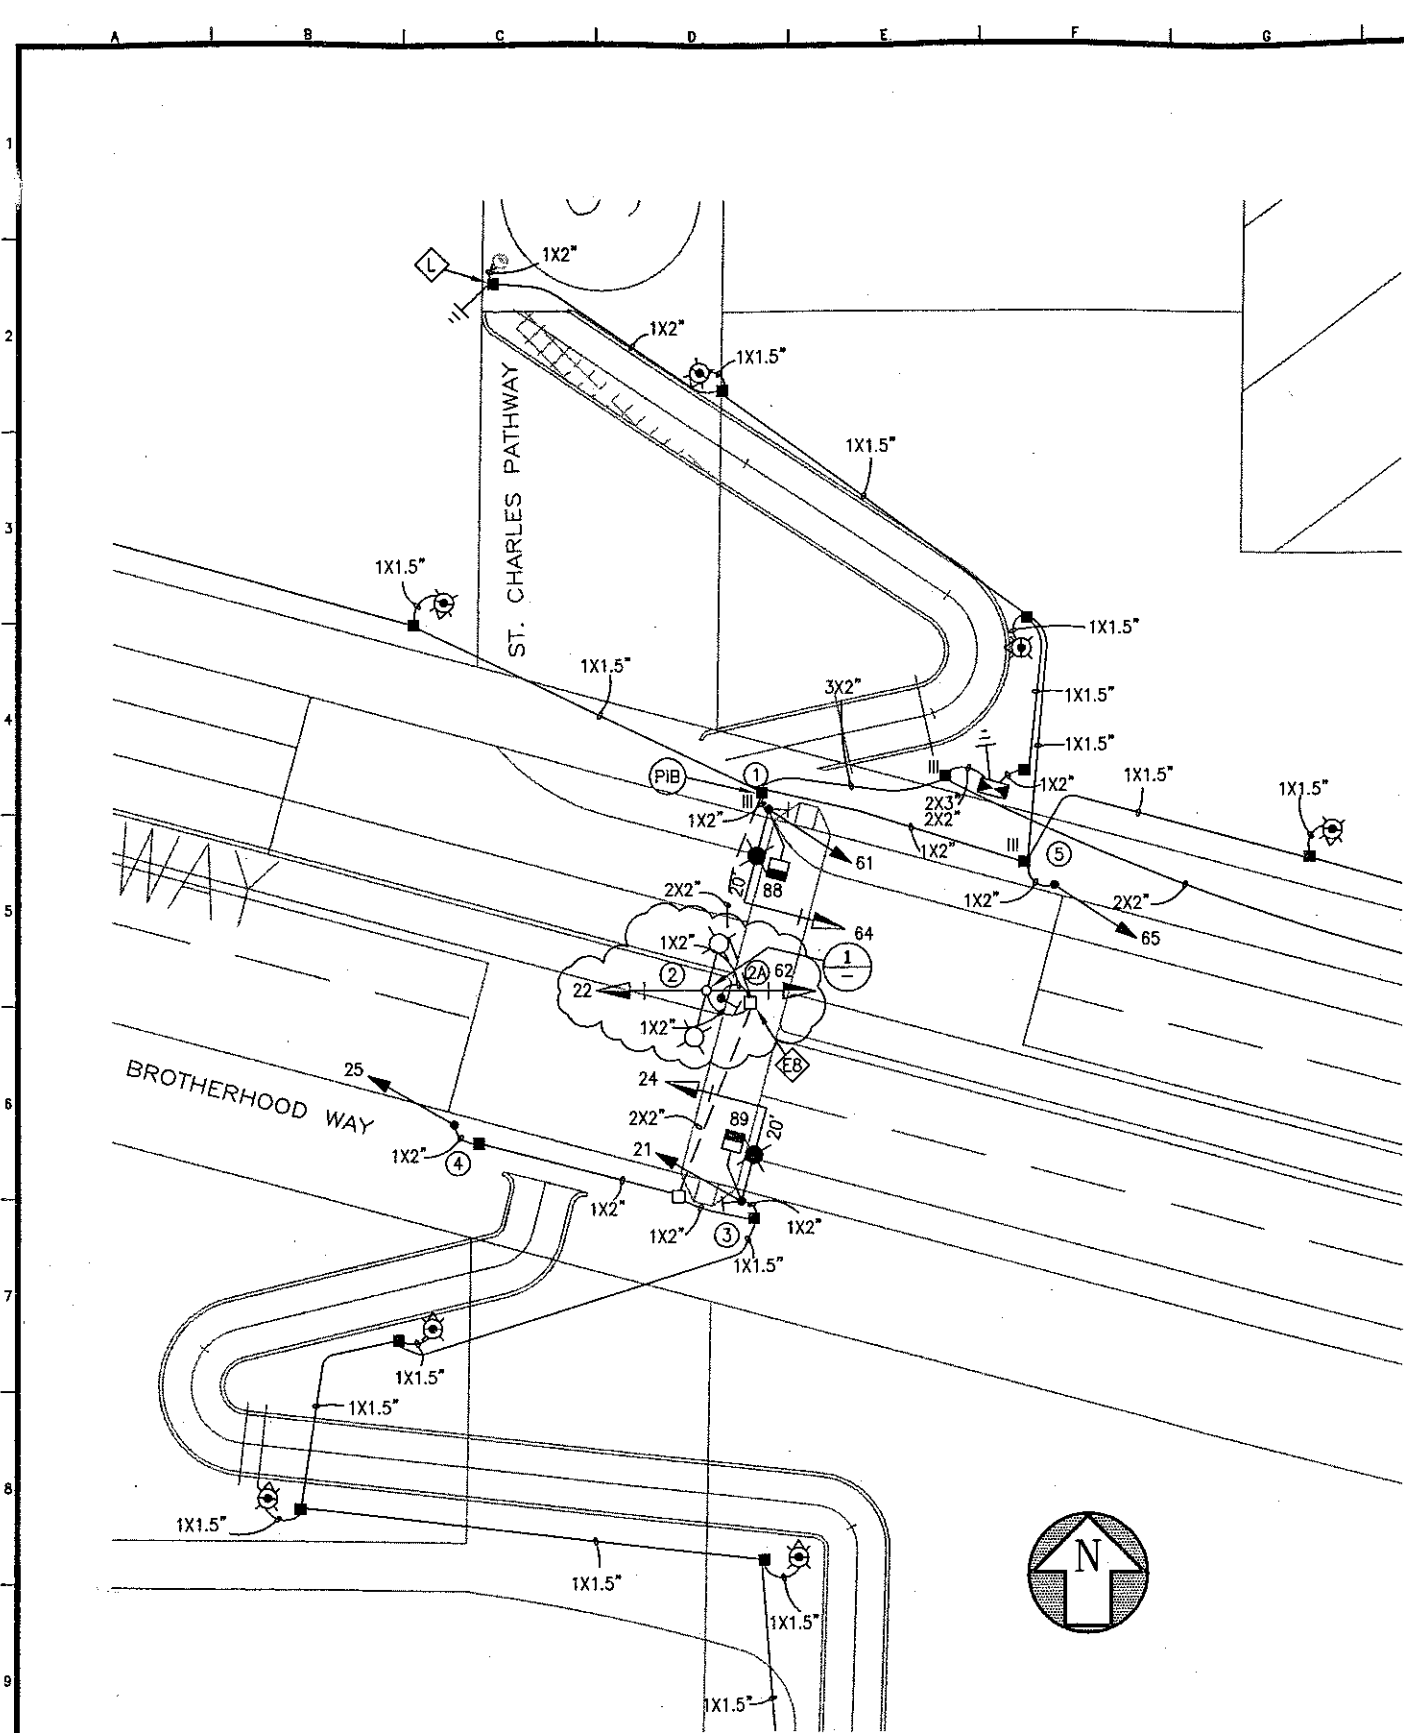

POLE AND EQUIPMENT SCHEDULE									
POLE No.	TYPE OF POLE	LUMINAIRE (HPS) VOLTAGE/ WATTS	VEHICLE SIGNAL			PEDESTRIAN SIGNAL			REMARKS
			No.	TYPE	MOUNTING (F/I)	No.	TYPE	MOUNTING (F/I)	
①	17-1-70 WITH 20' MAST ARM, 6' LUMINAIRE ARM AND HPS LUMINAIRE	120/100	61	3S8"	SV-1-T	88	1S-COUNT	SP-1	
			64	3S12"	MAS				
②	EX STREET LIGHT		22	3S12"	SV-2-T				
			62	3S12"					
③	17-1-70 WITH 20' MAST ARM, 6' LUMINAIRE ARM AND HPS LUMINAIRE	120/100	21	3S8"	SV-1-T	89	1S-COUNT	SP-1	
			24	3S12"	MAS				
④	TYPE 1-A (10')		25	3S8"	TV-1-T				
⑤	TYPE 1-A (10')		65	3S8"	TV-1-T				
②A	PPB POST								

Flash 10/2/02
3-Color 10/4/02

NO. DATE DESCRIPTION 3/02 PCO#1 BC CH BY APP.		REFERENCE INFORMATION & FILE NO. OF SURVEYS				BUREAU OF ENGINEERING DEPARTMENT OF PUBLIC WORKS CITY AND COUNTY OF SAN FRANCISCO				DESIGNED: DATE: 1/3/2003 SC: 1/3/2003 DRAWN: DATE: 1/3/2003 SC: 1/3/2003 CHECKED: DATE: 1/3/2003 SC: 1/3/2003		APPROVED: DATE: _____ SECTION MANAGER: DATE: _____ DIVISION MANAGER: DATE: _____ CITY ENGINEER: DATE: _____		SCALE: 1"=20'-0" SHEET OF SHEETS		TRAFFIC SIGNAL INVENTORY DIAGRAM ST. CHARLES PATHWAY AND BROTHERHOOD WAY		SPECIFICATION NO. 0222J DRAWING NO. E-1.0 FILE NO. _____ REV. NO. 0	
--	--	--	--	--	--	--	--	--	--	--	--	--	--	-------------------------------------	--	---	--	--	--

CHECK WITH TRACING TO SEE IF YOU HAVE LATEST REVISION

EXTERNAL REFERENCES: TBS4422, EBASE1, 0222J-2
 FONTS USED: ROMANS, ROMANT
 SCALE FACTOR: 1"=1'
 PLOT SCALE: 1"=1'
 ORIGIN: ELECTRICAL
 FILE NAME: 0222J01
 DATE: 2/14/01