



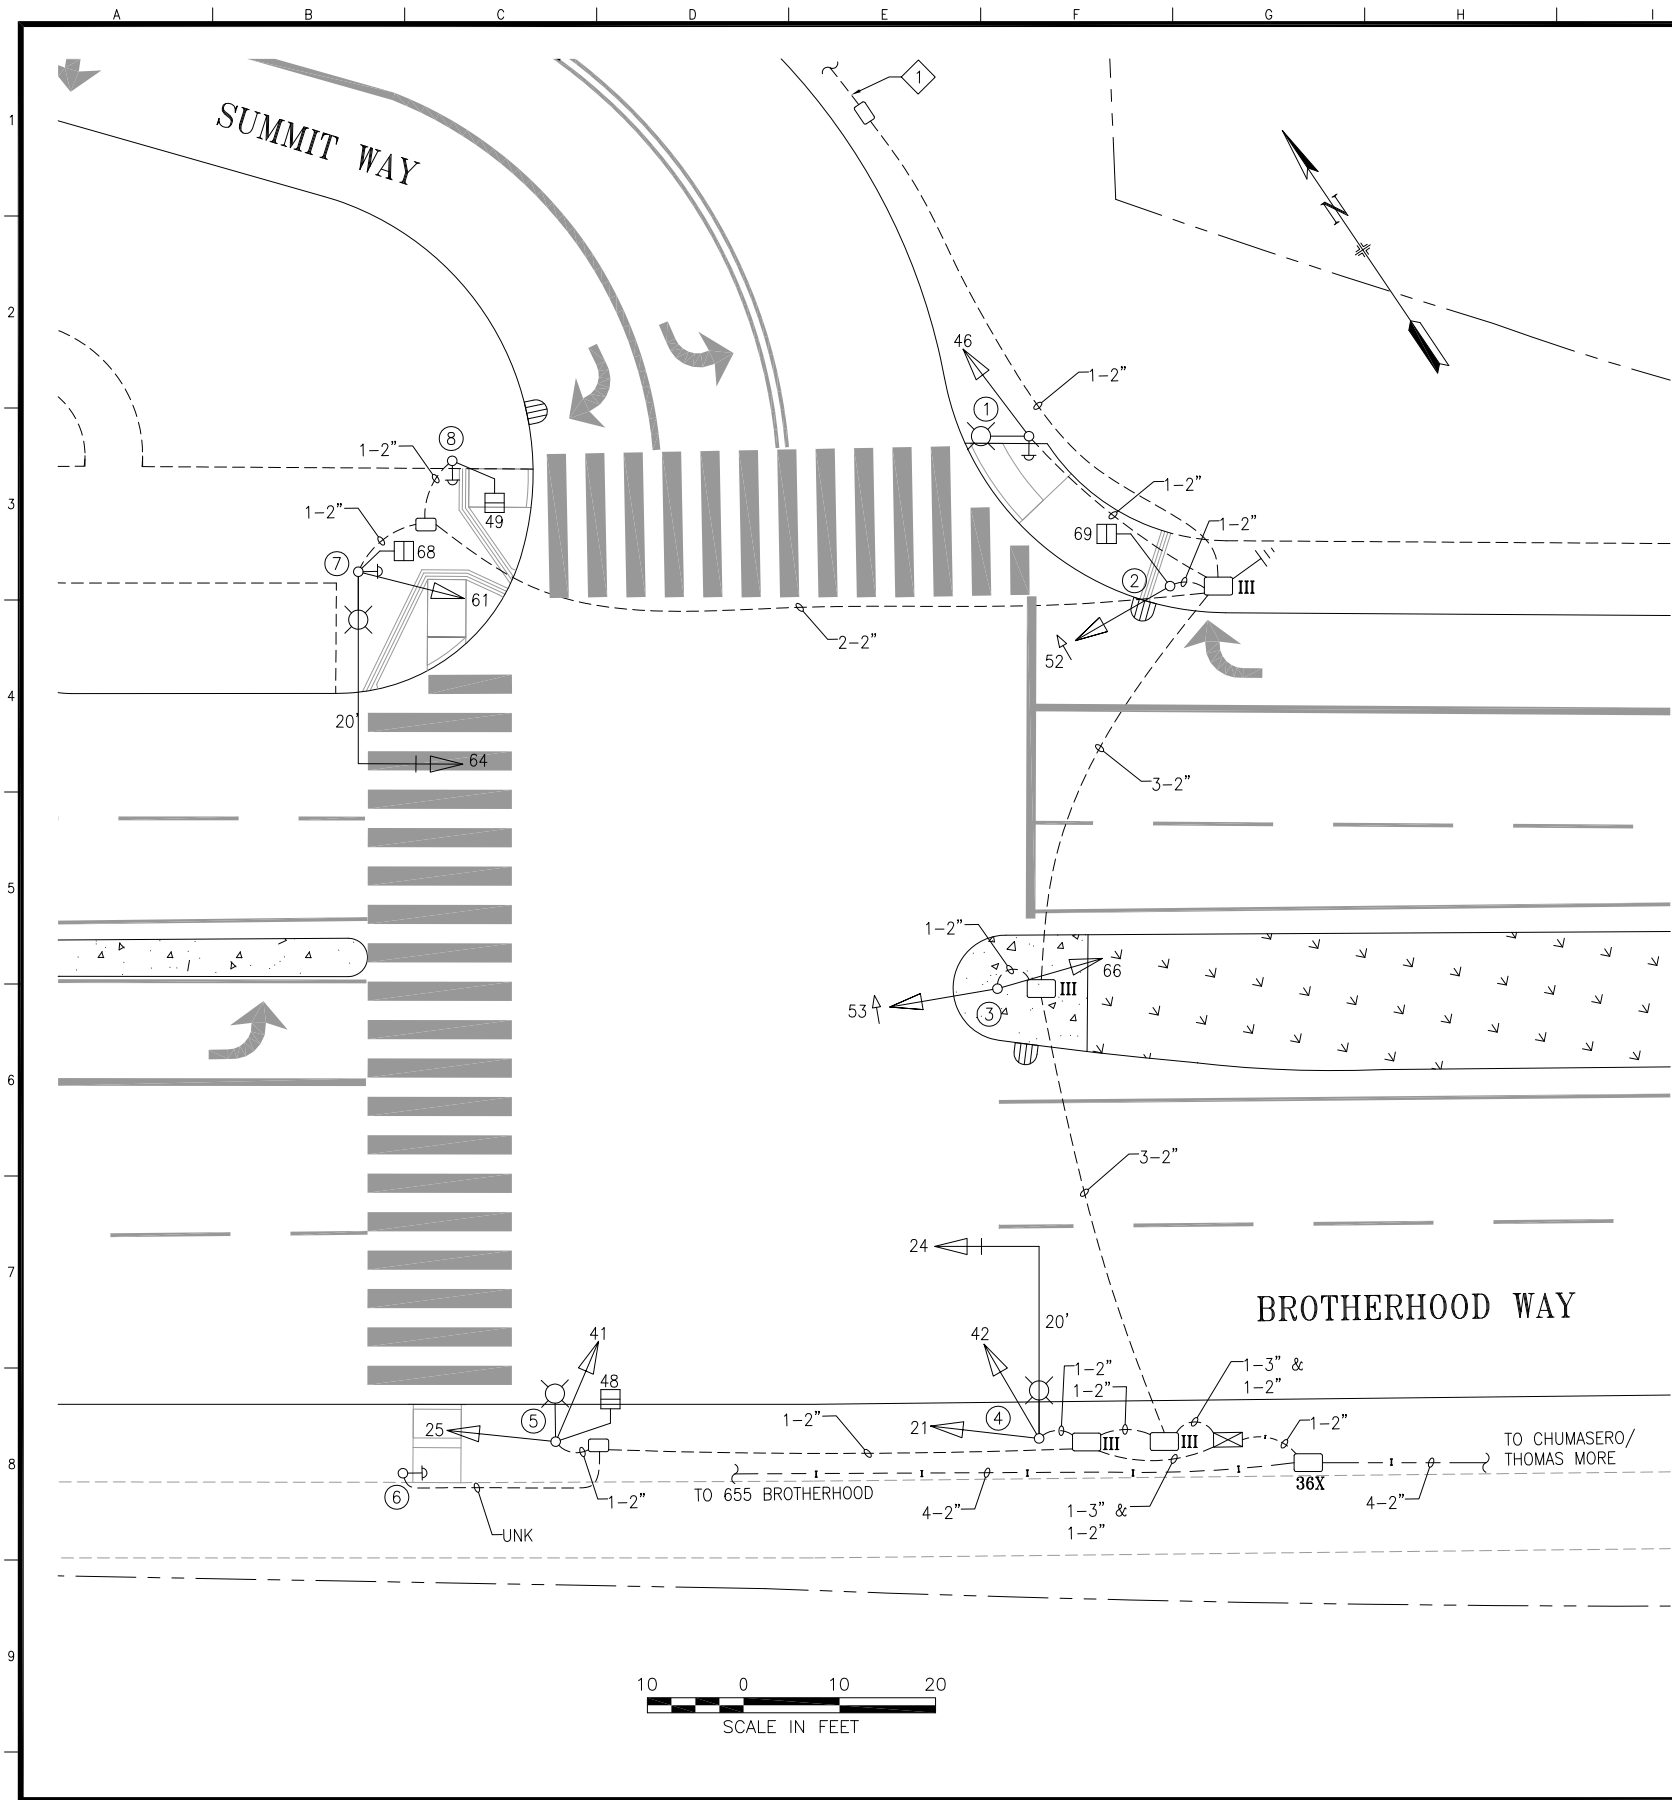

POLE AND EQUIPMENT SCHEDULE											
POLE No.	TYPE OF POLE	LUMINAIRE VOLTAGE/ WATTAGE	VEHICLE SIGNAL					PEDESTRIAN SIGNAL			REMARKS
			No.	TYPE	MOUNTING	VISORS	LOUVERS	No.	TYPE	MOUNTING	
①	CITY STANDARD STREET LIGHT		46	3S12"	SV-1-T	T					APS
②	1-A (10')		52	3S12"LA	TV-1-T	T		69	1S-COUNT	SP-1	
③	1-A (10')		53 66	3S12"LA 3S12"	TV-2-T	T T					
④	17-2-100 WITH 20' MAST ARM AND 6' LA		21 42 24	3S12" 3S12" 3S12"	SV-2-TC MAS	T T T					BACKPLATE
⑤	CITY STANDARD STREET LIGHT		25 41	3S12" 3S12"	SV-2-TA	T T		48	1S-COUNT	SP-1	
⑥	PPB POLE										APS
⑦	17-2-100 WITH 20' MAST ARM AND 6' LA		61 64	3S12" 3S12"	SV-1-T MAS	T T		68	1S-COUNT	SP-1	APS BACKPLATE
⑧	1-A (7')							49	1S-COUNT	TP-1	APS

SHEET NOTES:

① IC AND STREETLIGHT SERVICE POINT WILL BE A PULL BOX LOCATED ALONG SUMMIT WAY AT THE SOUTH PROPERTY LINE OF THE DEVELOPMENT APPROXIMATELY 190 FEET NORTHWEST OF THIS PULL BOX. CONTRACTOR TO PROVIDE 3" CONDUIT FOR SERVICE WIRES. CONTRACTOR SHALL COORDINATE WITH PG&E FOR FINAL POWER SERVICE CONNECTION.

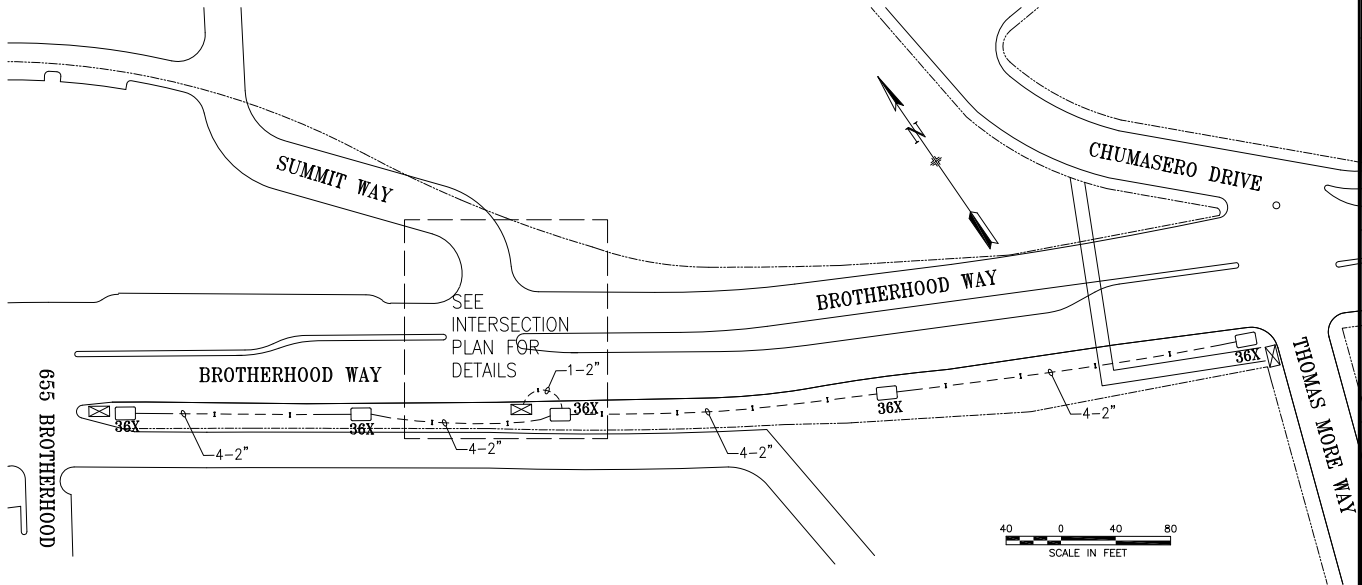

INTERCONNECT PLAN DETAIL
NOT TO SCALE

1
-

NO.	DATE	DESCRIPTION	BY	APP.
0	10/2/14	NEW SIGNAL ACTIVATED THROUGH 2256J	JH	GD
TABLE OF REVISIONS CHECK WITH TRACING TO SEE IF YOU HAVE LATEST REVISION				

REFERENCE INFORMATION
& FILE NO. OF SURVEYS



SAN FRANCISCO MUNICIPAL TRANSPORTATION AGENCY
CITY AND COUNTY OF SAN FRANCISCO

DRAWN:	DATE:
JH	1/2018
CHECKED:	DATE:
GD	1/2018

SCALE:

AS SHOWN

SHEET OF SHEETS

1 OF 1

TRAFFIC SIGNAL INVENTORY DIAGRAM

BROTHERHOOD WAY AND SUMMIT WAY

CNN NO.

3241201

REV NO.

0